


NELSON - DAILEY SURVEY

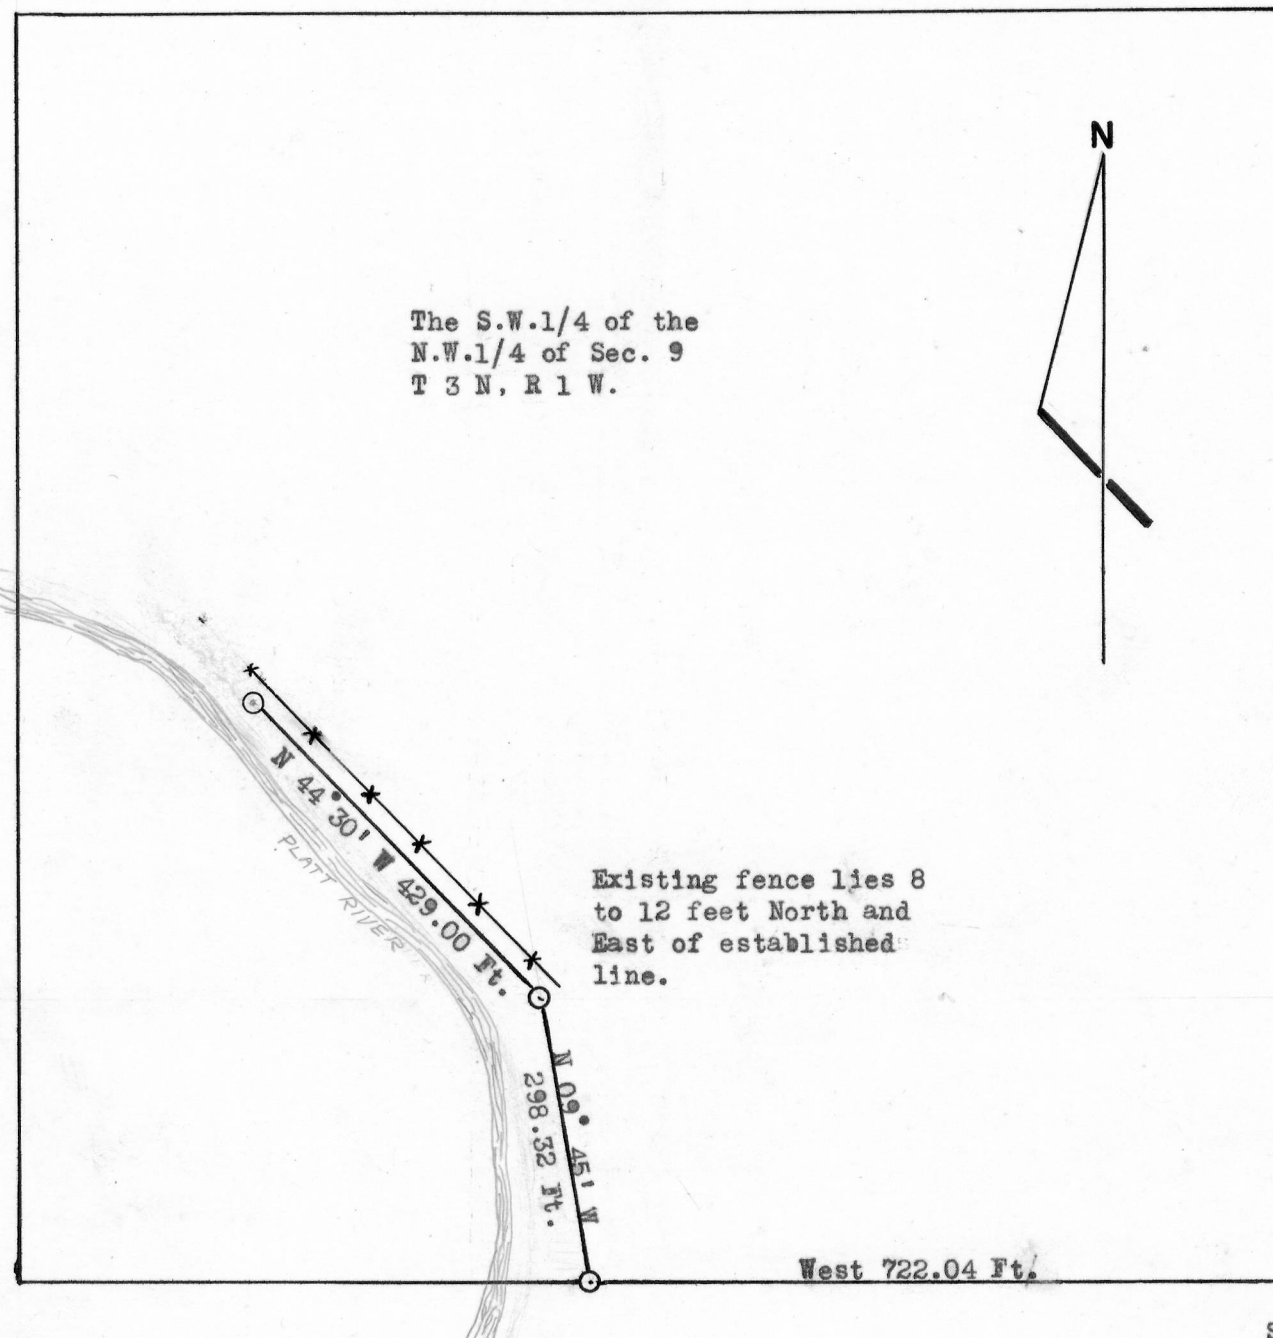

© 1" X 24" Iron pipe placed by this survey.

S.E. Corner of
S.W.1/4 of N.W.1/4
N.W.1/4 of
Sec. 9 - 3 - 1

DESCRIPTION OF LINE SURVEYED

A line in the S.W.1/4 of the N.W.1/4 of Section 9, T 3 N, R 1 W, of the 4th P.M. in Grant County, Wisconsin described as follows: Beginning at a point which is 722.04 feet West of the Southeast corner of said S.W.1/4 of N.W.1/4; thence North 09° 45' West 298.32 feet; thence North 44° 30' West 429.00 feet.

Charles Lange
Charles Lange
12/22 - 12/29/70



Homer D. Ralph, Jr.
Homer D. Ralph, Jr.
Surveyor for Grant
County, Wisconsin