


WEIGEL SURVEY

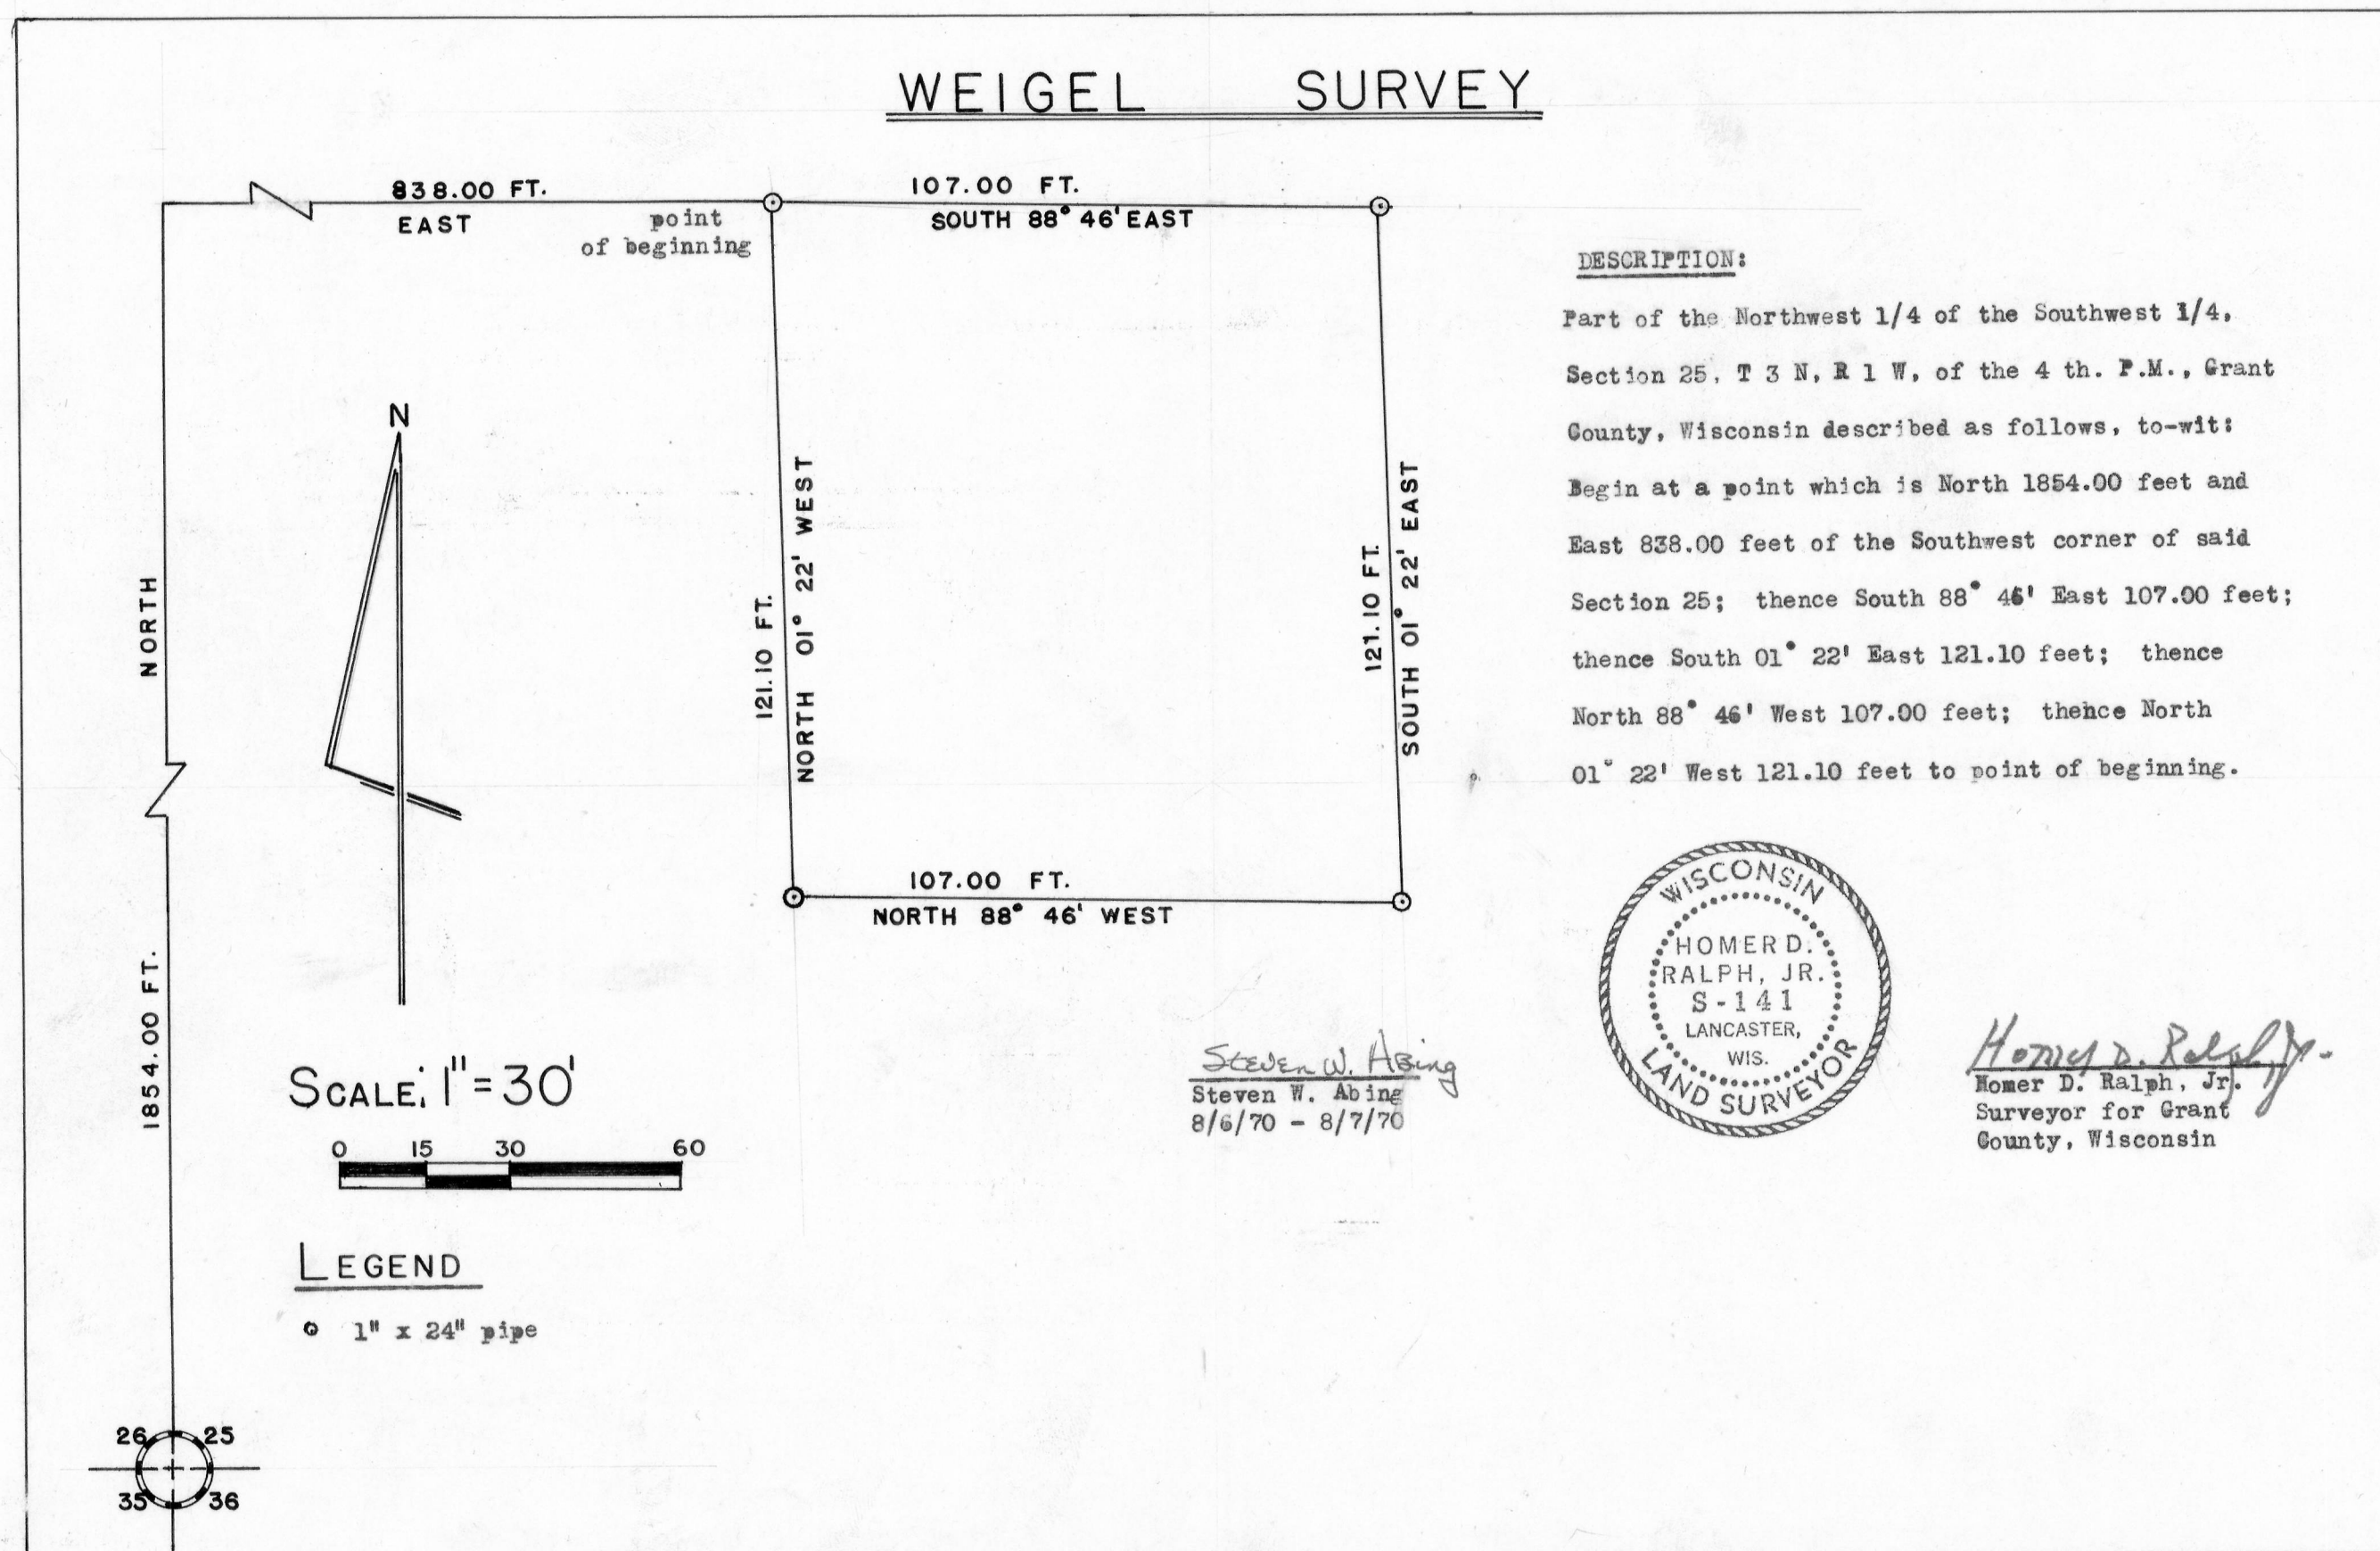

DESCRIPTION:

Part of the Northwest 1/4 of the Southwest 1/4, Section 25, T 3 N, R 1 W, of the 4 th. P.M., Grant County, Wisconsin described as follows, to-wit: Begin at a point which is North 1854.00 feet and East 838.00 feet of the Southwest corner of said Section 25; thence South 88° 46' East 107.00 feet; thence South 01° 22' East 121.10 feet; thence North 88° 46' West 107.00 feet; thence North 01° 22' West 121.10 feet to point of beginning.