


LESTER BELLMEYER SURVEY


SCALE: 1" = 50'

○ DENOTES 1" X 24" IRON PIPE PLACED BY THIS SURVEY.

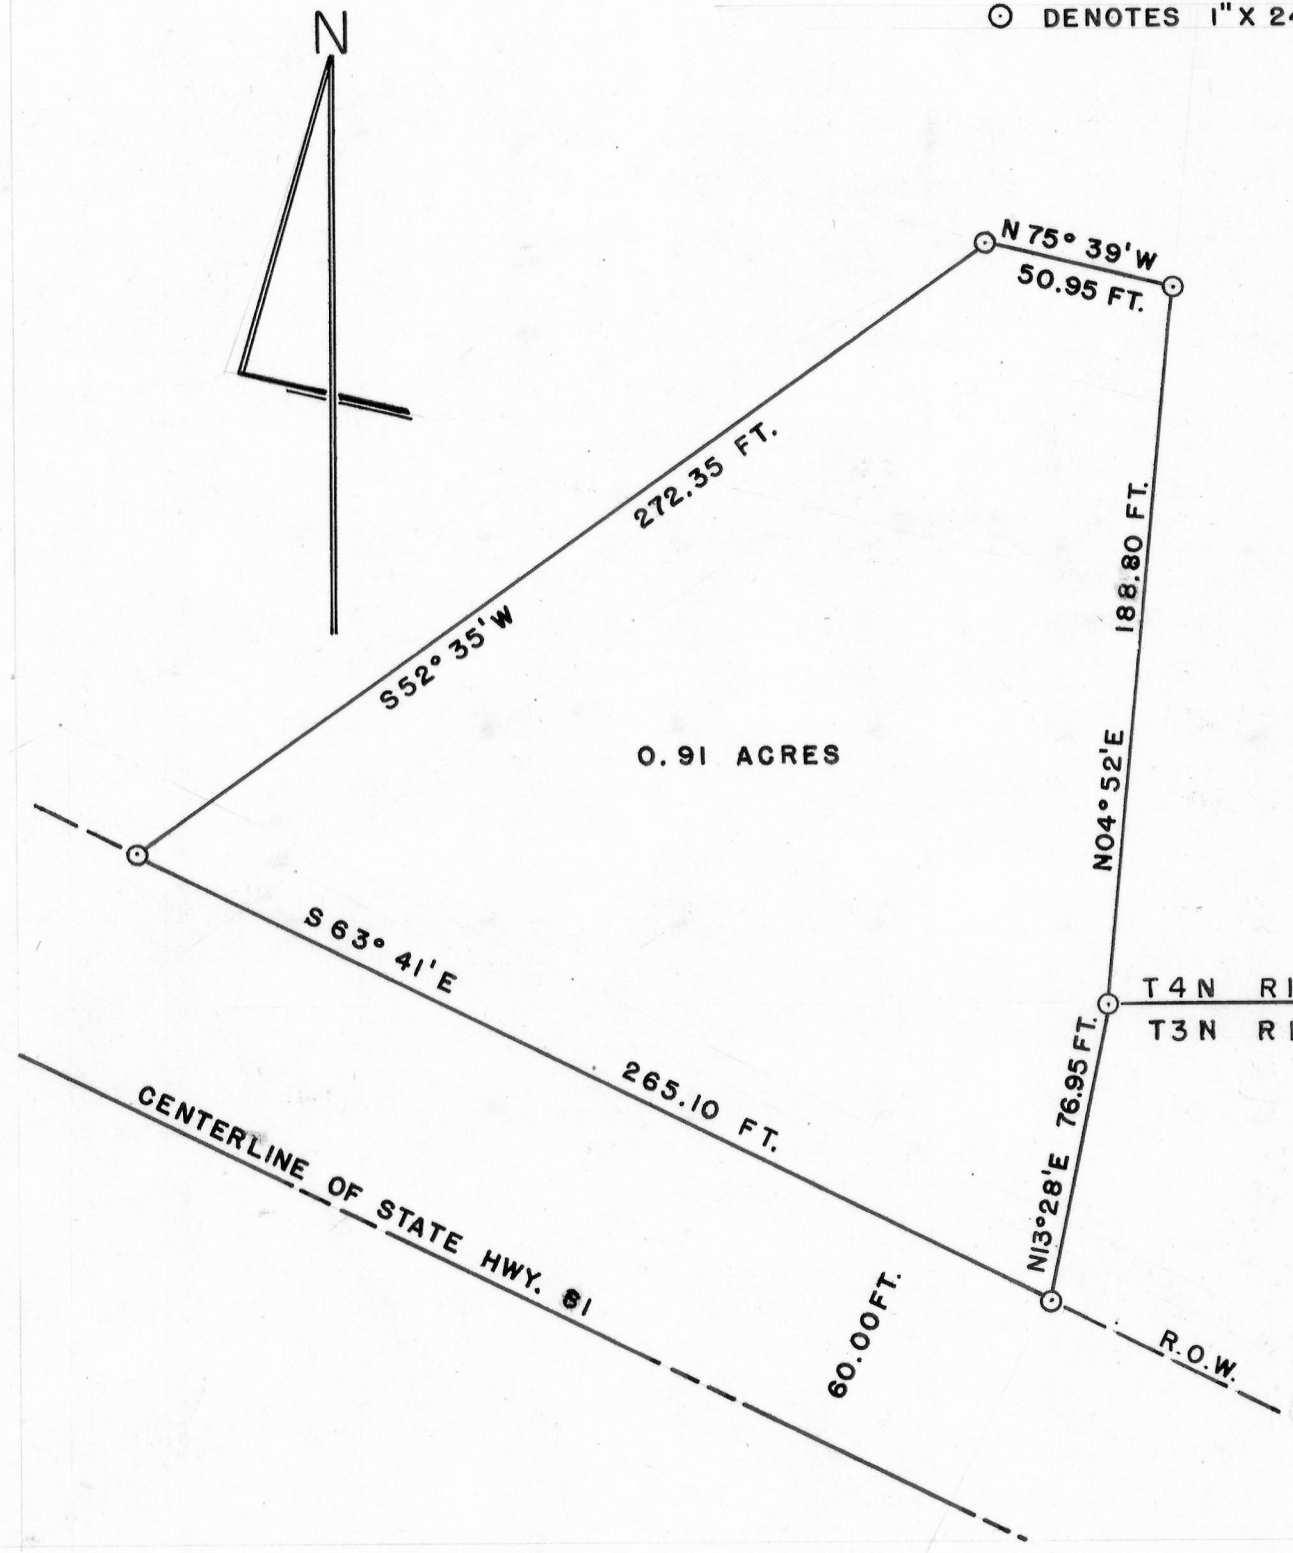

DESCRIPTION:

A part of the Southwest 1/4 of the Southeast 1/4 of Section 31, T4 N, R 1 W, and part of the Northwest 1/4 of the Northeast 1/4 of Section 6, T 3 N, R 1 W, of the 4 th. P.M., Grant County, Wisconsin, described as follows to-wit:
Begin at the Southeast corner of the Southwest 1/4 of Southeast 1/4 of said Section 31; thence West 676.05 ft. to point of beginning; thence North 04° 52' East 188.80 ft.; thence North 75° 39' West 50.95 ft.; thence South 52° 35' West 272.35 ft.; thence South 63° 41' East 265.10 ft. along the Northerly R.O.W. of State Hwy. # 81; thence North 13° 28' East 76.95 ft. to point of beginning, containing 0.91 acres more or less.

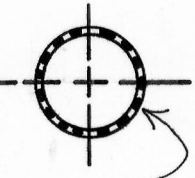

S.E. CORNER OF
S.W. 1/4, S.E. 1/4,
SEC. 31-4-1

Steven Abing
Steven Abing 6/25/70-
6/26/70

Homer D. Ralph, Jr.
Homer D. Ralph, Jr.
Surveyor of Grant County,
Wisconsin

