


MELLOR SURVEY

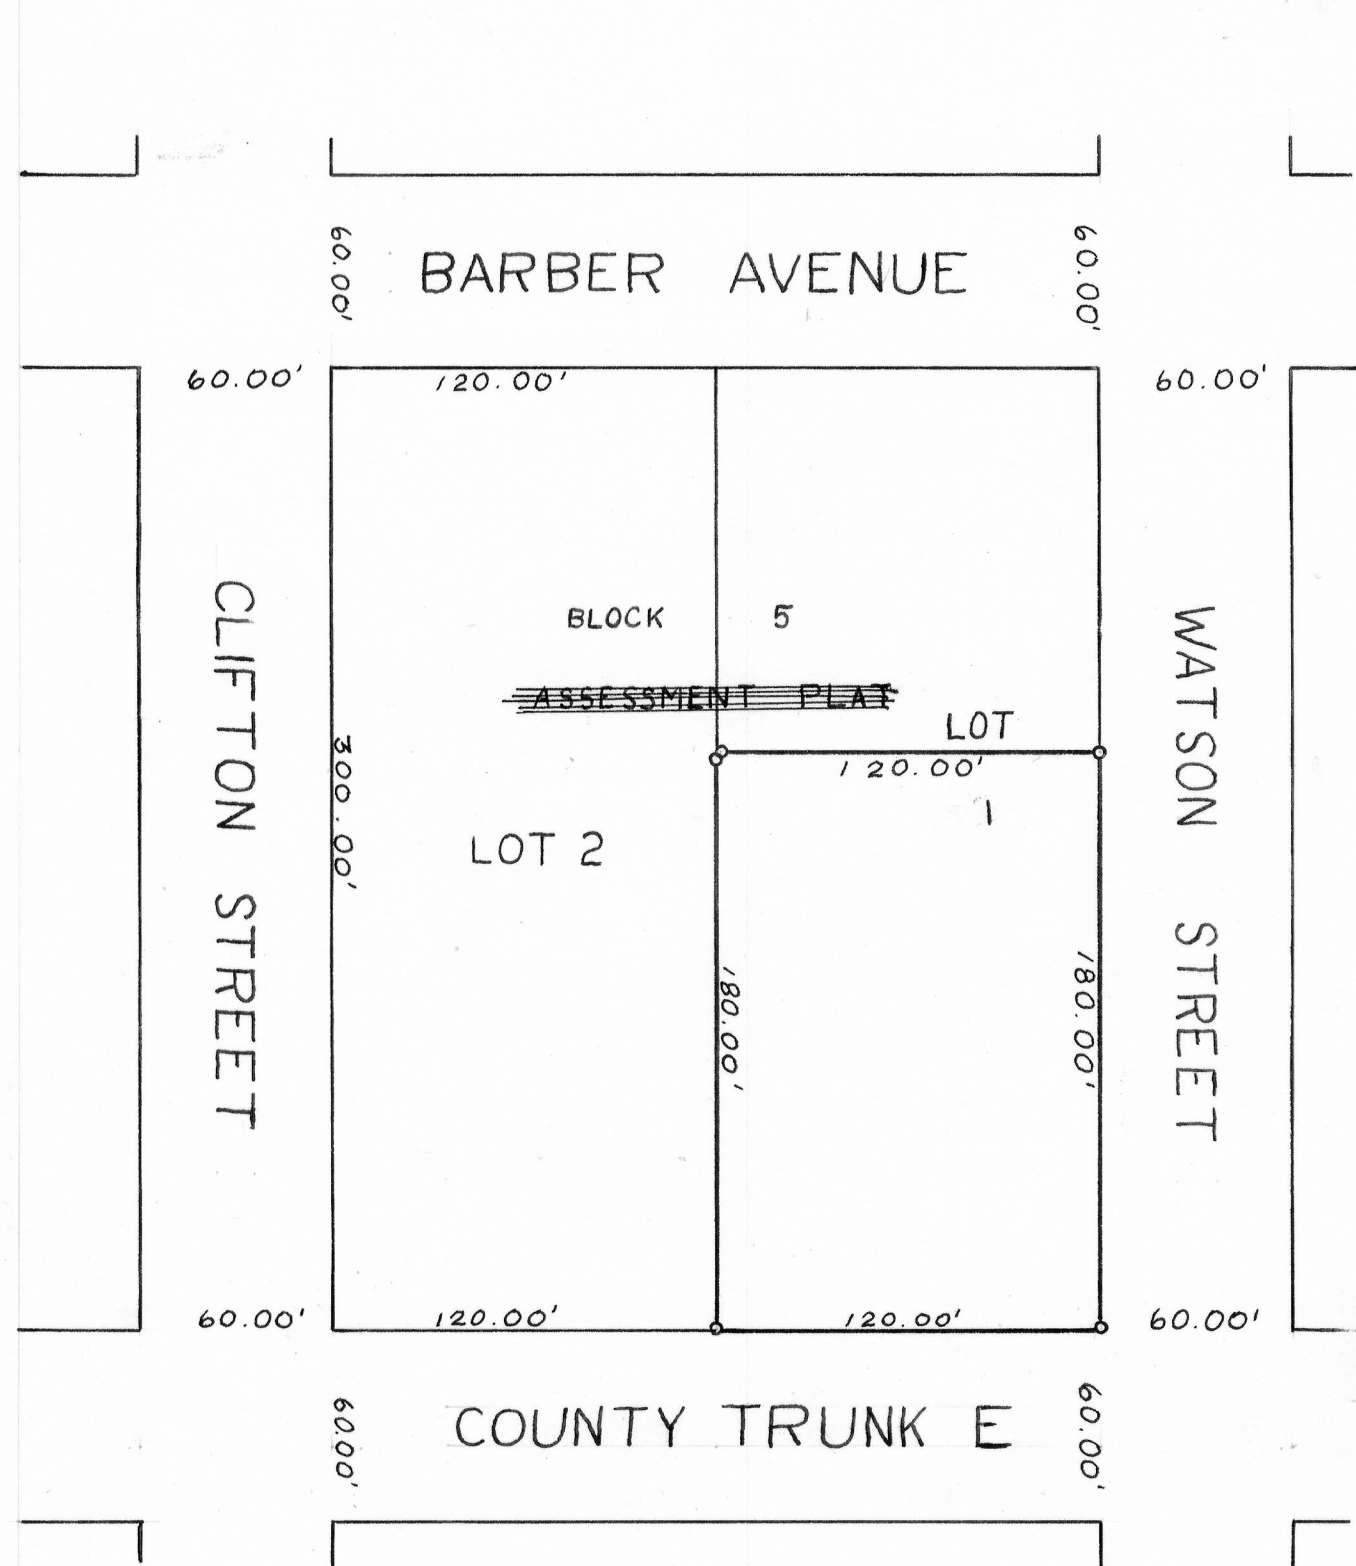


DESCRIPTION

Beginning at the Southeast Corner of Block 5 of Livingston's Second Addition to the Village of Livingston, Grant County, Wisconsin, as per the recorded map or plat thereof ; thence North 180.00 feet ; thence West 120.00 feet ; thence South 180.00 feet ; thence East 120.00 feet to point of beginning.


Also being a part of Lot 1 of Block 5 of Livingston's Second Addition to Livingston.

SCALE : 1" = 60'

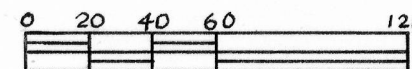

o 1" X 24" iron pipe placed by this survey.

*John E. Elwell*  
John Elwell  
6/8/73 - 6/12/73

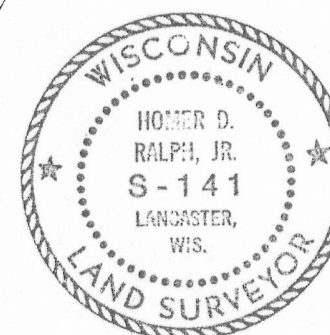

*Homer D. Ralph Jr.*  
Homer D. Ralph Jr.  
Surveyor for Grant  
County, Wisconsin.