


HOEPER SURVEY

○ - 1" X 24" Iron Pipe Placed By This Survey

● - 1" Iron Pipe Found In Corner Of Block 6

SCALE: 1" = 30'

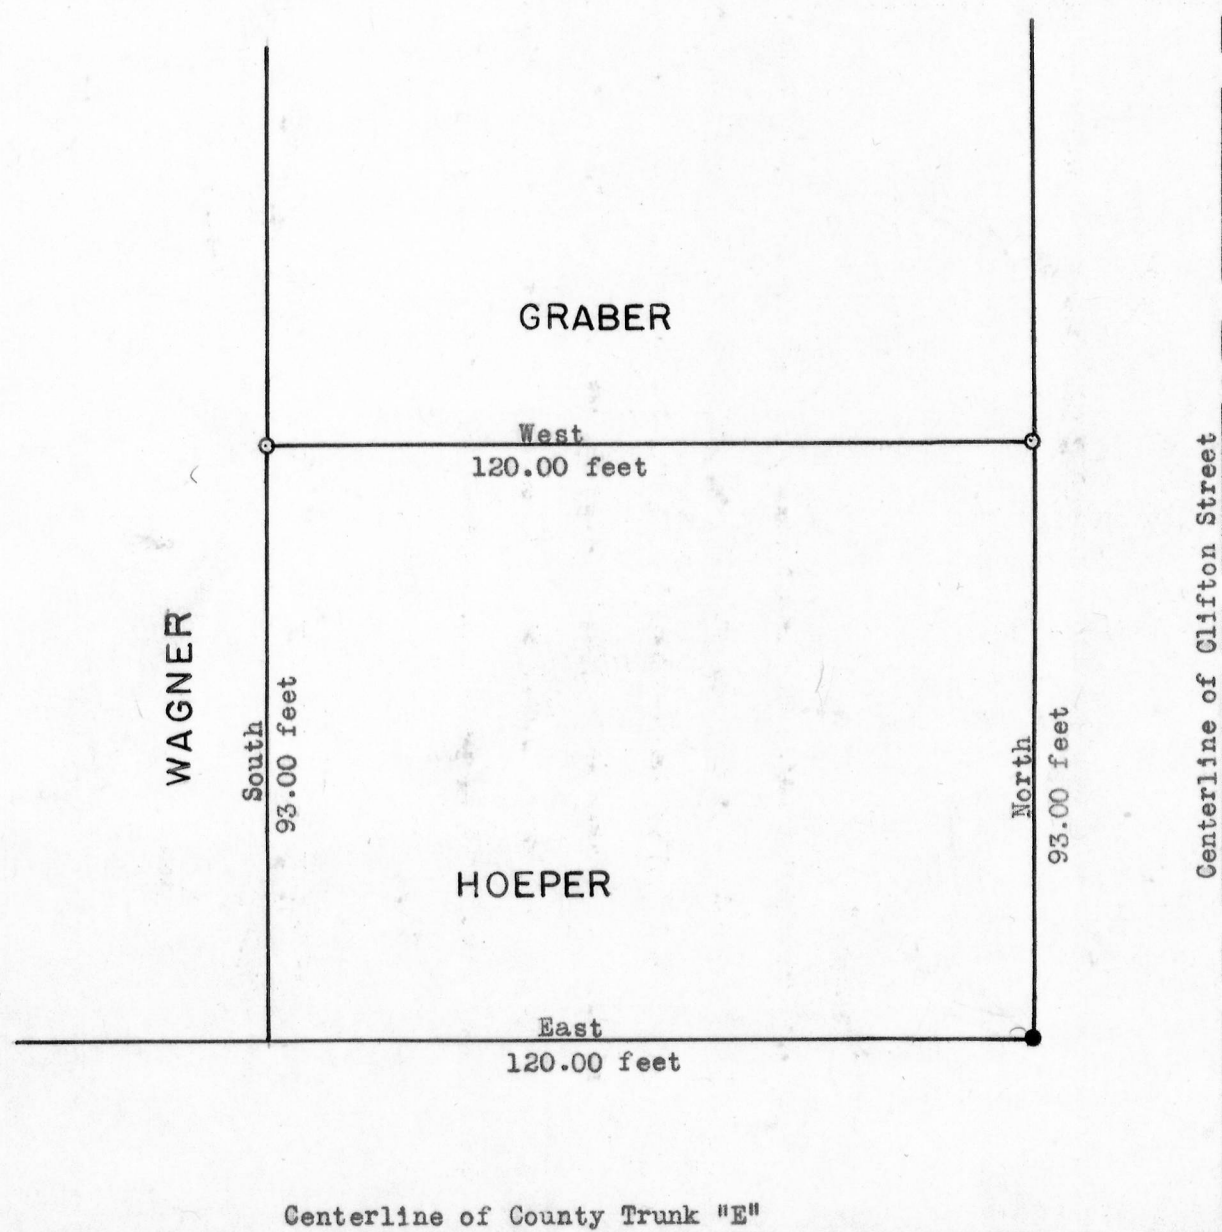

N
S

DESCRIPTION:

A part of Block 6, Livingston Second Add. to the Village of Livingston, Grant County, Wisconsin


described as follows, to wit:

Beginning in the Southeast corner of said Block

6; thence North 93.00 feet; thence West 120.00 feet;

thence South 93.00 feet; thence East 120.00 feet

to the point of beginning.

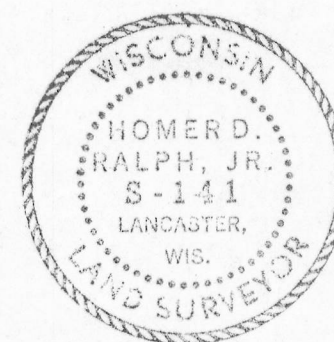

Charles Lange
Charles Lange
6/12-6/23/72

Homer D. Ralph, Jr.
Homer D. Ralph, Jr.
Surveyor for Grant
County, Wisconsin.