


SLACK SURVEY


SCALE: 1" = 40'

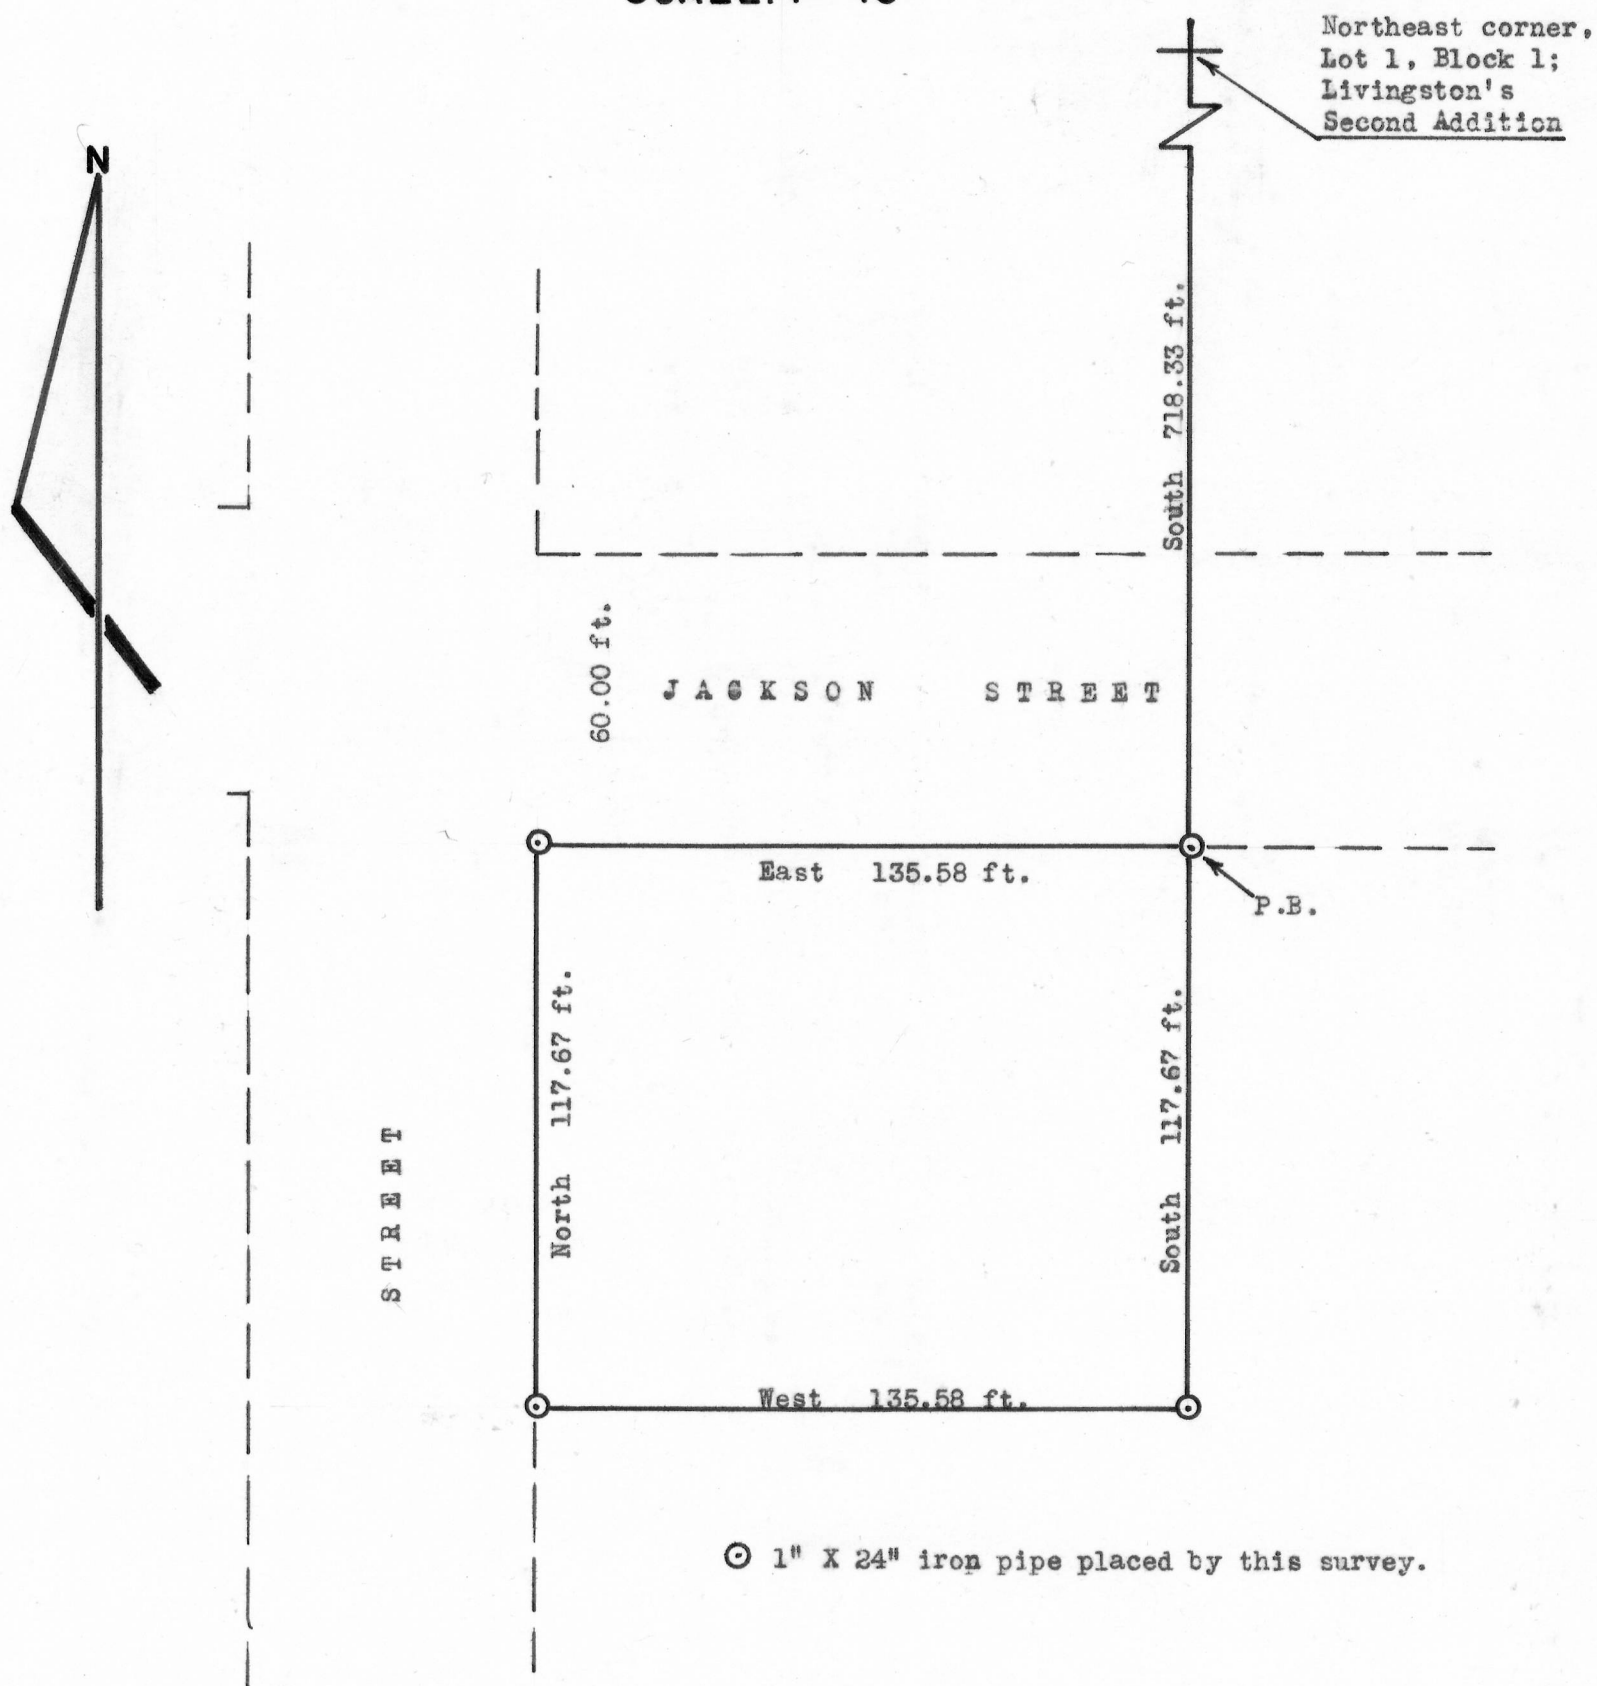

DESCRIPTION

Begin at a point which is 718.33 feet South of the Northeast corner of Lot 1, Block 1, in Livingston's Second Addition to Livingston in the N.W.1/4 of the N.E.1/4 of Section 24, T 5 N, R 1 W of the 4th P.M., Grant County, Wisconsin; thence South 117.67 feet; thence West 135.58 feet; thence North 117.67 feet; thence East 135.58 feet to the place of beginning. Being designated as part of Lot 42A of the Assessor's Plat to the Village of Livingston.

Charles Lange
Charles Lange
6/8 - 6/9/71

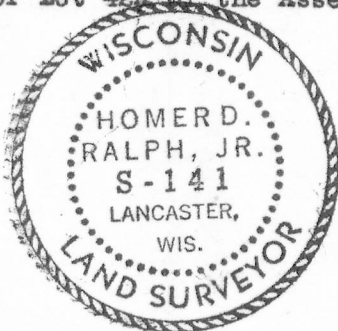

Homer D. Ralph, Jr.
Homer D. Ralph, Jr.
Surveyor for Grant
County, Wisconsin.