


PETERSON SURVEY

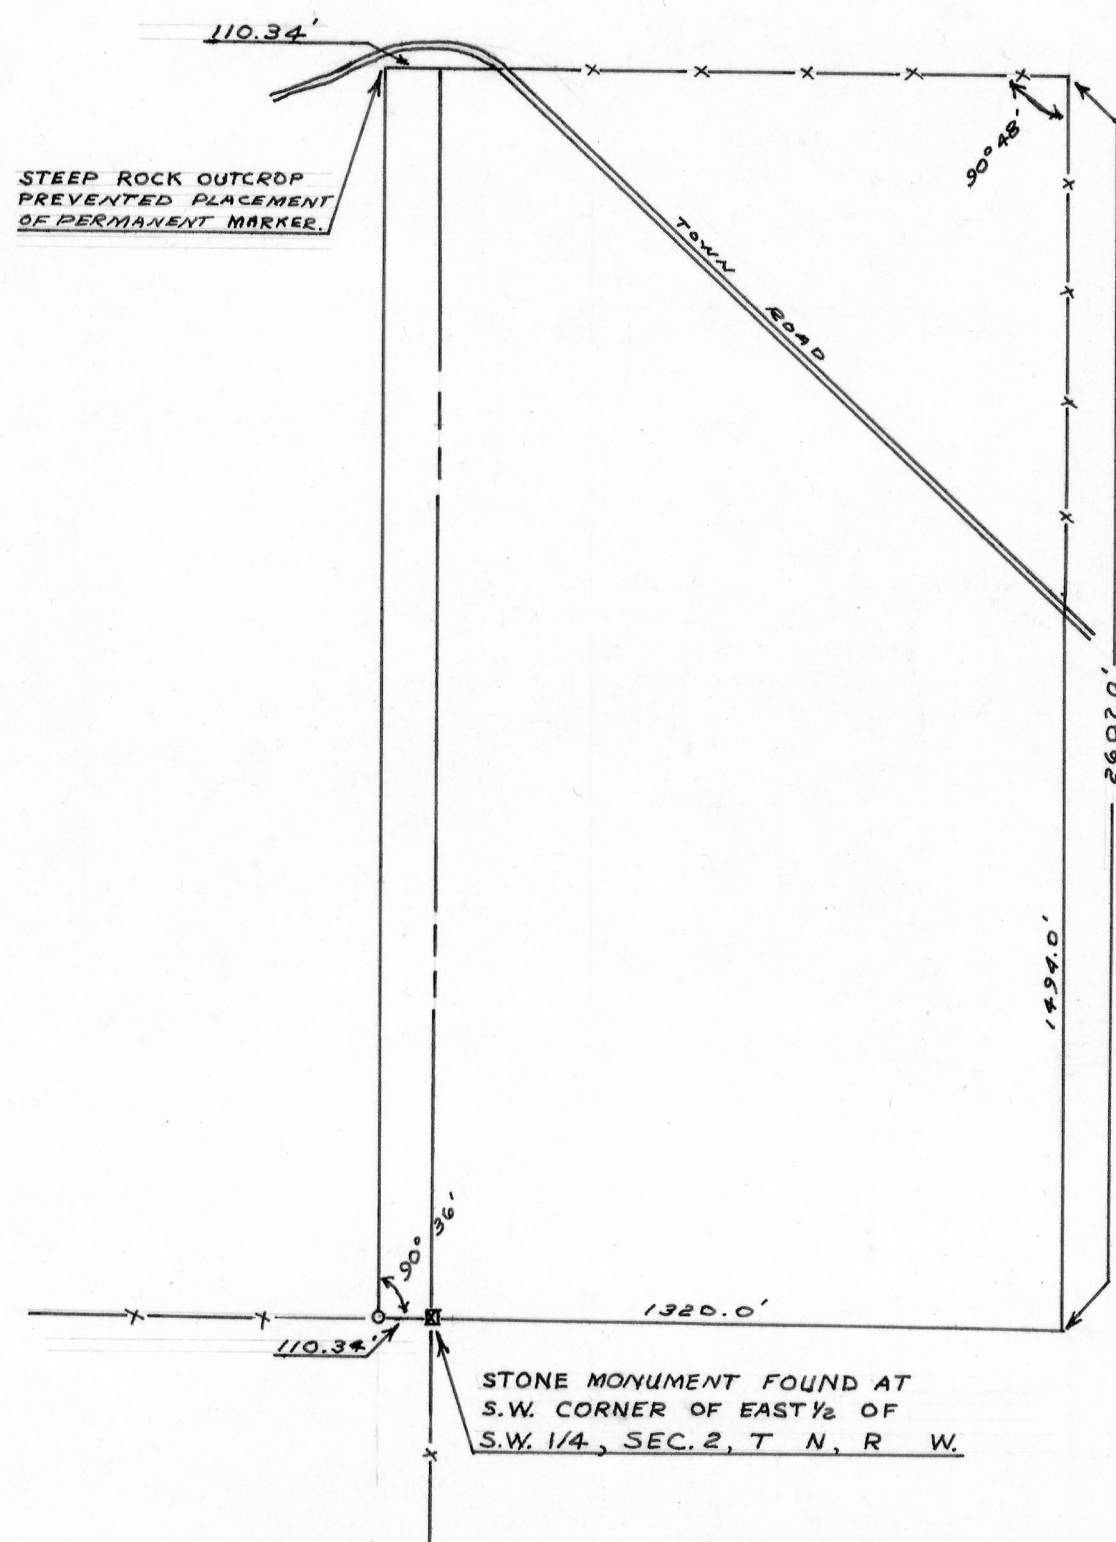


SCALE: 1" = 400'

○ 1" X 24" Iron pipe placed by this survey.

DESCRIPTION:

That part of the East 1/2 of the S.W. 1/4 lying South of the town road; Also the East 110.34 feet of the West 1/2 of the S.W. 1/4, all in Section 2, T 6 N, R 1 W., of the 4th P.M., Grant County, Wisconsin. Containing 67.72 acres, more or less.

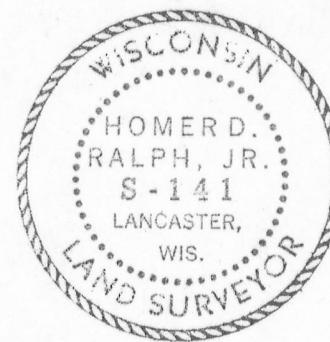

Charles Lange
Charles Lange
5/24 - 6/22/72

Homer D. Ralph, Jr.
Homer D. Ralph, Jr.
Surveyor for Grant
County, Wisconsin.