



KLINDT - EASTMAN CARTWRIGHT SURVEY

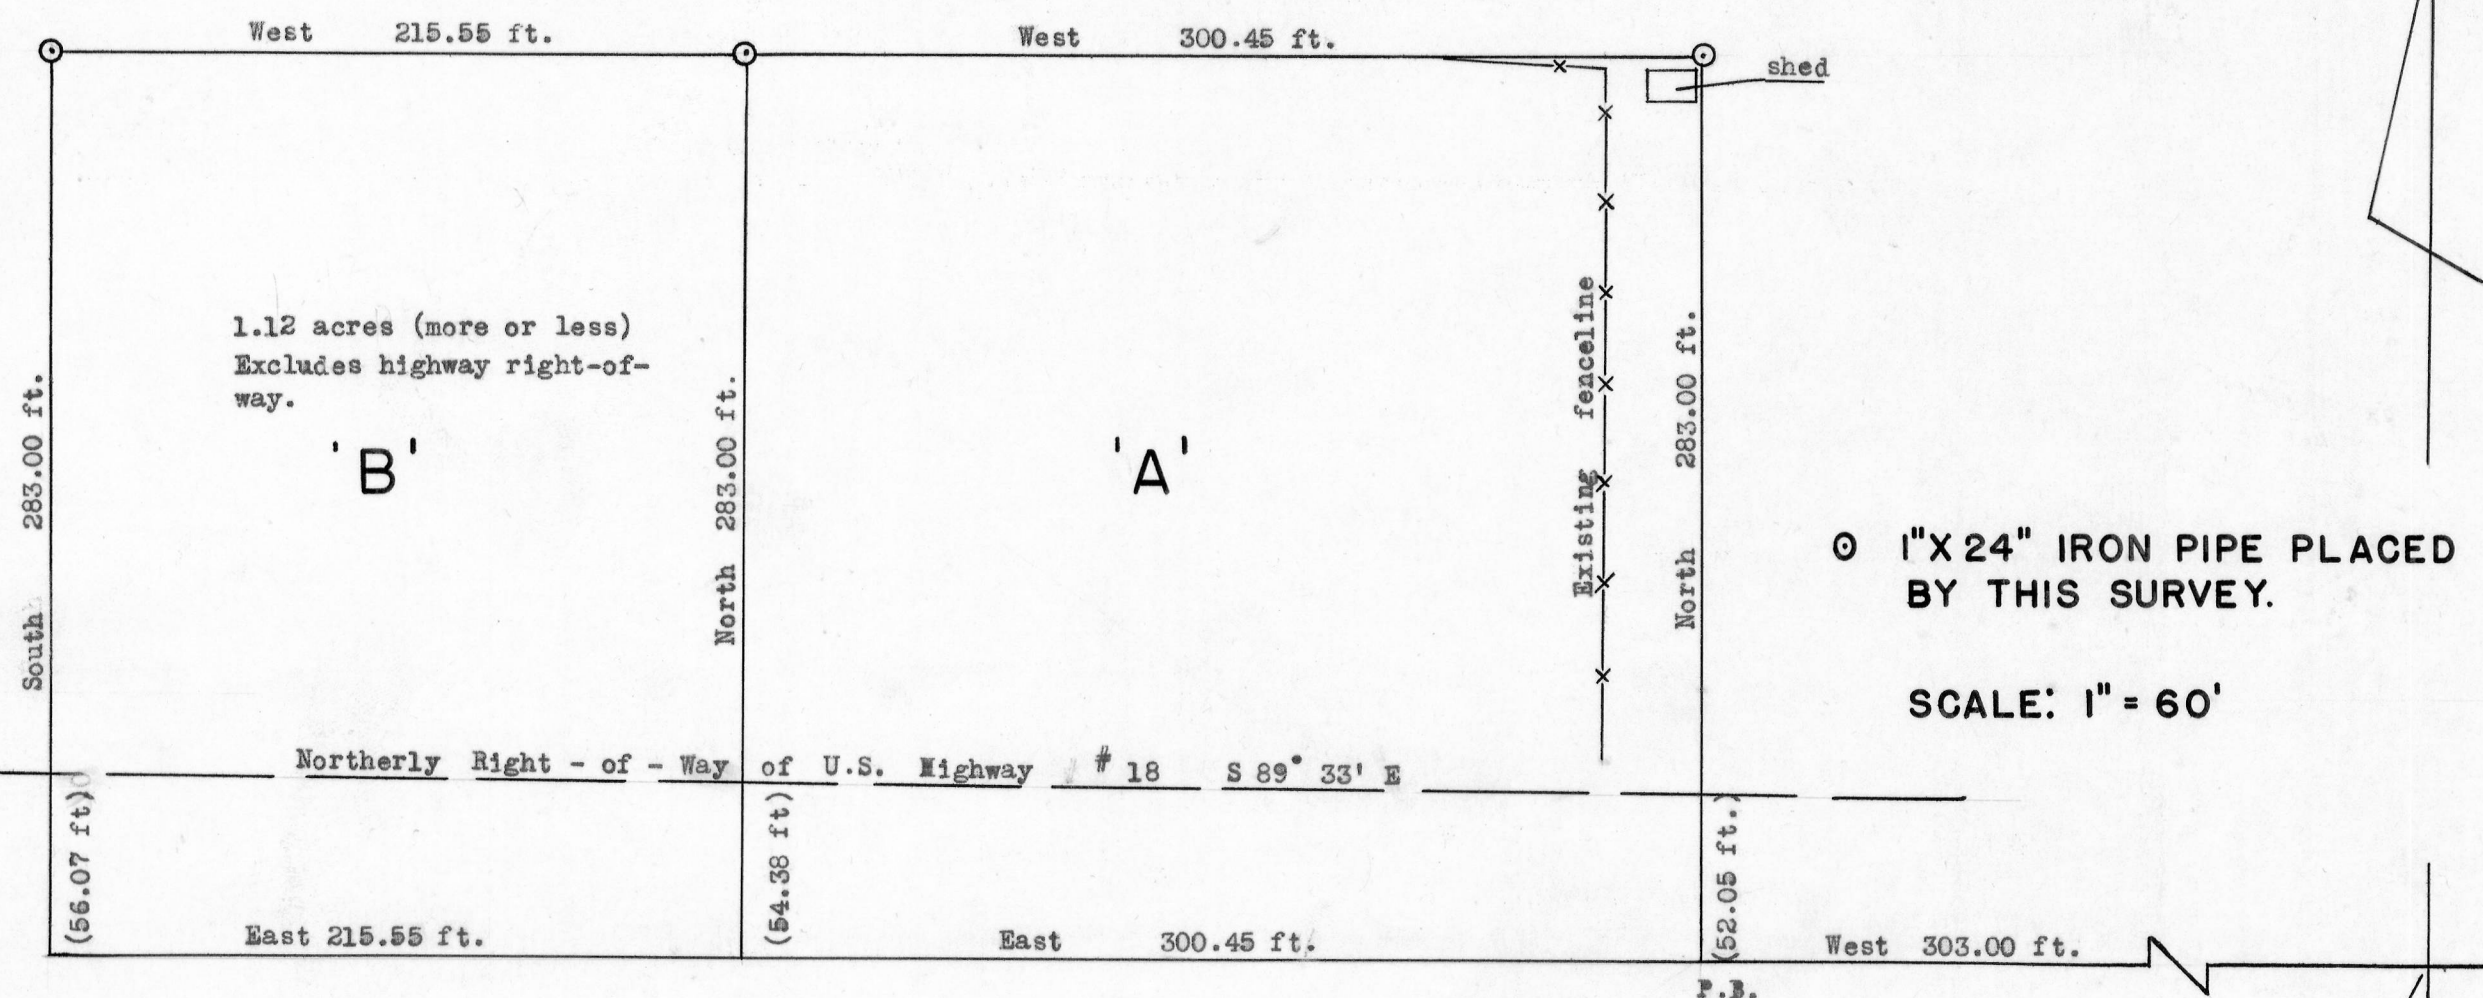

Charles Lange
Charles Lange
1/25 - 3/27/71

Homer D. Ralph, Jr.
Homer D. Ralph, Jr.
Surveyor for Grant
County, Wisconsin

S.E. corner,
S.W.1/4, N.E.1/4,
Sec. 25 - 6 - 1.

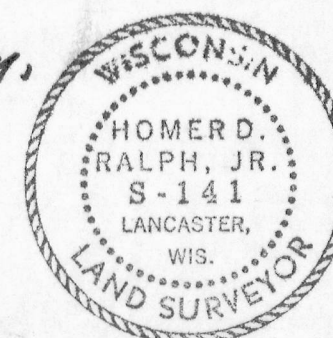


KLINDT - EASTMAN CARTWRIGHT LUMBER COMPANY

DESCRIPTION OF TRACT "A":

A part of the S.W.1/4 of N.E.1/4 of Section 25, T 6 N, R 1 W. of the 4th P.M. in the Village of Montfort, Grant County, Wisconsin, described as follows, to-wit: Begin at a point which is 303.00 feet West of the Southeast corner of said S.W.1/4 of N.E.1/4; thence North 283.00 feet; thence West 300.45 feet; thence South 283.00 feet; thence East 300.45 feet to the point of beginning.

DESCRIPTION OF TRACT "B":

A part of the S.W.1/4 of N.E.1/4 of Section 25, T 6 N, R 1 W. of the 4th P.M. in the Village of Montfort, Grant County, Wisconsin, described as follows, to-wit: Begin at a point 603.45 feet West of the Southeast corner of said S.W.1/4 of N.E.1/4; thence North 283.00 feet; thence West 215.55 feet; thence South 283.00 feet; thence East 215.55 feet to the point of beginning.

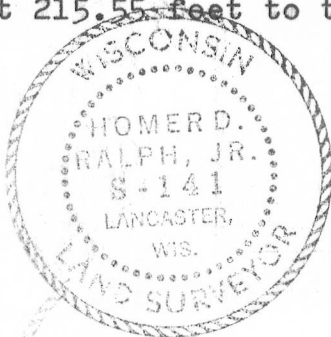

Homer D. Ralph, Jr.
Homer D. Ralph, Jr.
Surveyor for Grant
Co., Wis.

1/25/71 - 3/27/71