



RUZICKA SURVEY

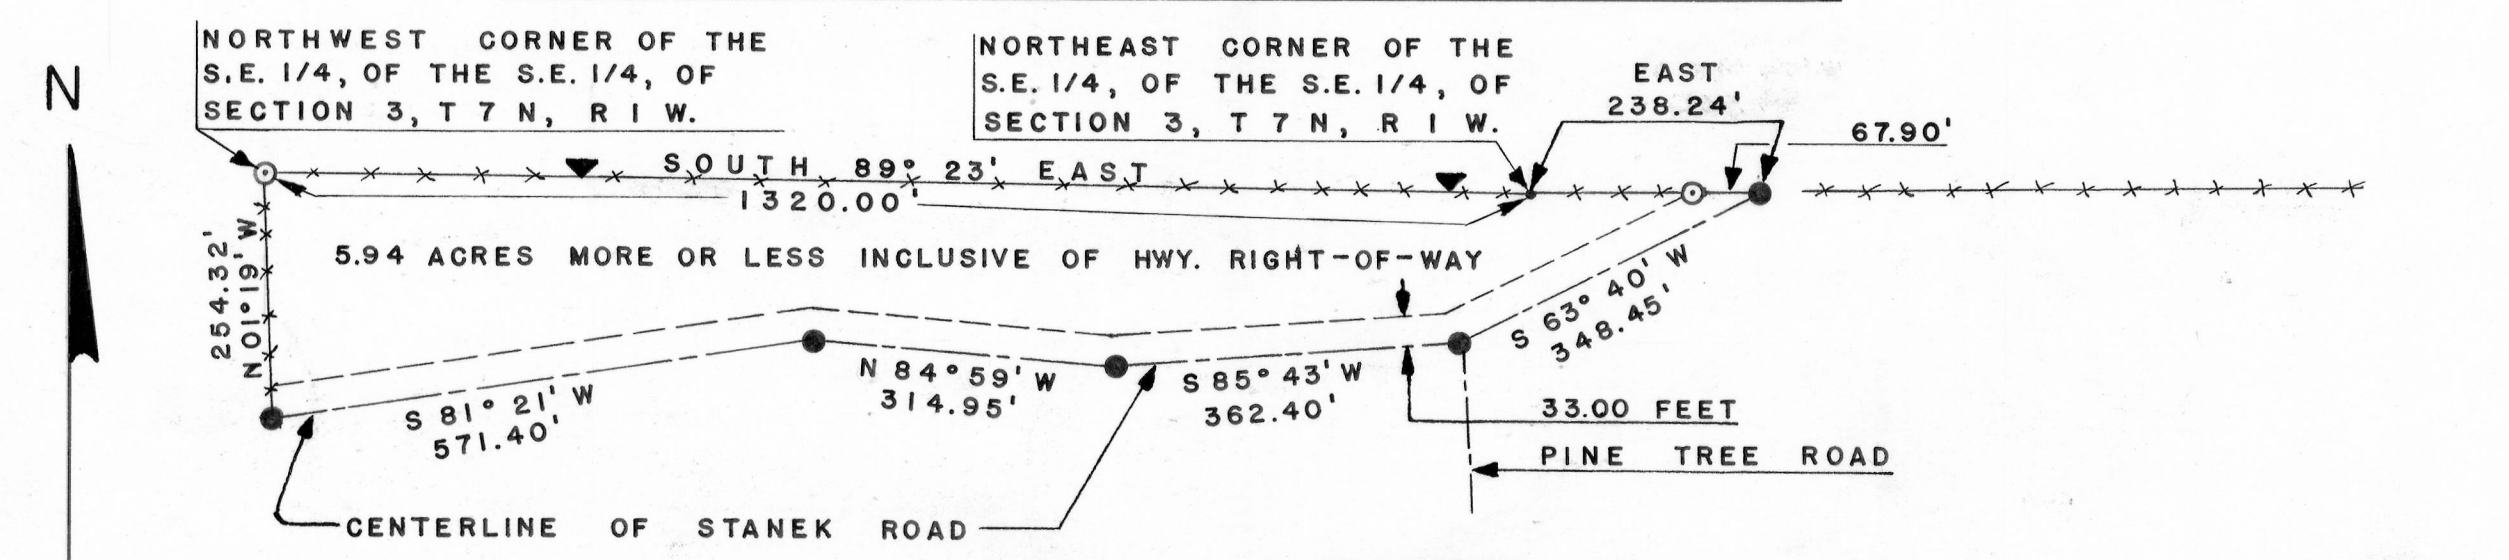

SCALE: 1" = 200'

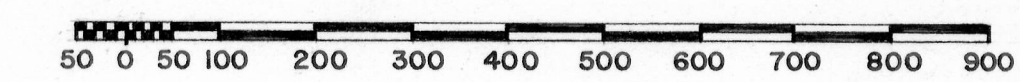

LEGEND:

- 1" X 24" IRON PIPE PLACED BY THIS SURVEY
- NAIL PLACED BY THIS SURVEY
- ▼ LATH PLACED BY THIS SURVEY
- CENTERLINE
- RIGHT-OF-WAY
- XXXXXX FENCE

DESCRIPTION:

Part of the S.E. 1/4, of the S.E. 1/4, of Section 3, and part of the S.W. 1/4, of the S.W. 1/4, of Section 2, all in T 7 N, R 1 W, of the 4th P.M., Grant County, Wisconsin, described as follows to-wit:

Begin at the Northwest corner of the S.E. 1/4, of the S.E. 1/4, of said Section 3; thence South 89° 23' East 1320.00 feet; thence East 238.24 feet to the centerline of town road; thence South 63° 40' West 348.45 feet along said centerline; thence South 85° 43' West 362.40 feet along said centerline; thence North 84° 59' West 314.95 feet along said centerline; thence South 81° 21' West 571.40 feet along said centerline; thence North 01° 19' West 254.32 feet to the point of beginning.

Containing 5.94 acres more or less inclusive of highway right-of-way.

David K. Krohn
DAVID K. KROHN
12/27/73 — 1/8/74

Homer D. Ralph, Jr.
HOMER D. RALPH, JR.
SURVEYOR FOR GRANT
COUNTY, WISCONSIN.

