


N

SECTION CORNER
T 7 N, R 1 W
GRANT COUNTY,
WISCONSIN

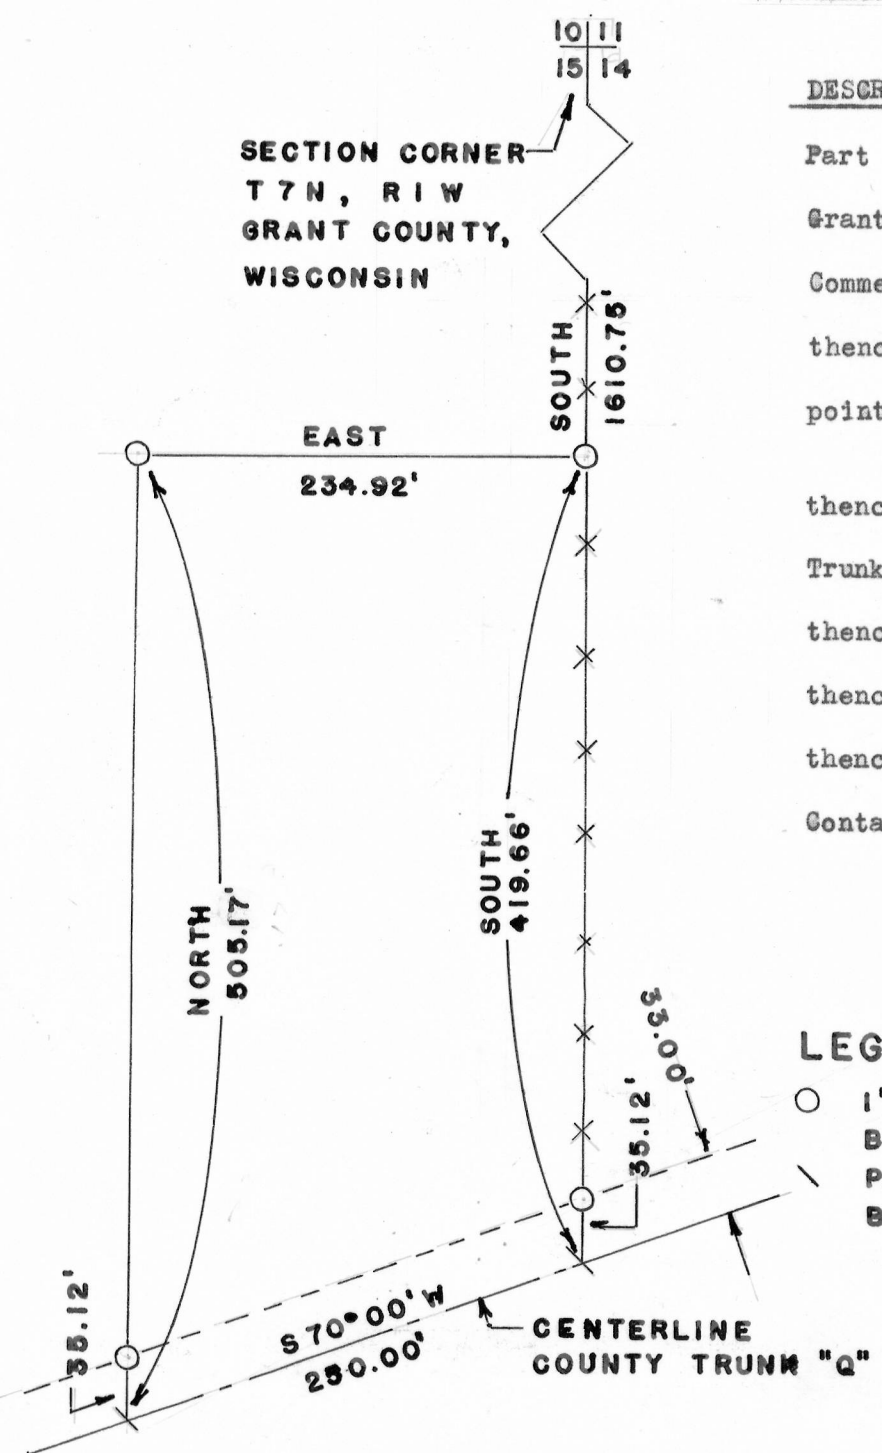

VANYIVINE SURVEY

DESCRIPTION:

Part of the S.E. 1/4 of the N.E. 1/4 of Section 15, T 7 N, R 1 W, of the 4th P.M., Grant County, Wisconsin, described as follows to-wit:

Commencing at the Northeast Corner of said Section 15;

thence South 1610.75 feet along the east line of said Section 15 to the point of beginning;


thence South 419.66 feet along said section line to the centerline of County Trunk Highway "Q";

thence South 70° 00' West 250.00 feet along said centerline;

thence North 505.17 feet;

thence East 234.92 feet to the point of beginning.

Containing 2.50 acres more or less inclusive of highway right-of-way.

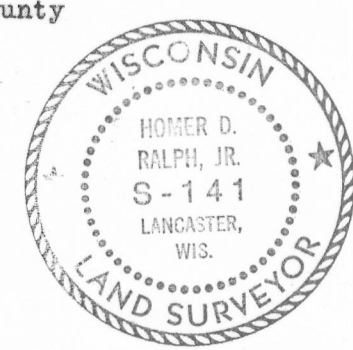

LEGEND:

- 1" X 24" PIPE PLACED BY THIS SURVEY
- P.K. NAIL PLACED BY THIS SURVEY

David K. Krohn
DAVID K. KROHN
11/21/74 11/27/74

Homer D. Ralph, Jr.
HOMER D. RALPH JR.
SUREYOR FOR GRANT
COUNTY, WISCONSIN

SCALE: 1" = 100'

