


KOMOUT SURVEY

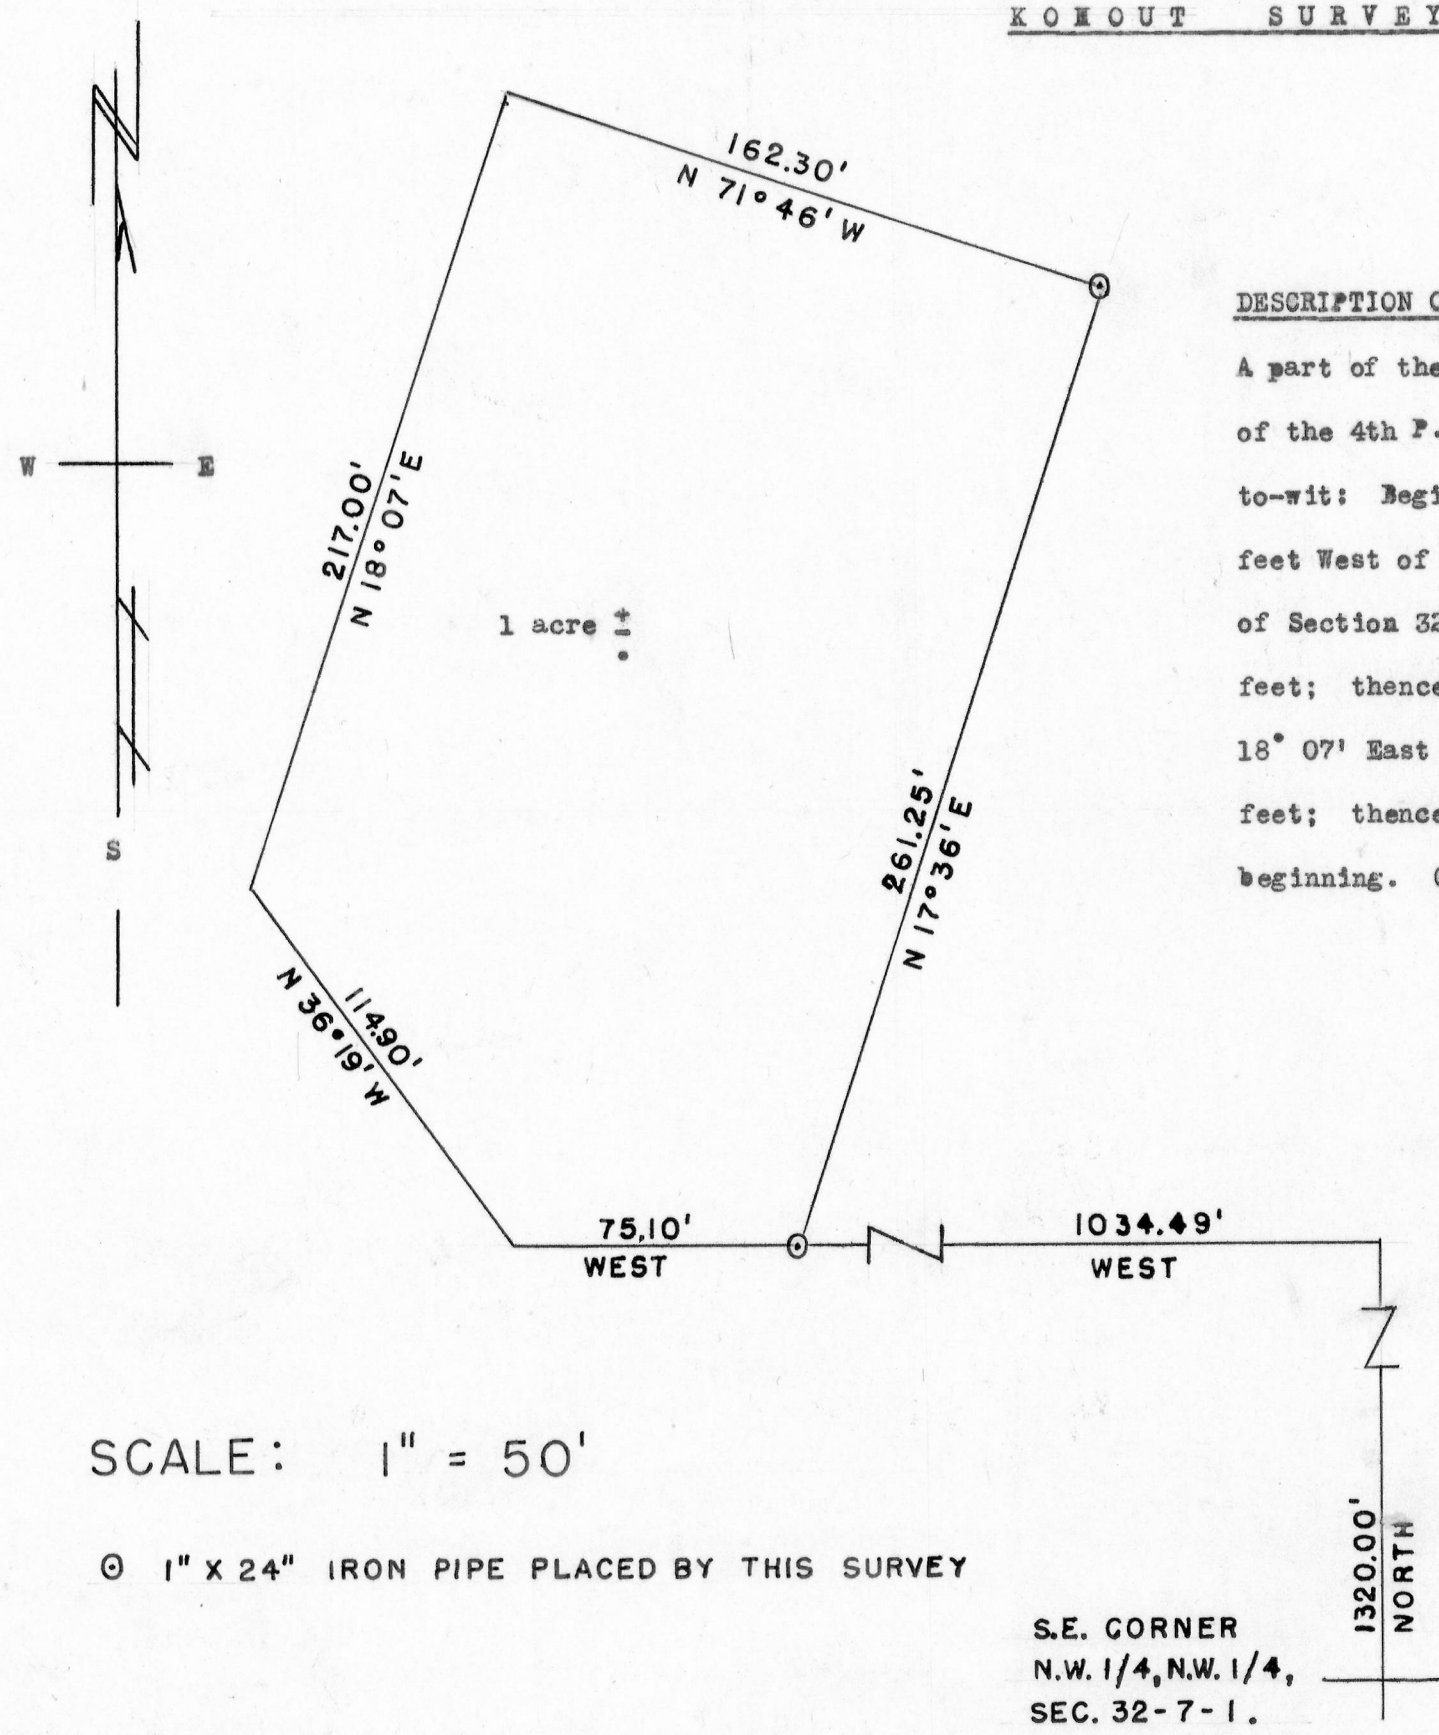

DESCRIPTION OF LANDS SURVEYED:

A part of the S.W.1/4 of S.W.1/4 of Section 29, T 7 N, R 1 W. of the 4th P.M., Grant County, Wisconsin, described as follows, to-wit: Begin at a point which is 1320 feet North and 1034.49 feet West of the Southeast corner of the N.W.1/4 of N.W.1/4 of Section 32, Town and Range aforesaid; thence West 75.10 feet; thence North 36° 19' West 114.90 feet; thence North 18° 07' East 217.00 feet; thence South 71° 46' East 162.30 feet; thence South 17° 36' West 261.25 feet to the place of beginning. Containing 1 acre more or less.

Homer D. Ralph, Jr.
Homer D. Ralph, Jr.
Surveyor for Grant Co., Wis.
3/13/71 - 3/30/71

