


DICK STUDNICKA SURVEY

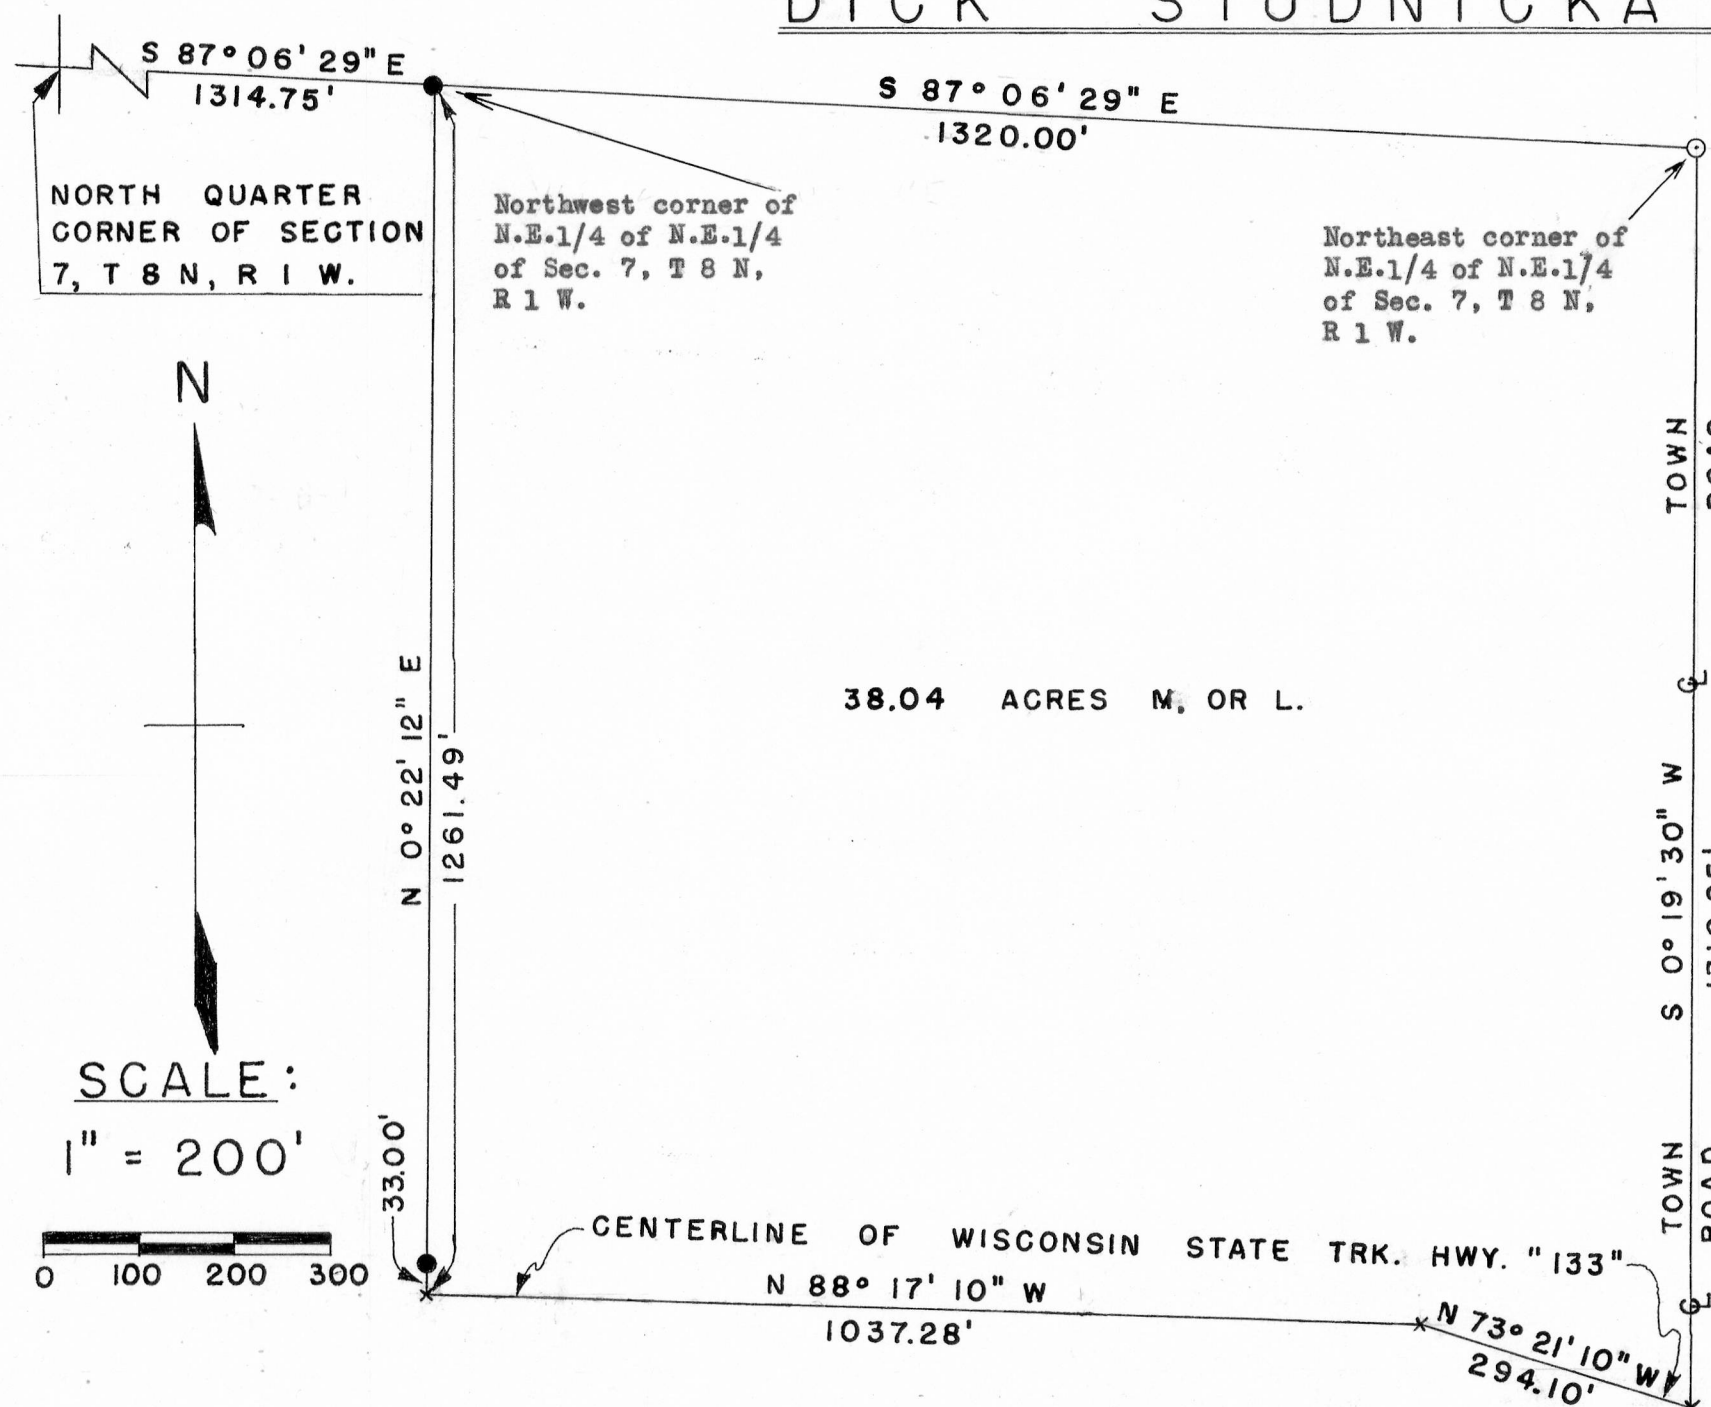

DESCRIPTION:

A part of the N.E. 1/4 of the N.E. 1/4 of Section 7, T 8 N, R 1 W, of the 4th P.M., Grant County, Wisconsin, described as follows to-wit:

Begin at a point which is South 87° 06' 29'' East 1314.75 feet from the North Quarter Corner of said Section 7; thence South 87° 06' 29'' East 1320.00 feet; thence South 0° 19' 30'' West 1310.25 feet to the centerline of Wisconsin State Trunk Highway "133"; thence North 73° 21' 10'' West 294.10 feet along said centerline; thence North 88° 17' 10'' West 1037.28 feet along said centerline; thence North 0° 22' 12'' East 1261.49 feet to the point of beginning. Containing 38.04 acres more or less.



- 5/8" X 24" REINFORCING BAR PLACED BY PREVIOUS SURVEY
- 1" X 24" IRON PIPE PLACED BY THIS SURVEY
- X NAIL PLACED IN CENTERLINE BY THIS SURVEY

David H. Krohn
DAVID K. KROHN
8/16/73 - 8/20/73

Homer D. Ralph, Jr.
HOMER D. RALPH, JR.
SURVEYOR FOR GRANT
COUNTY, WISCONSIN