


COPY IN LARGE TWP
FOLDER FOR COPYING

TAYLOR SURVEY

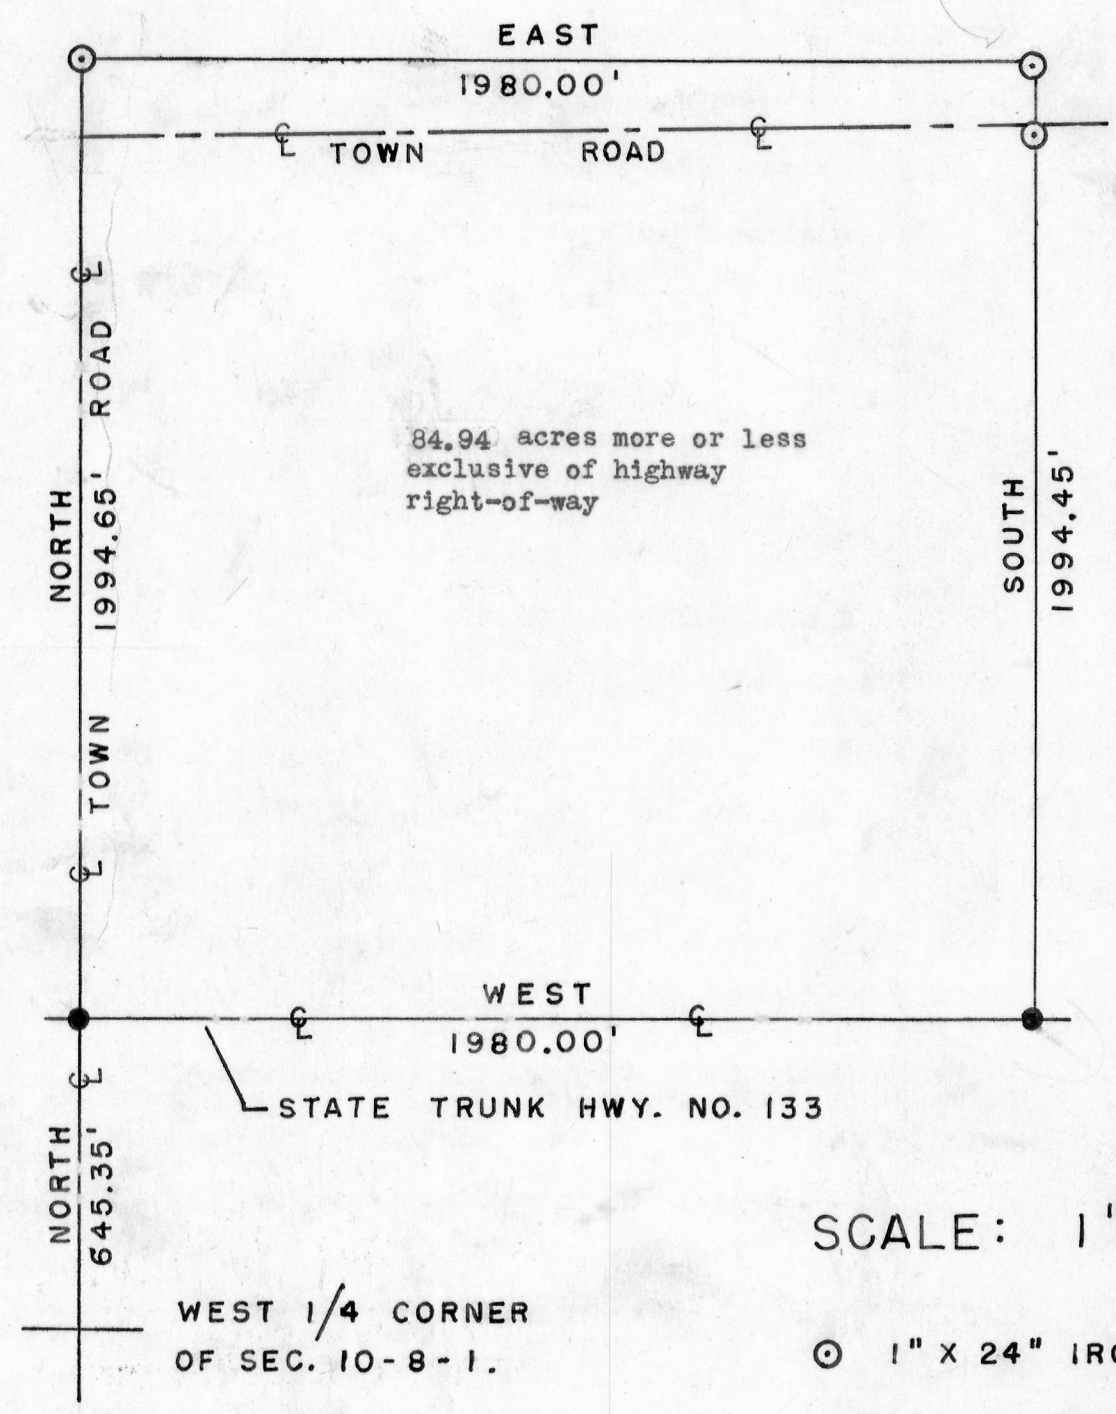

DESCRIPTION:

All that part of the West 3/4 of the N.W.1/4 of Section 10,
T 8 N, R 1 W. of the 4th P.M., Grant County, Wisconsin
which lies North of the right-of-way of State Trunk
Highway #133.



David Krohn
David Krohn
4/24/71 - 5/4/71

Homer D. Ralph, Jr.
Homer D. Ralph, Jr.
Surveyor for Grant
County, Wisconsin

SCALE: 1" = 400'

- ⊙ 1" x 24" IRON PIPE PLACED BY THIS SURVEY
- RAILROAD SPIKE PLACED BY THIS SURVEY

1994.65
645.35
2640.00