


1" = 40'

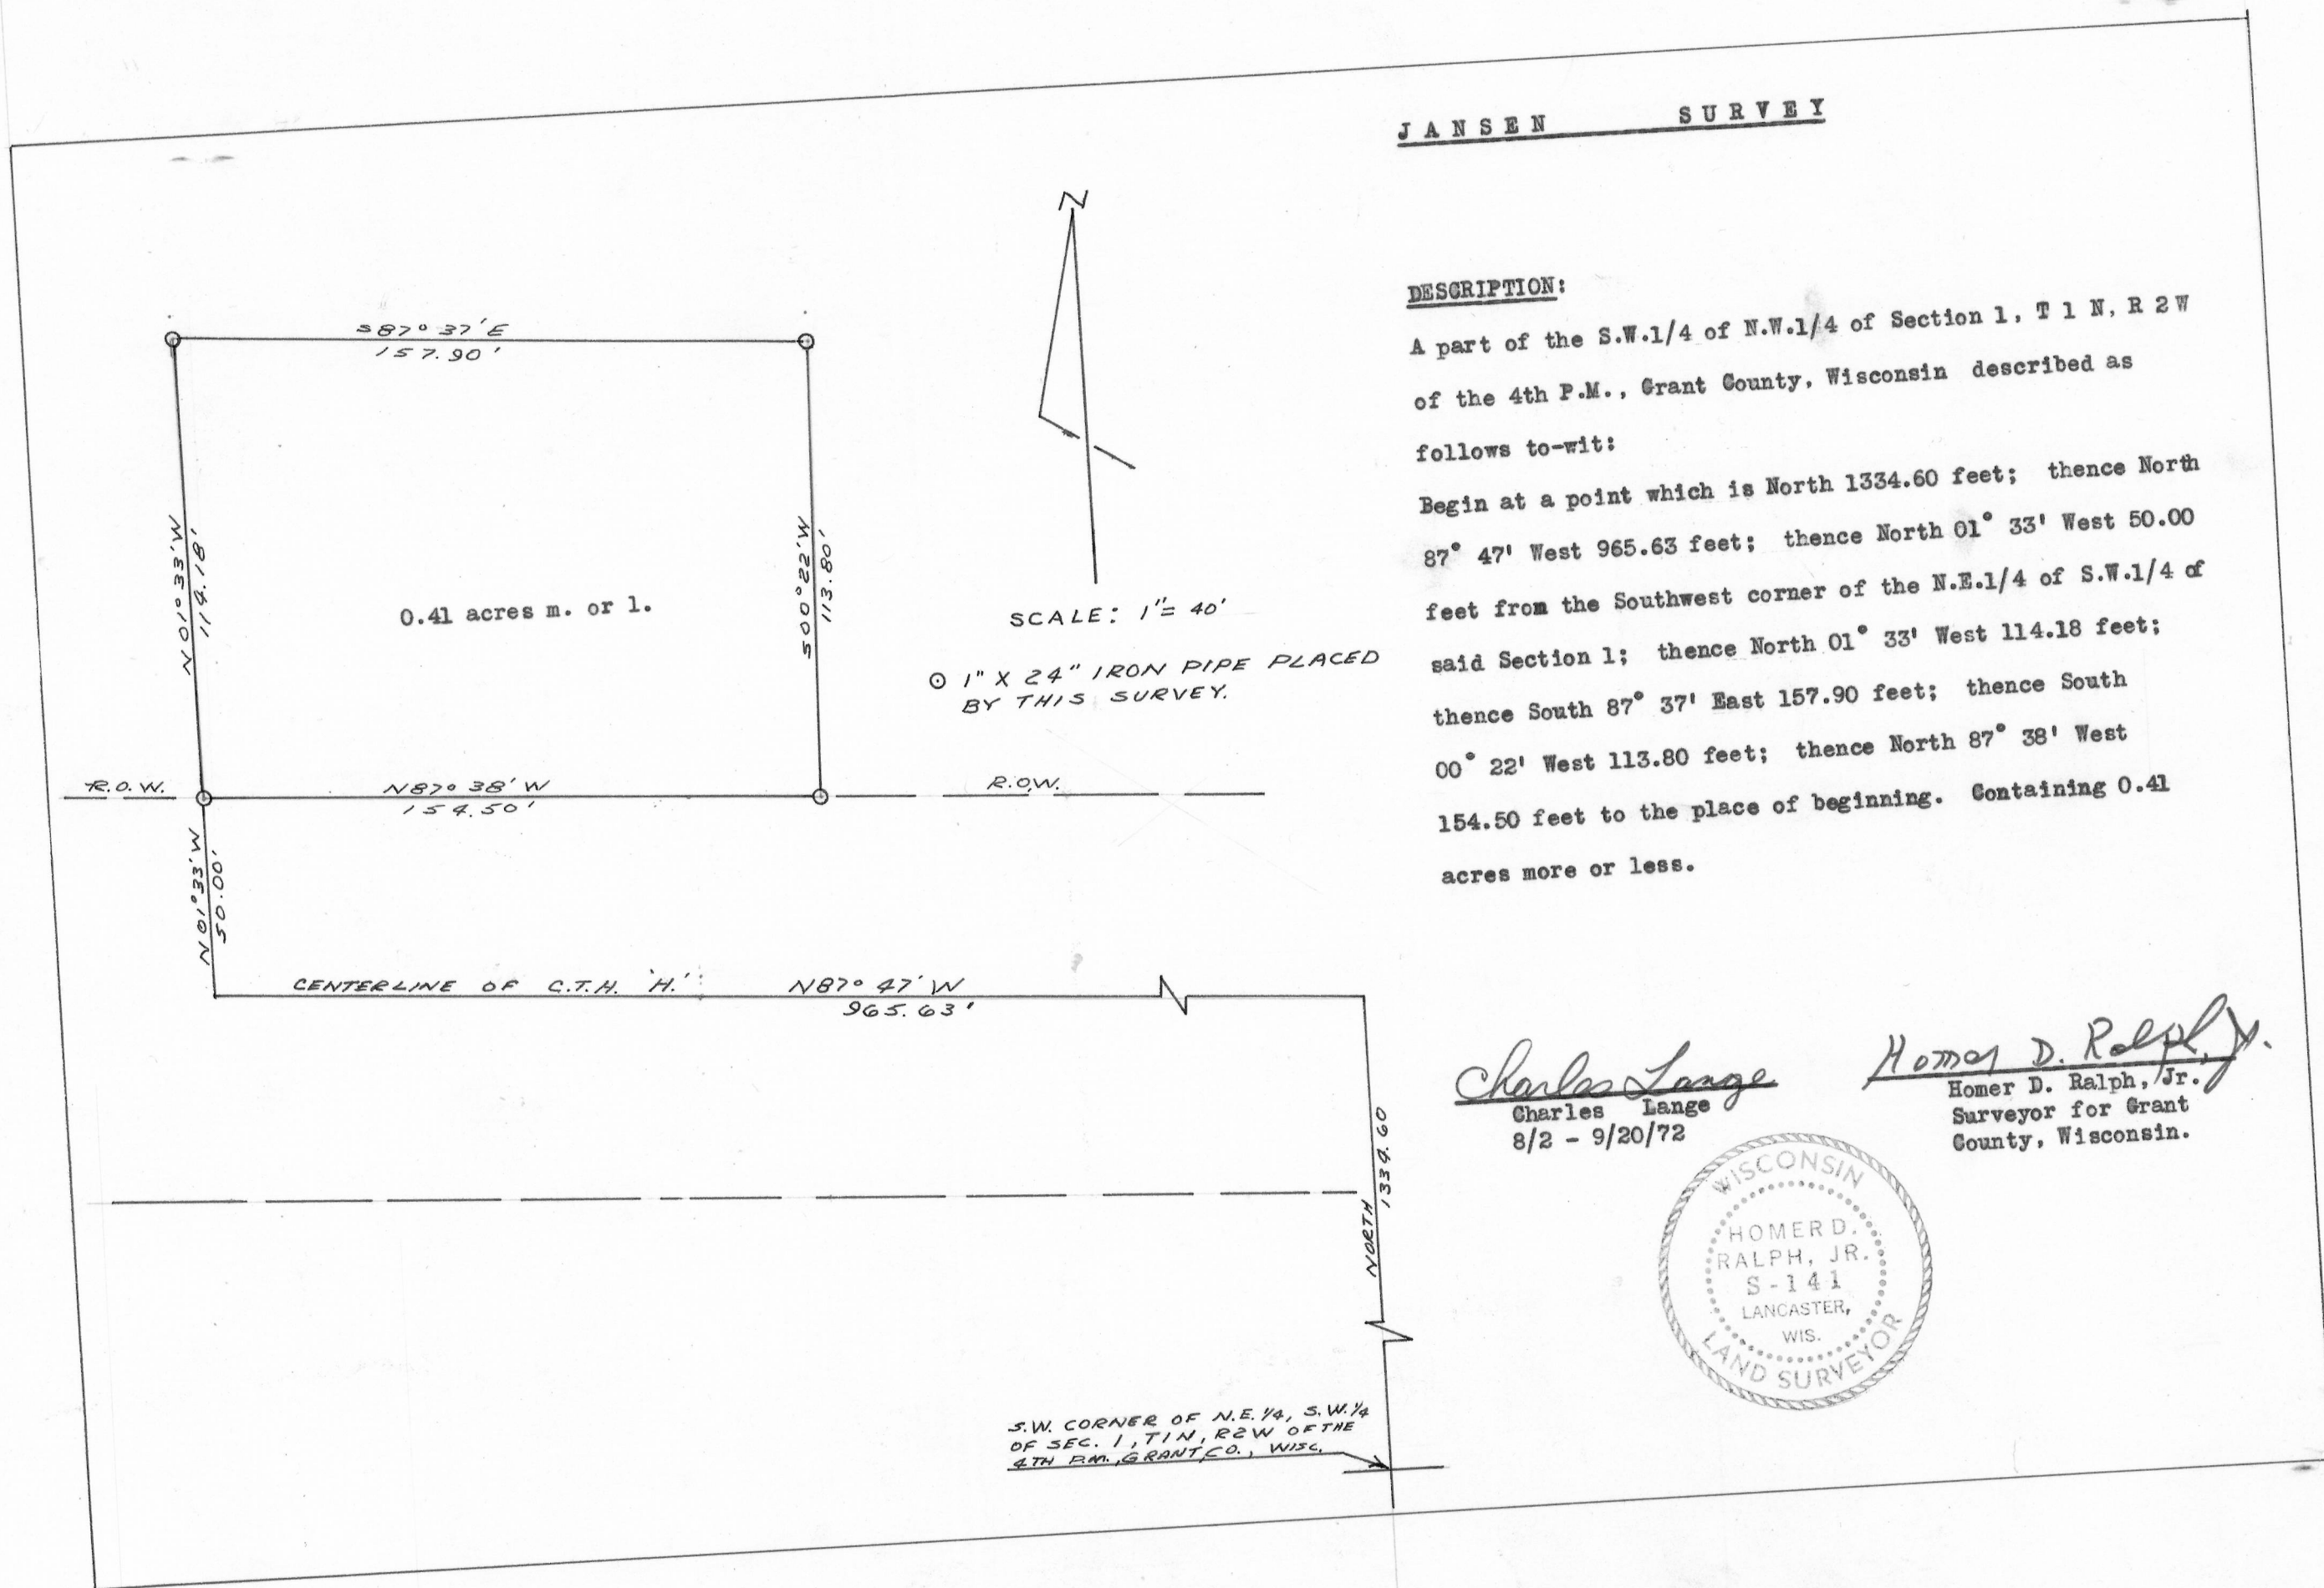

JANSEN SURVEY

DESCRIPTION:

A part of the S.W.1/4 of N.W.1/4 of Section 1, T 1 N, R 2 W of the 4th P.M., Grant County, Wisconsin described as follows to-wit:

Begin at a point which is North 1334.60 feet; thence North 87° 47' West 965.63 feet; thence North 01° 33' West 50.00 feet from the Southwest corner of the N.E.1/4 of S.W.1/4 of said Section 1; thence North 01° 33' West 114.18 feet; thence South 87° 37' East 157.90 feet; thence South 00° 22' West 113.80 feet; thence North 87° 38' West 154.50 feet to the place of beginning. Containing 0.41 acres more or less.

Charles Lange
Charles Lange
8/2 - 9/20/72

Homer D. Ralph, Jr.
Homer D. Ralph, Jr.
Surveyor for Grant
County, Wisconsin.

