

LEE HAYWOOD SURVEY

LEGEND:

- 1"X24" IRON PIPE PLACED BY THIS SURVEY
- P.K. NAIL PLACED BY THIS SURVEY


SCALE: 1" = 60'



Homer D. Ralph, Jr.
 HOMER D. RALPH JR.
 SURVEYOR FOR GRANT
 COUNTY, WISCONSIN

David K. Krohn
 DAVID K. KROHN
 8/6/74 — 10/4/74

N

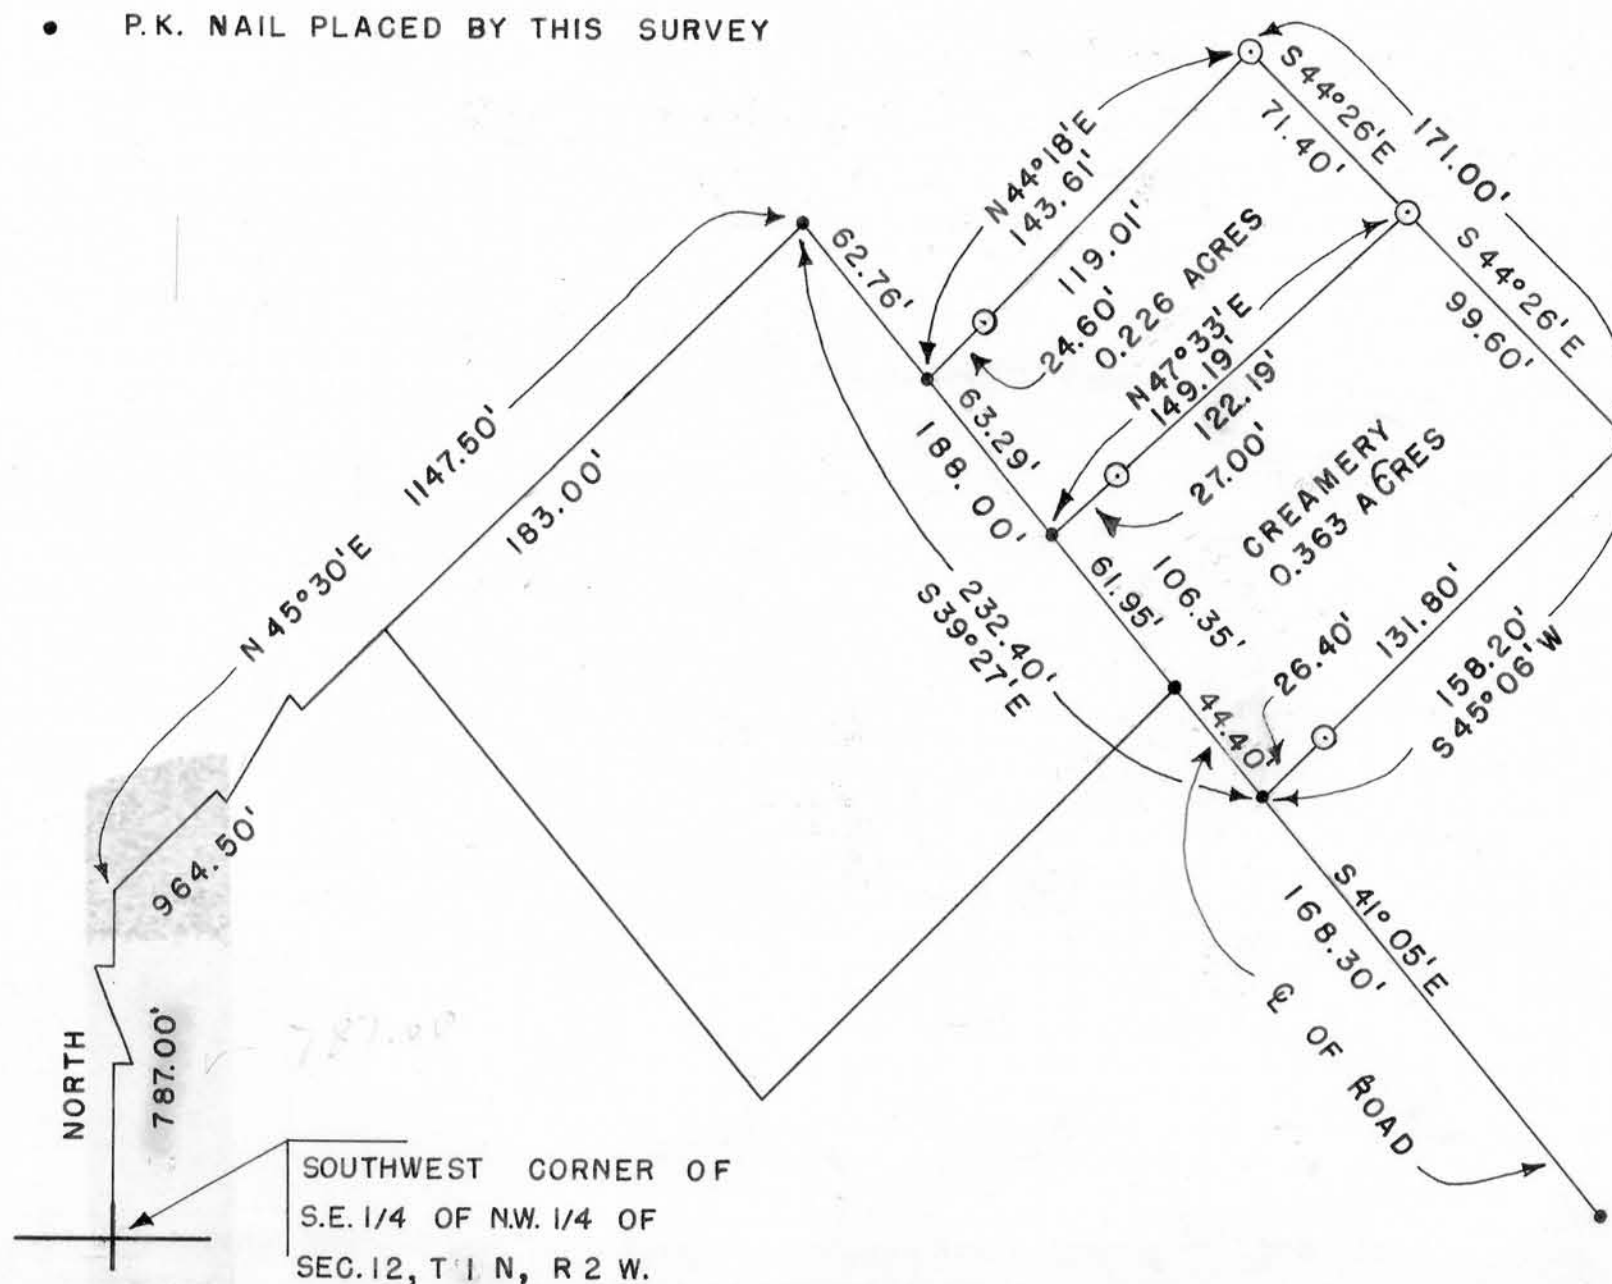

LEE HAYWOOD SURVEY

LEGEND:


- 1"X24" IRON PIPE PLACED BY THIS SURVEY
- P.K. NAIL PLACED BY THIS SURVEY

SCALE: 1" = 60'



Homer D. Ralph, Jr.
HOMER D. RALPH JR.
SURVEYOR FOR GRANT
COUNTY, WISCONSIN

David K. Krohn
DAVID K. KROHN
8/6/74—10/4/74

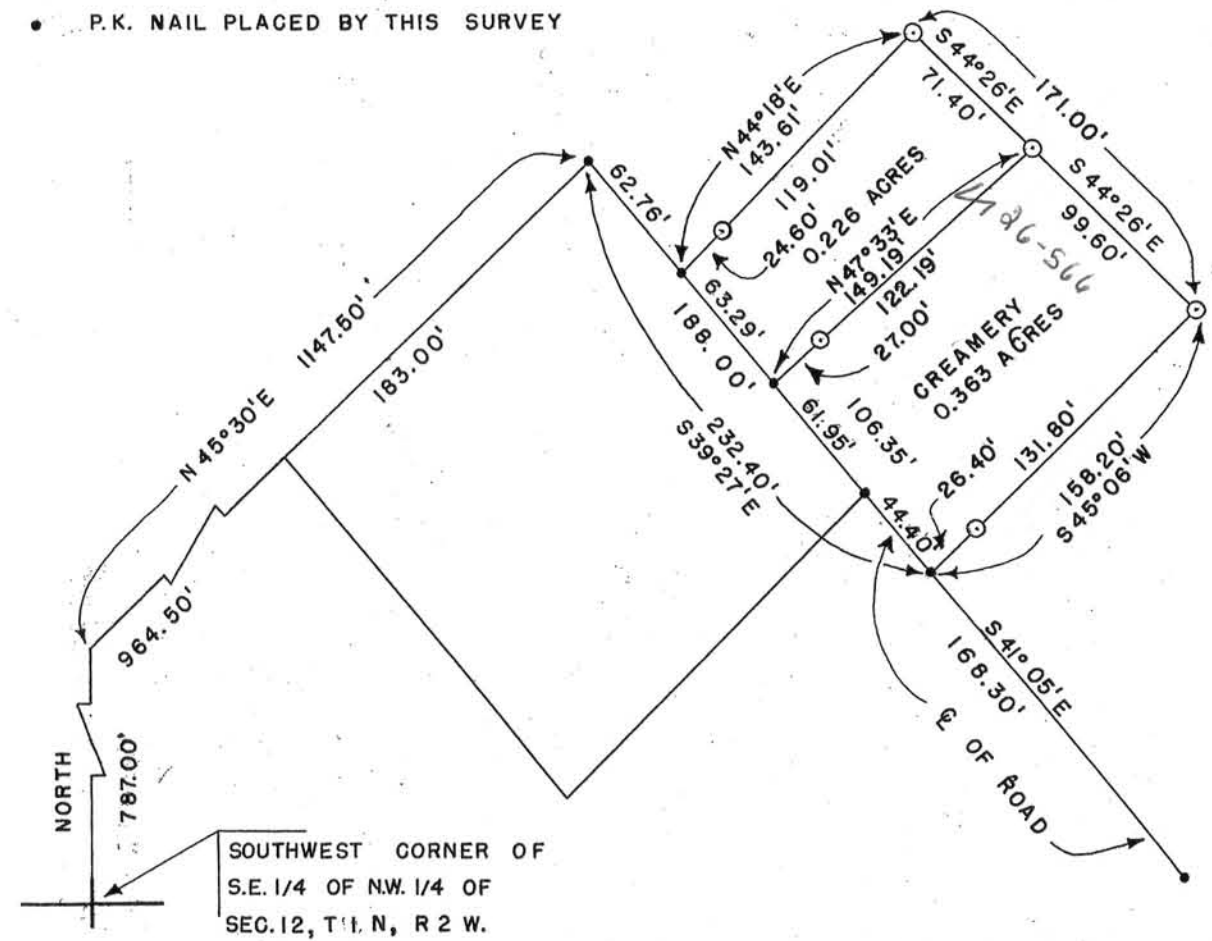

LEE HAYWOOD SURVEY

DESCRIPTION: (TRAILER LOT)

Part of the N.E.1/4 of the N.W.1/4 of Section 12, T 1 N, R 2 W, of the 4th P.M., Grant County, Wisconsin, described as follows to-wit:
Begin at the Southwest corner of the S.E.1/4 of the N.W.1/4 of said Section 12;

thence North 787.00 feet;

thence North 45° 30' East 1147.50 feet to the centerline of town road;

thence South 39° 27' East 62.76 feet along said centerline to the point of beginning;

thence South 39° 27' East 63.29 feet along said centerline;

thence North 47° 33' East 149.19 feet;

thence North 44° 26' West 71.40 feet;

thence South 44° 18' West 143.61 feet to the centerline of town road and the point of beginning.

Containing 0.226 acres more or less inclusive of highway right-of-way.



Homer D. Ralph, Jr.
Homer D. Ralph, Jr.
Surveyor for Grant
County, Wisconsin.

LEE HAYWOOD SURVEY

DESCRIPTION: (CREAMERY)

Part of the N.E.1/4 of the N.W.1/4 of Section 12, T 1 N, R 2 W, of the 4th P.M., Grant County, Wisconsin, described as follows to-wit: Begin at the Southwest corner of the S.E.1/4 of the N.W.1/4 of said Section 12;

thence North 787.00 feet;

thence North 45° 30' East 1147.50 feet to the centerline of town road;

thence South 39° 27' East 126.05 feet along said centerline to the point of beginning;


thence South 39° 27' East 106.35 feet along said centerline;

thence North 45° 06' East 158.20 feet;

thence North 44° 26' West 99.60 feet;

thence South 47° 33' West 149.19 feet to the centerline of town road and the point of beginning.

Containing 0.363 acres more or less inclusive of right-of-way.

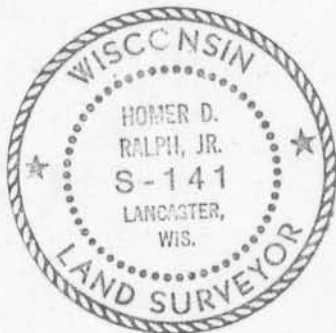

Homer D. Ralph, Jr.
Homer D. Ralph, Jr.
Surveyor for Grant
County, Wisconsin.