


SCHNIEDER-BRANT

SCALE: 1" = 40'

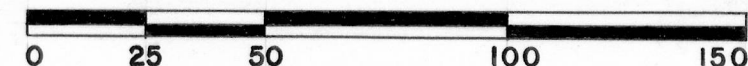

LEGEND:

- ⊙ 1"X 24" IRON PIPE PLACED BY THIS SURVEY
- ⊙ 2"X 30" IRON PIPE PLACED BY THIS SURVEY
- *** FENCE
- X CORNER POST

DESCRIPTION:

Part of the S.E.1/4 of the S.E.1/4 of Section 14, T 1 N, R 2 W, of the 4th P.M., Grant County, Wisconsin, described as follows to-wit: Begin at the Southwest corner of the S.E.1/4 of the N.E.1/4 of said Section 14;

thence South 2469.46 feet to the point of beginning;



thence South 170.54 feet;

thence East 175.00 feet;

thence North 170.54 feet;

thence West 175.00 feet to the point of beginning.

Containing 0.62 acres more or less exclusive of right-of-way.

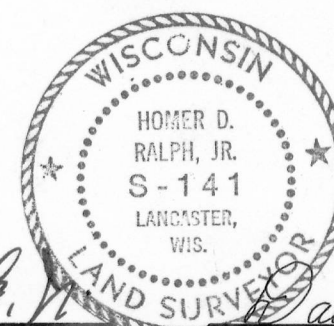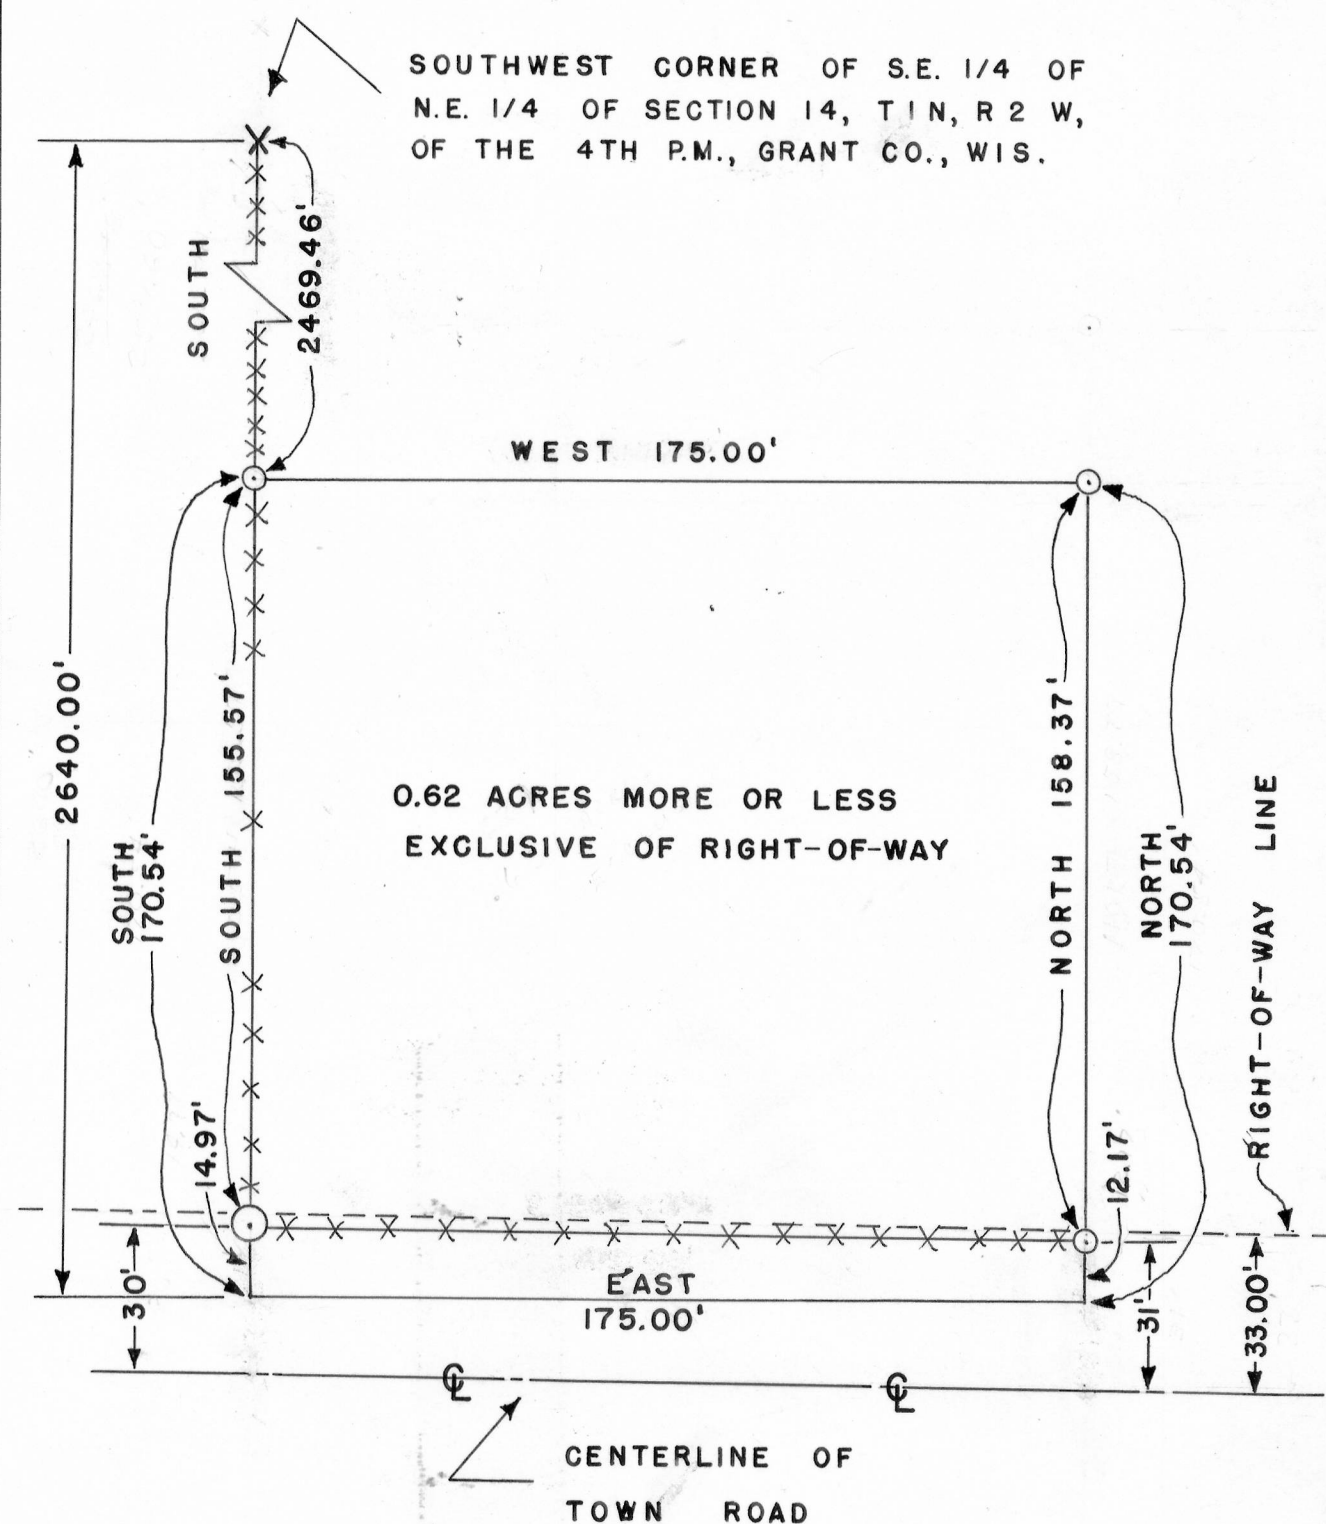

Homer D. Ralph, Jr.

HOMER D. RALPH JR.
SURVEYOR FOR GRANT
COUNTY, WISCONSIN

David K. Krohn

DAVID K. KROHN
8/7/74 - 8/15/74