



SCHNEE SURVEY

SCALE 1" = 40'

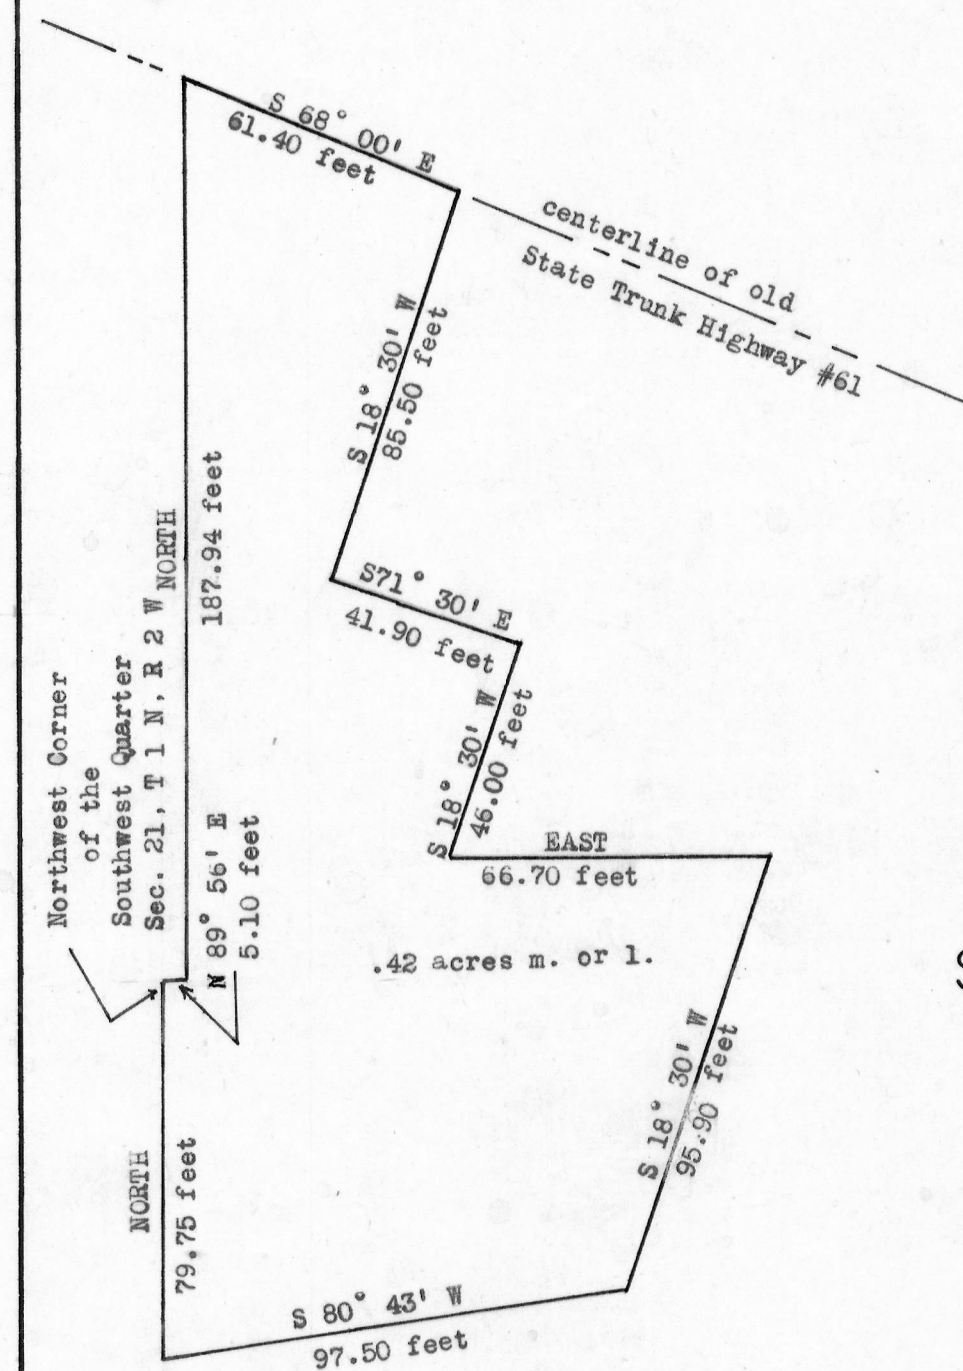

DESCRIPTION: A part of the N.W. 1/4 of the S.W. 1/4 and A part of the S.W. 1/4 of the N.W.1/4 of Section 21, T 1 N, R 2 W, of the 4th P.M., Grant County, Wisconsin described as follows, to witt: Begin at the Northwest Corner of the Southwest Quarter of said Section 21; thence North 89° 56' East 5.10 feet; thence North 187.94 feet; thence South 68° 00' East 61.40 feet along the centerline of old State Trunk Highway #61; thence South 18° 30' West 85.50 feet; thence South 71° 30' East 41.90 feet; thence South 18° 30' West 46.00 feet; thence East 66.70 feet; thence South 18° 30' West 95.90 feet; thence South 80° 43' West 97.50 feet; thence North 79.75 feet to the point of beginning. Contaning .42 acres more or less.

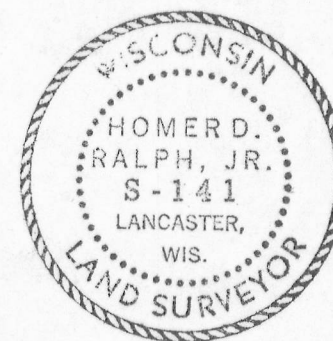

Charles Lange
Charles Lange
6/13-7/14/72

Homer D. Ralph, Jr.
Homer D. Ralph, Jr.
Surveyor for Grant
County, Wisconsin.