


RALPH TRITSCH SURVEY

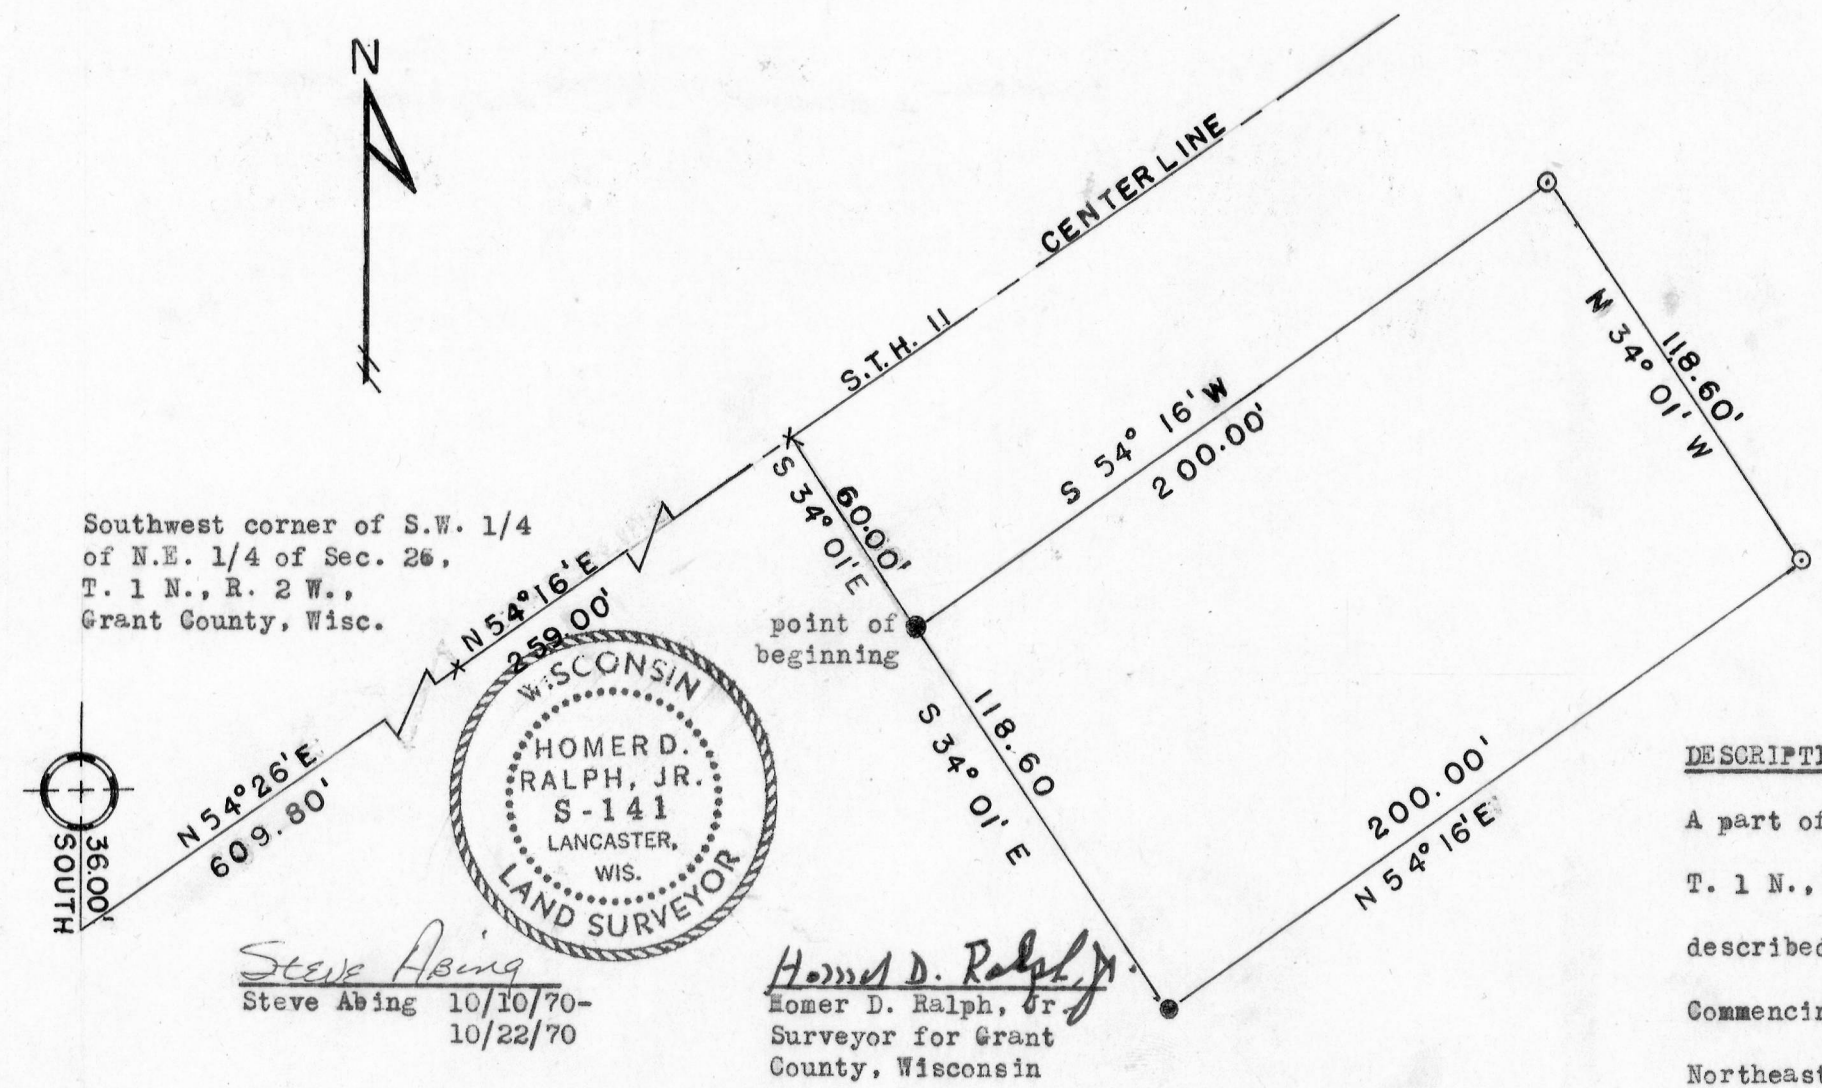

SCALE:
0 25 50 100
1" = 50 FT.

- ⊙ 1" X 24" IRON PIPE PLACED BY THIS SURVEY.
- 1" X 24" IRON PIPE PLACED BY PREVIOUS SURVEY.
- × MARK ON PAVEMENT

DESCRIPTION:

A part of the Southwest 1/4 of the Northeast 1/4 of Section 26, T. 1 N., R. 2 W., of the 4 th. P.M., Grant County, Wisconsin, described as follows, to-wit;

Commencing at the Southwest corner of the Southwest 1/4 of the Northeast 1/4 of said Section 26; thence South 36.00 feet; thence North 54° 26' East 609.80 feet along the centerline of State Trunk Highway #11; thence North 54° 16' East 259.00 feet along said centerline; thence South 34° 01' East 60.00 feet to point of beginning; thence South 34° 01' East 118.60 feet; thence North 54° 16' East 200.00 feet; thence North 34° 01' West 118.60 feet; thence South 54° 16' West 200.00 feet along the southern right-of-way of State Trunk Highway #11 to the point of beginning.