



DONAR SURVEY

SCALE: 1" = 80'

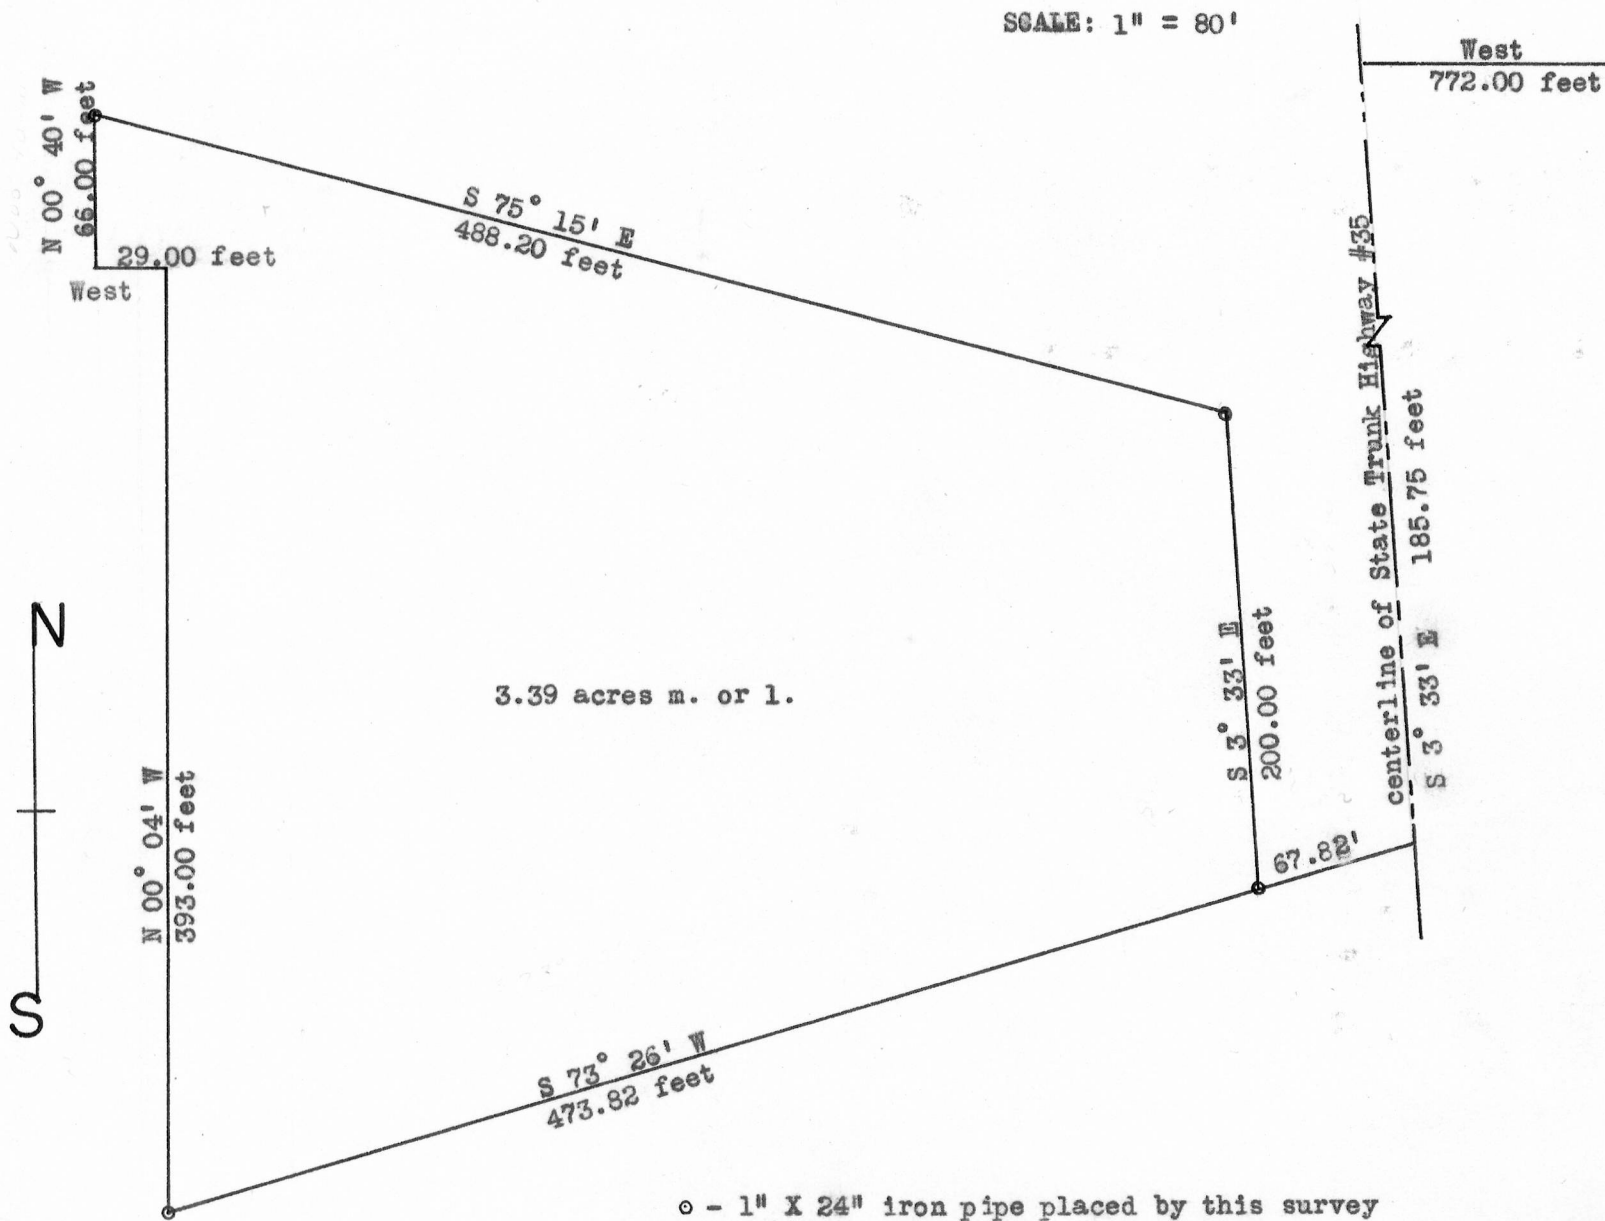

Ralph Bourret
Ralph Bourret
7/6-7/20/72

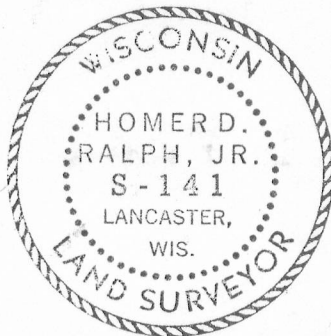

Homer D. Ralph, Jr.
Homer D. Ralph, Jr.
Surveyor for Grant
County, Wisconsin.