


N.W. CORNER
N.W. 1/4, S.E. 1/4,
SEC. 19-2-2

PICKEL SURVEY

SCALE: 1" = 40'

1" x 24" IRON PIPE PLACED BY THIS SURVEY

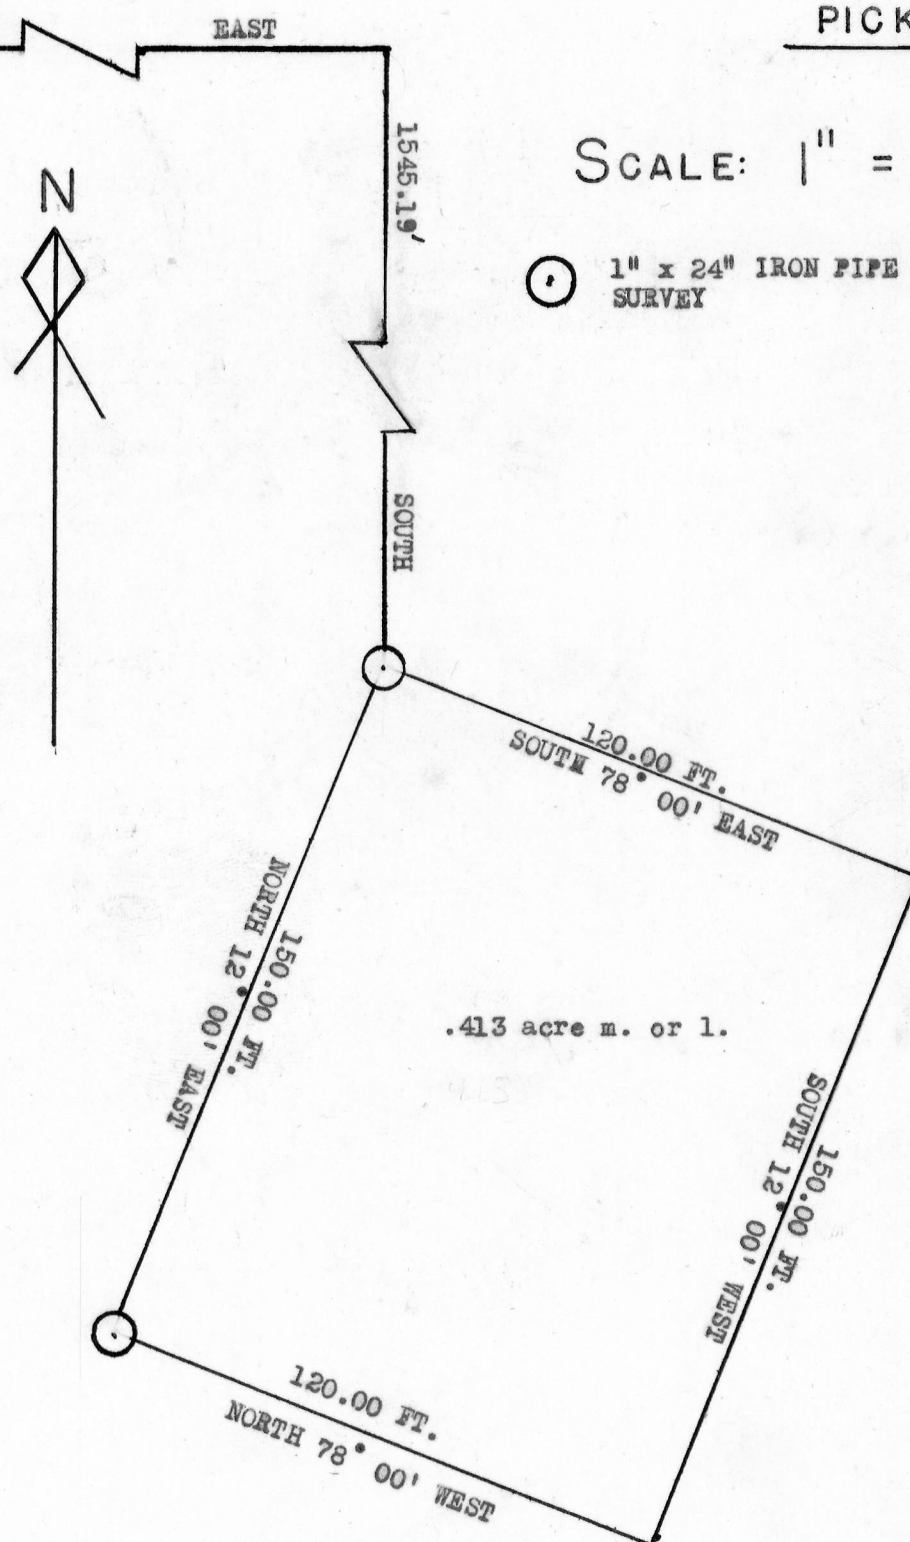

DESCRIPTION:

Part of the S.W. 1/4 of the S.E. 1/4 of Section 19, T 2 N, R 2 W, of the 4th P.M., Grant County, Wisconsin described as follows, to-wit: Begin at a point which is East 253.23 feet and South 1545.19 feet of the center of said section 19; thence South 78° 00' East 120.00 feet; thence South 12° 00' West 150.00 feet; thence North 78° 00' West 120.00 feet; thence North 12° 00' East 150.00 feet to point of beginning. Containing .413 acre more or less.

Charles Lange
Charles Lange
4/2/71 - 4/5/71

David Krohn
Dave Krohn
4/2/71 - 4/5/71

Homer D. Ralph, Jr.
Homer D. Ralph, Jr.
Surveyor for Grant Co., Wis.

