


WEBER SURVEY



SCALE

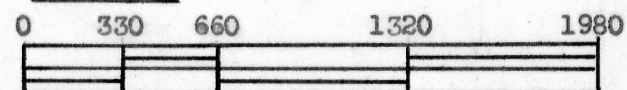


1" = 660'

LEGEND

- 1"X 24" Iron Pipe Placed By This Survey
- 1"X 24" Iron Pipe Placed In Center of Platte River

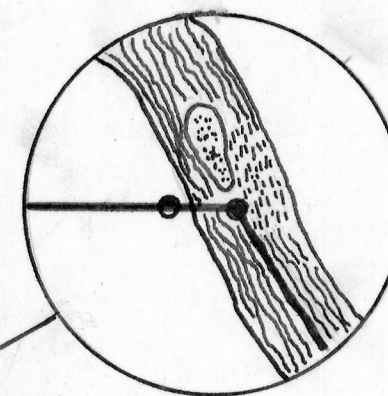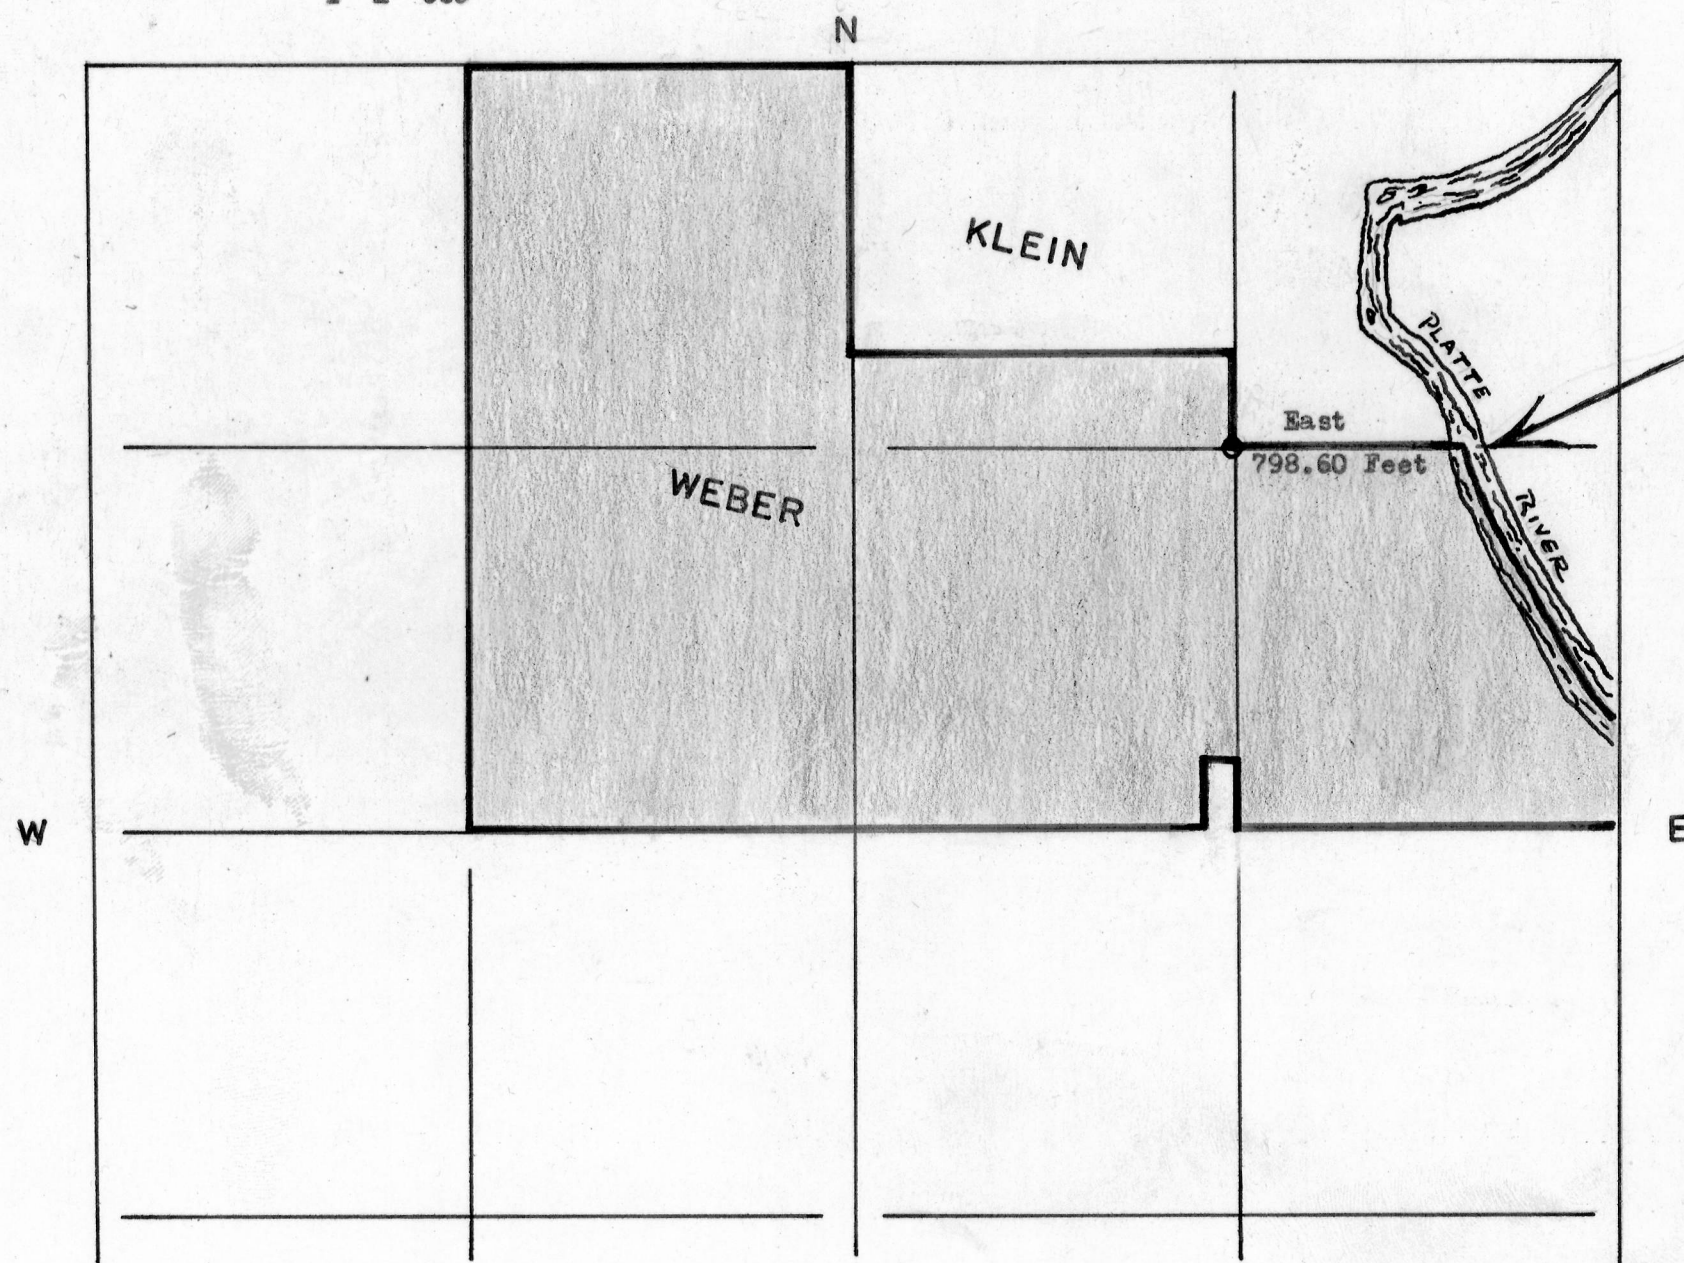

Drawing of the North 3/4 of Section 18, T 3 N, R 2 W, of the 4th P.M. in Grant County, Wisconsin, showing the location of the monuments placed by this survey.

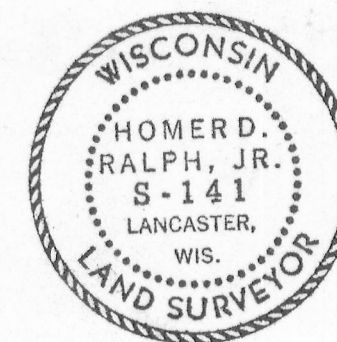

Charles Lange
Charles Lange
6/14/71 - 6/25/71

Homer D. Ralph, Jr.
Homer D. Ralph, Jr.
Surveyor for Grant
County, Wisconsin