


MITCHELL SURVEY


SCALE: 1" = 50'

○ 1" X 24" PIPE PLACED BY THIS SURVEY

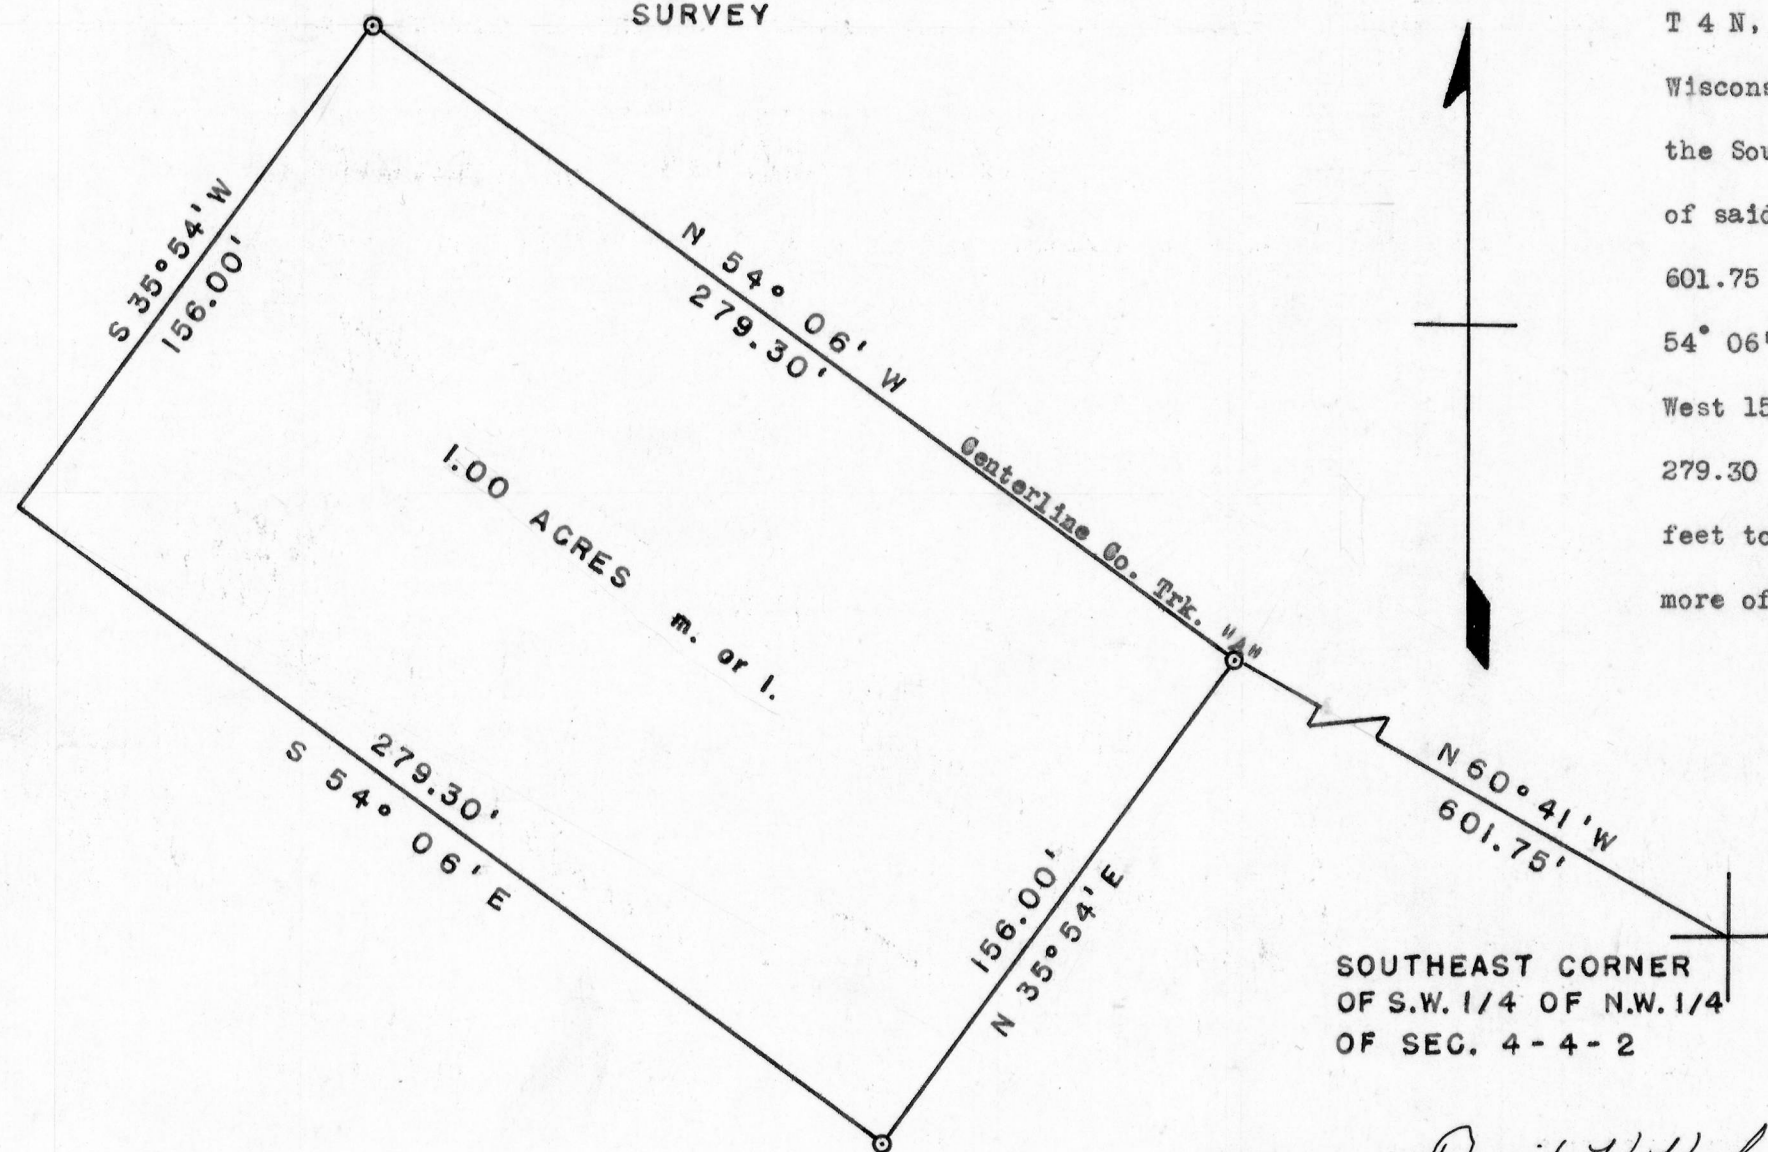

DESCRIPTION

A part of the S.W.1/4 of the N.W.1/4 of Section 4, T 4 N, R 2 W, of the 4th P.M., Grant County, Wisconsin, described as follows to-wit: Begin at the Southeast corner of the S.W.1/4 of the N.W.1/4 of said Section 4; thence North 60° 41' West 601.75 feet to point of beginning; thence North 54° 06' West 279.30 feet; thence South 35° 54' West 156.00 feet; thence South 54° 06' East 279.30 feet; thence North 35° 54' East 156.00 feet to point of beginning. Containing 1.00 acres more or less.

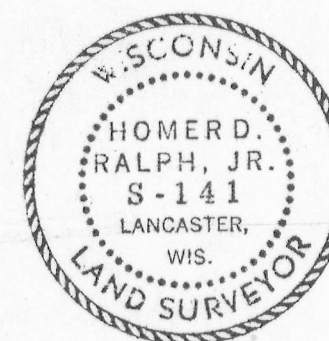

SOUTHEAST CORNER
OF S.W. 1/4 OF N.W. 1/4
OF SEC. 4-4-2

David K. Krohn
David Krohn
9/7/71 - 9/11/71

Homer D. Ralph, Jr.
Homer D. Ralph, Jr.
Surveyor for Grant
County, Wisconsin