


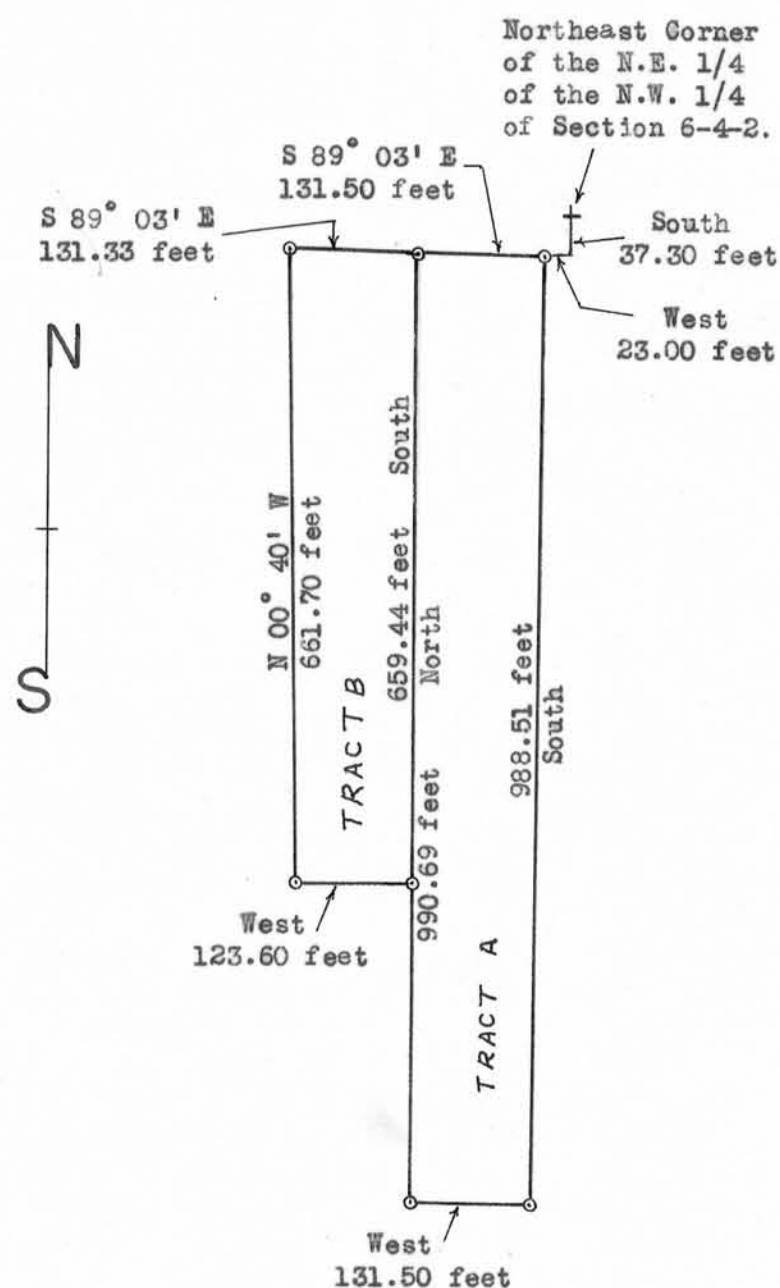

○ - 1" X 24" Iron pipe placed by this survey.

LENZ SURVEY

SCALE 1" = 200'

DESCRIPTION of TRACT A:

A part of the N.E. 1/4 of the N.W. 1/4 of Section 6, T 4 N, R 2 W, of the 4th P.M., Grant County, Wisconsin, described as follows, to-wit:

Begin at a point which is 37.30 feet South and 23.00 feet West of the Northeast Corner of said N.E. 1/4 of the N.W. 1/4; thence South 988.51 feet; thence West 131.50 feet; thence North 990.69 feet to the right-of-way of Co. Trk. Hwy. "A"; thence South 89° 03' East along said right-of-way to the point of beginning.

Containing 2.99 acres more or less.


DESCRIPTION of TRACT B:

A part of the N.E. 1/4 of the N.W. 1/4 of Section 6, T 4 N, R 2 W, of the 4th P.M., Grant County, Wisconsin, described as follows, to-wit:


Commence at the Northeast Corner of said N.E. 1/4 of the N.W. 1/4; thence South 37.30 feet; thence West 23.00 feet; thence North 89° 03' West 131.50 feet to the place of beginning; thence South 659.44 feet; thence West 123.60 feet; thence North 00° 40' West 661.70 feet to the right-of-way of Co. Trk. Hwy "A"; thence South 89° 03' East 131.33 feet along said right-of-way to the place of beginning.

Containing 1.93 acres more or less.

Ralph Bourret
Ralph Bourret
7/10-7/12/73

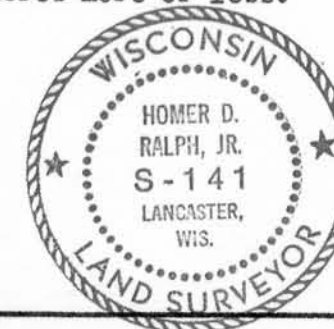

Homer D. Ralph, Jr.
Homer D. Ralph, Jr.
Surveyor for Grant
County, Wisconsin.

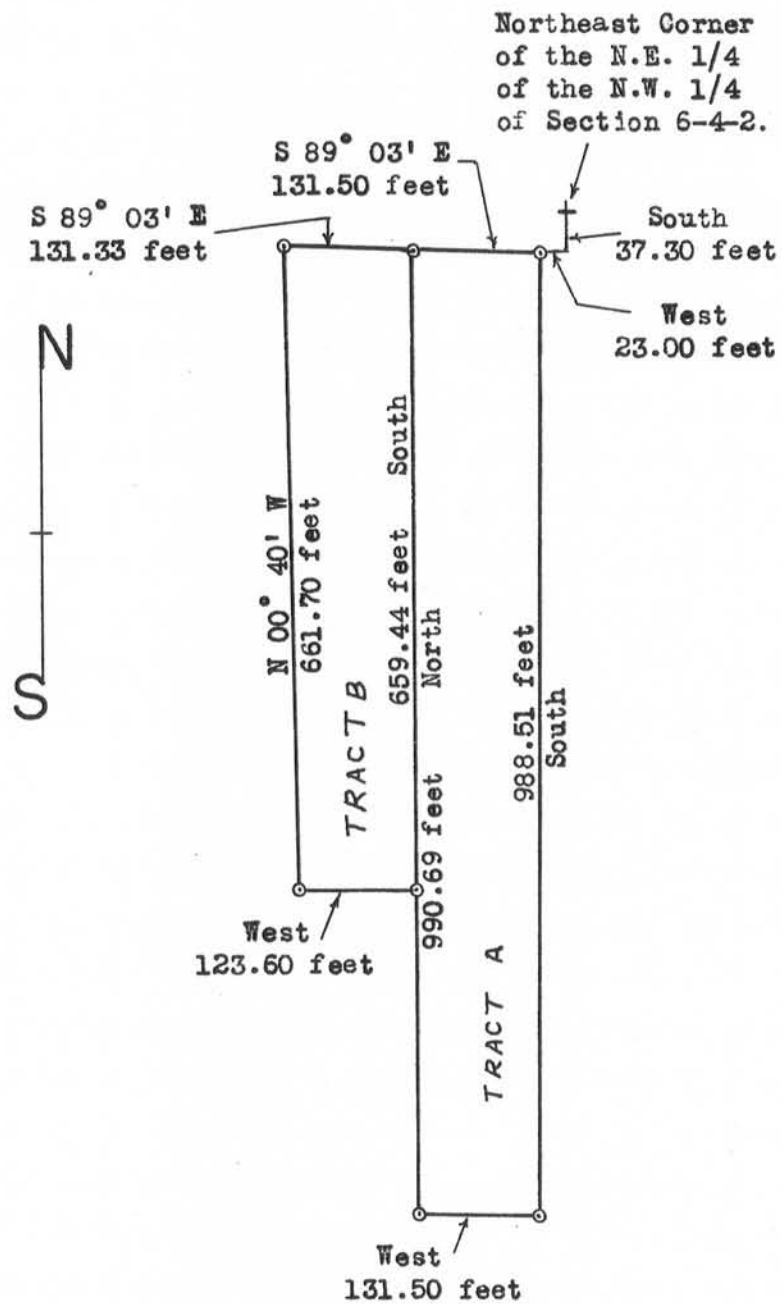

o - 1" X 24" Iron pipe placed by this survey.