


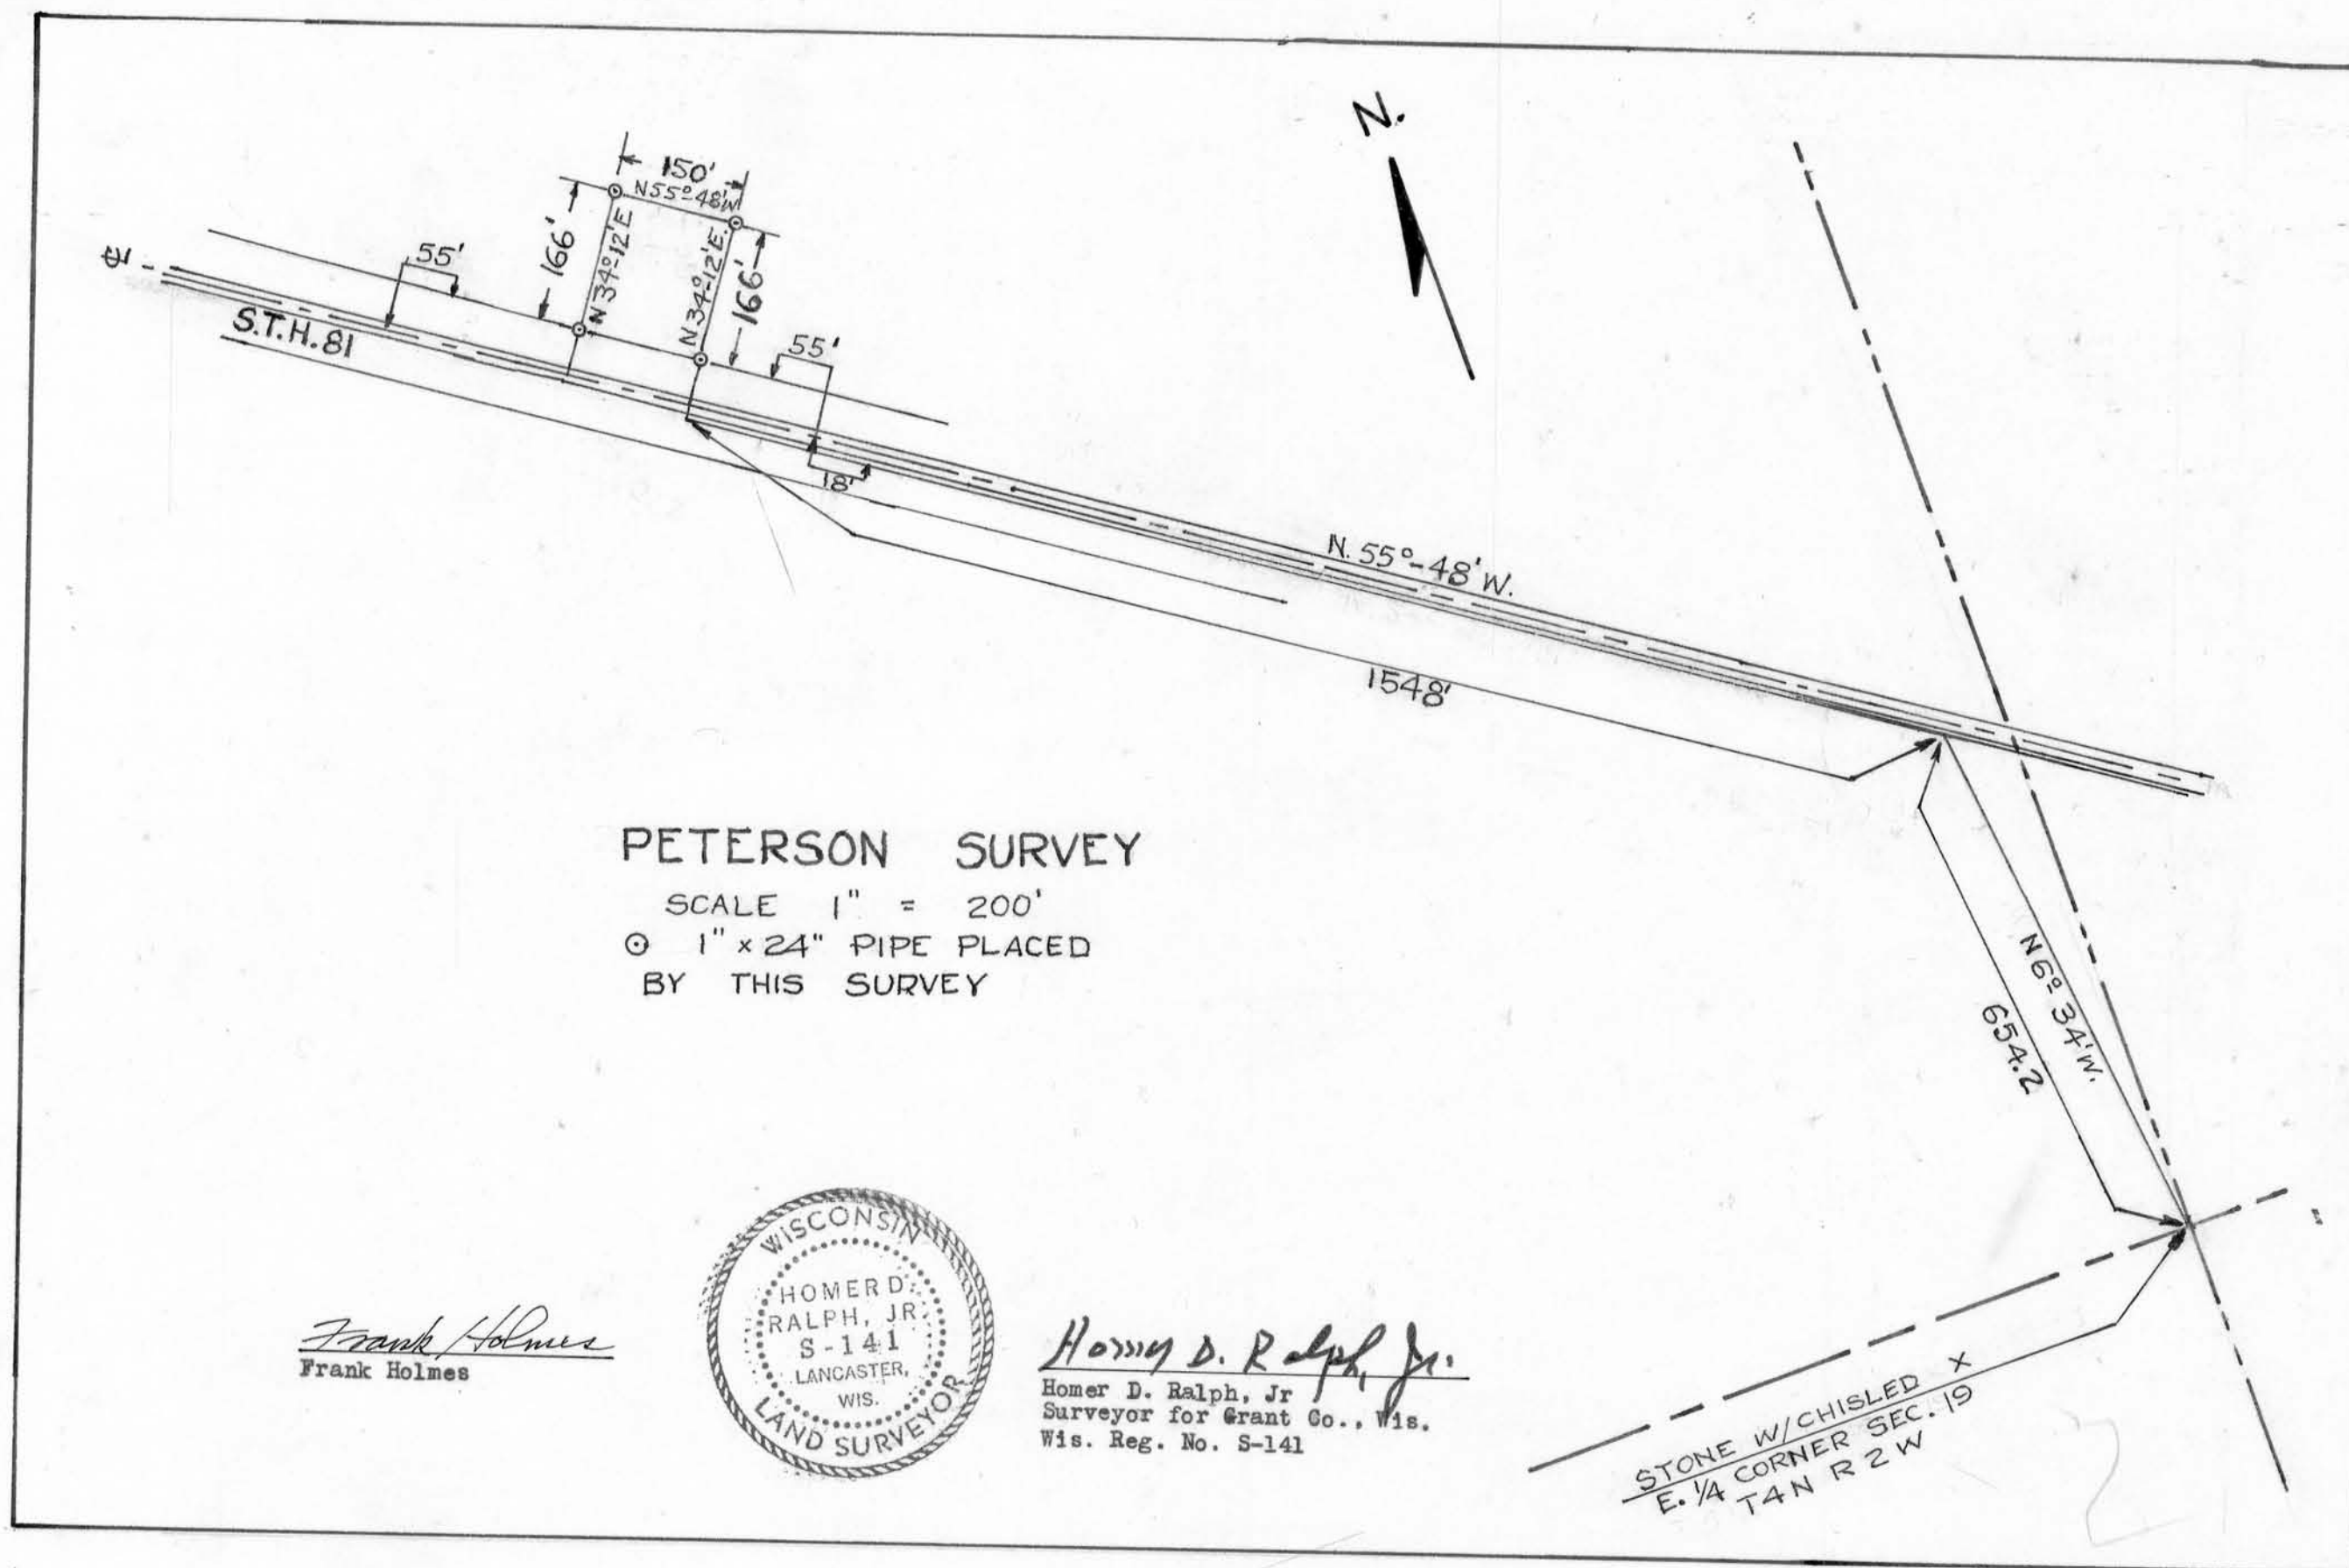

DESCRIPTION OF PETERSON LANDS:

A part of the North 1/2 of N.E.1/4 of Section 19, T 4 N, R 2 W. of the 4th P.M., Grant County, Wisconsin, described as follows, to-wit: Commence at the East Quarter corner of said Section 19; thence North 06° 34' West 654.20 feet to a point on the State Trunk Highway #81; thence North 55° 48' West 1548.00 feet along said Highway; thence North 34° 12' East 73.00 feet to a point on the Northerly Right-of-way of said Highway and the place of beginning; thence North 55° 48' West 150.00 feet along said Right-of-way; thence North 34° 12' East 166.00 feet; thence South 55° 48' East 150.00 feet; thence South 34° 12' West 166.00 feet to the place of beginning. Containing .57 acres, more or less.