


DANHOF — ELLENBORO TOWNSHIP SURVEY

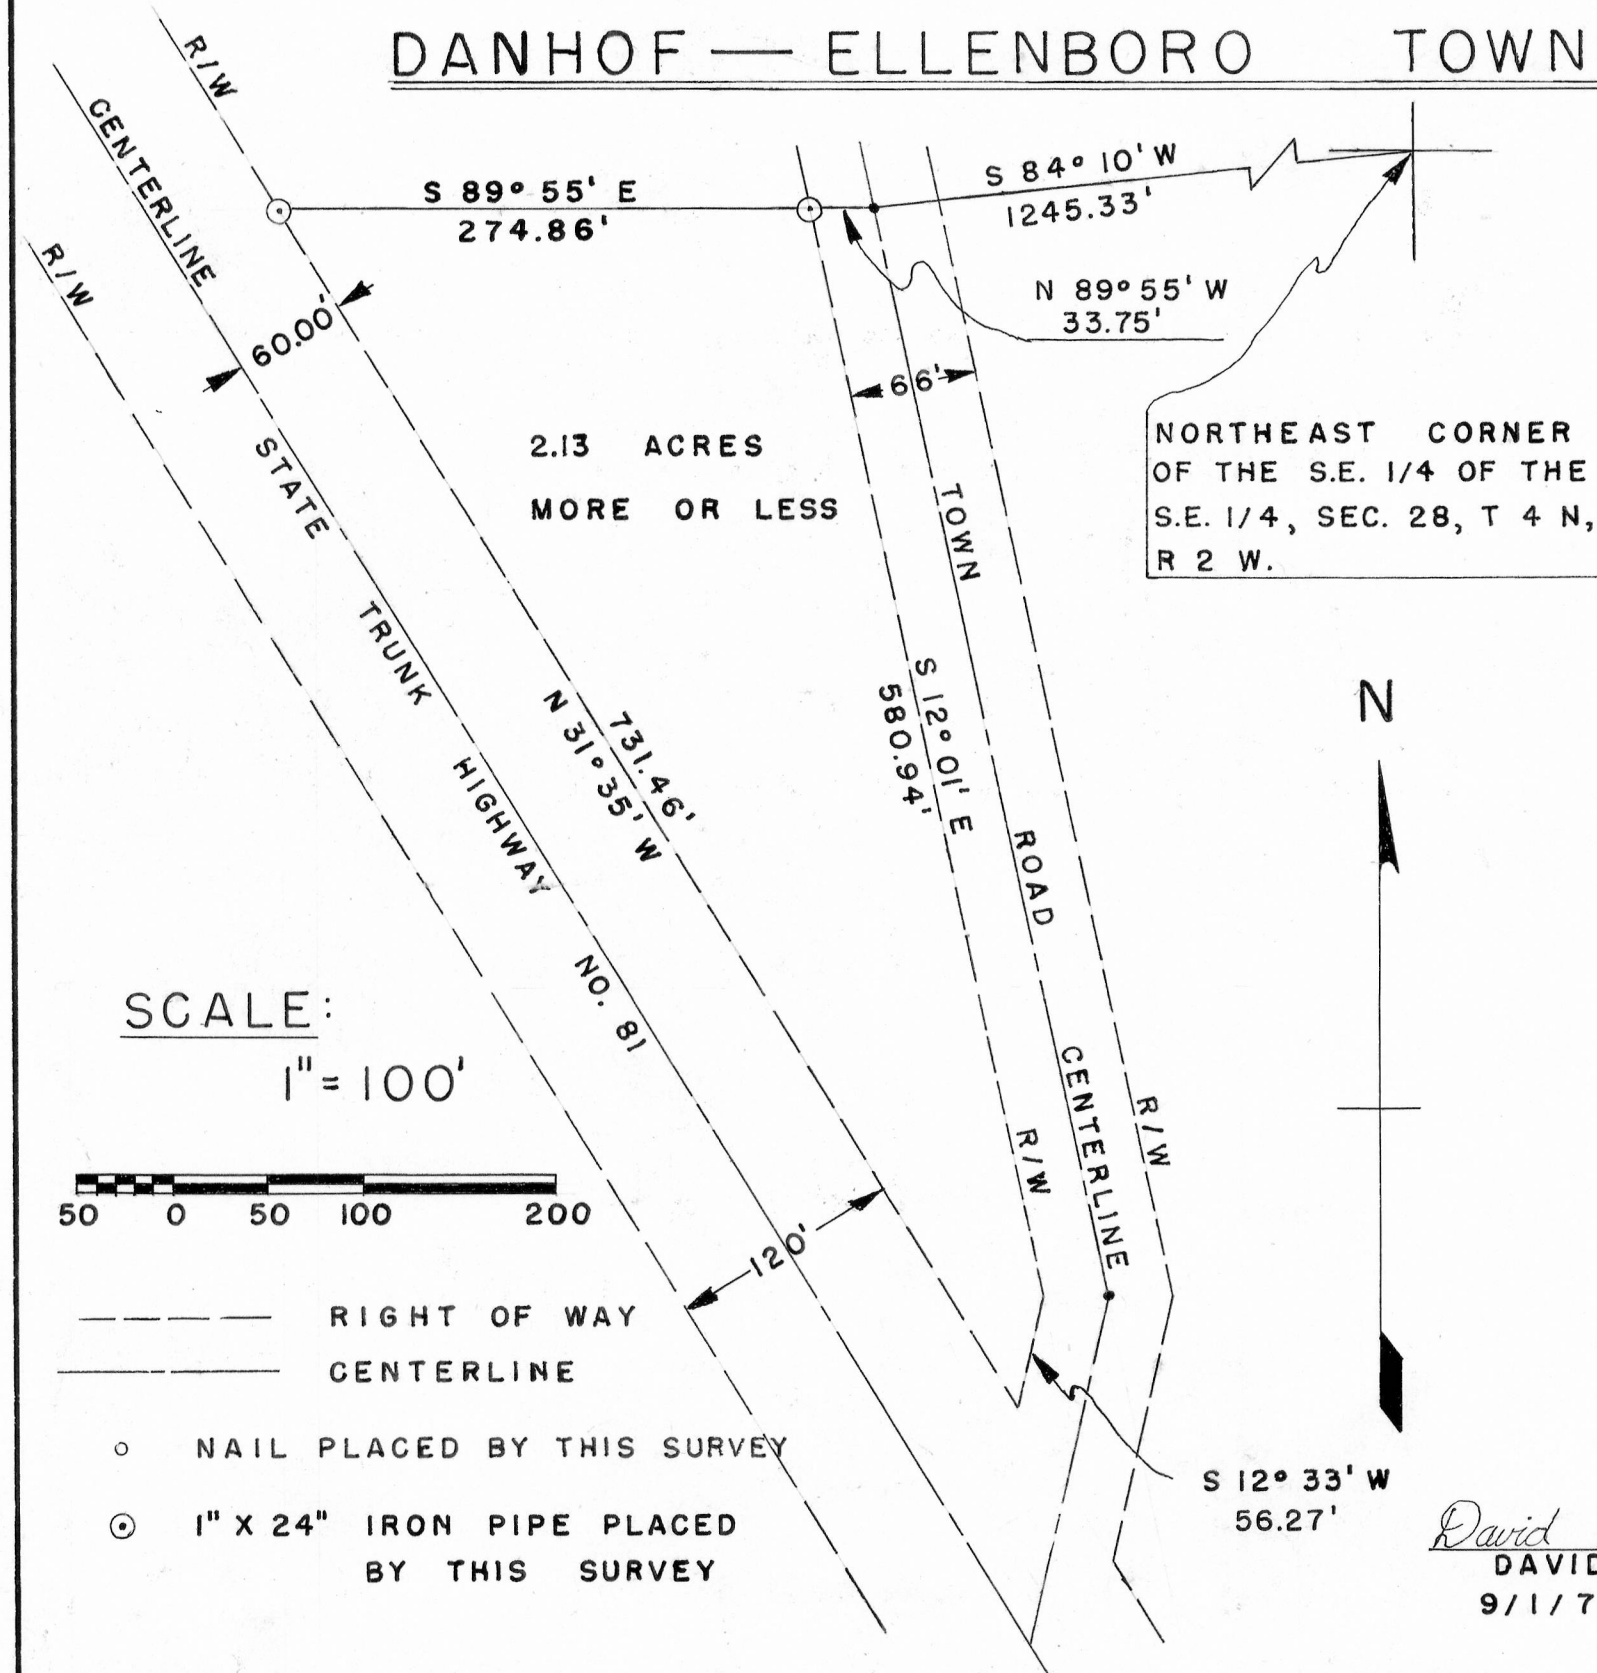


DESCRIPTION:

A part of the S. 1/2 of the S.E. 1/4 of Section 28, T 4 N, R 2 W, of the 4th P.M., Grant County, Wisconsin, described as follows to-wit:

Begin at the Northeast Corner of the S.E. 1/4 of the S.E. 1/4 of said Section 28; thence South 84° 10' West 1245.33 feet to the centerline of town road; thence North 89° 55' West 33.75 feet to the Westerly right-of-way of said town road and the point of beginning;

thence South 12° 01' East 580.94 feet along said westerly right-of-way of town road; thence South 12° 33' West 56.27 feet along said westerly right-of-way of town road to the easterly right-of-way of State Trunk Highway #81; thence North 31° 35' West 731.46 feet along said easterly right-of-way of S.T.H. #81; thence South 89° 55' East 274.86 feet to the westerly right-of-way of town road and the point of beginning. Containing 2.13 acres more or less.

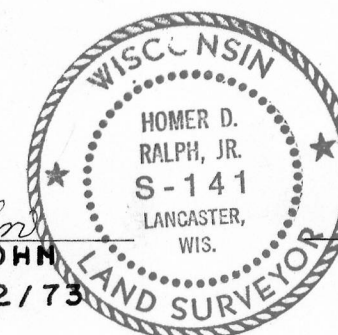

David K. Krohn
DAVID K. KROHN
9/1/73 - 9/12/73

Homer D. Ralph, Jr.
HOMER D. RALPH, JR.,
SURVEYOR FOR GRANT
COUNTY, WISCONSIN.