

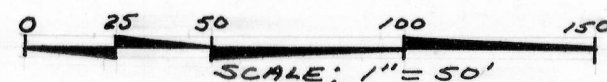


RICHARD KETTERER SURVEY

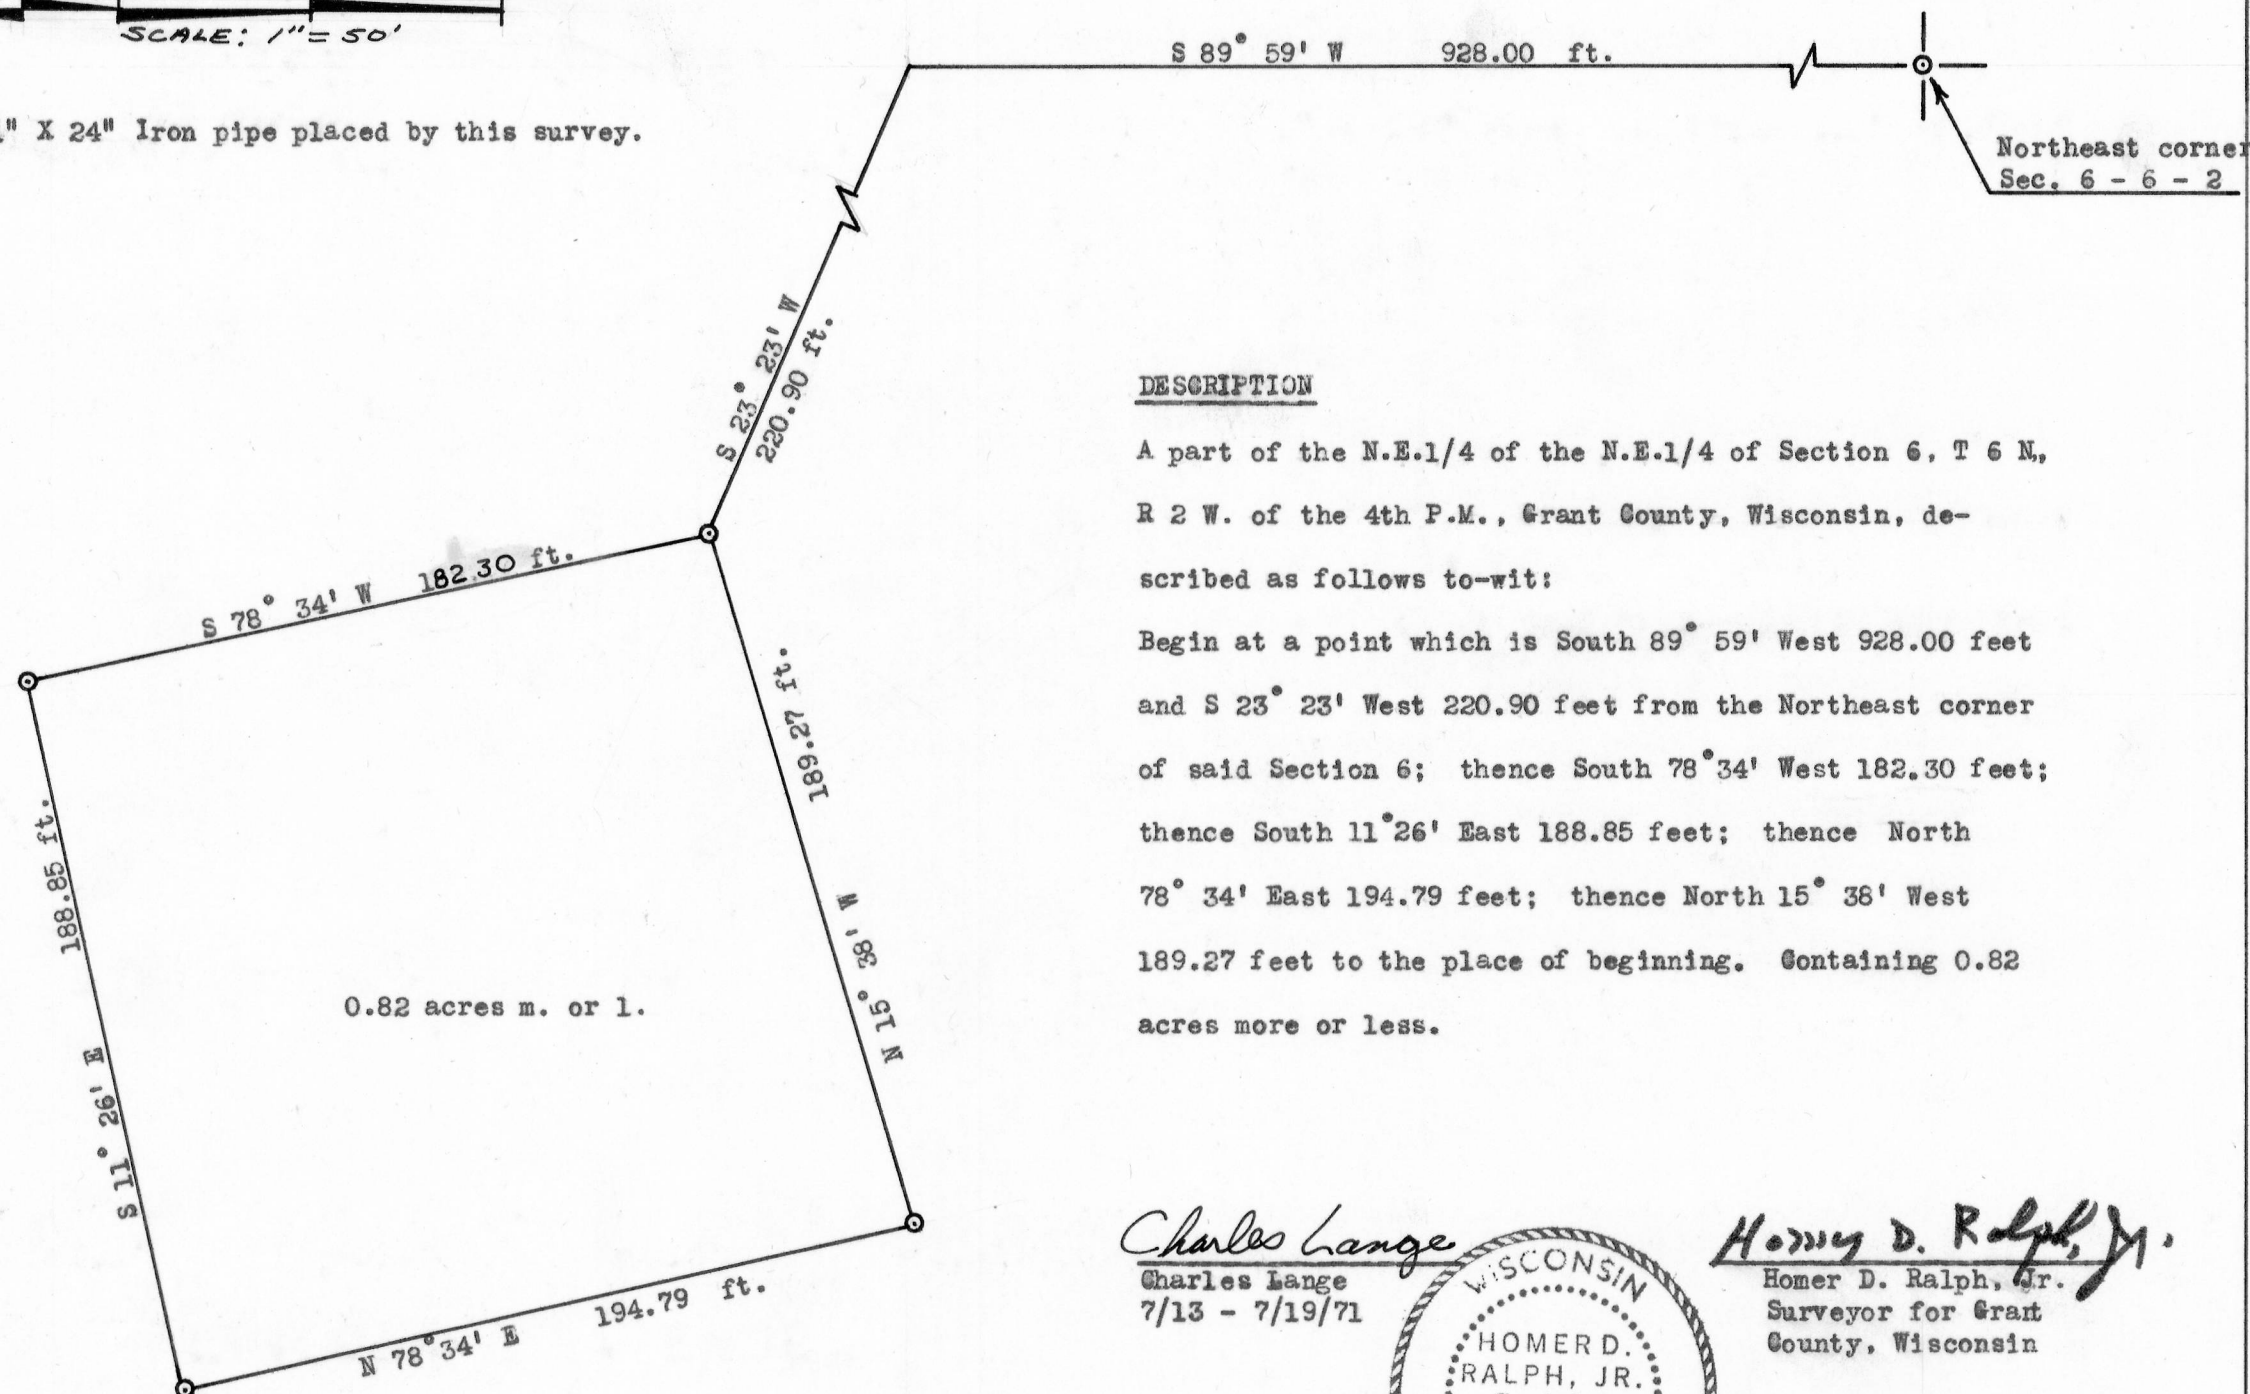

○ 1" X 24" Iron pipe placed by this survey.

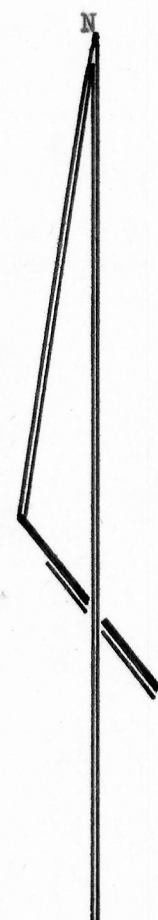


DESCRIPTION

A part of the N.E.1/4 of the N.E.1/4 of Section 6, T 6 N, R 2 W. of the 4th P.M., Grant County, Wisconsin, described as follows to-wit:

Begin at a point which is South 89° 59' West 928.00 feet and S 23° 23' West 220.90 feet from the Northeast corner of said Section 6; thence South 78° 34' West 182.30 feet; thence South 11° 26' East 188.85 feet; thence North 78° 34' East 194.79 feet; thence North 15° 36' West 189.27 feet to the place of beginning. Containing 0.82 acres more or less.

Charles Lange
Charles Lange
7/13 - 7/19/71

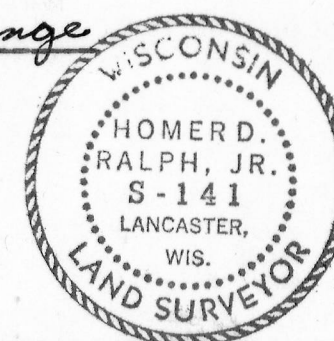

Homer D. Ralph, Jr.
Homer D. Ralph, Jr.
Surveyor for Grant
County, Wisconsin