


VOLKMANN SURVEY

SCALE: 1" = 40'

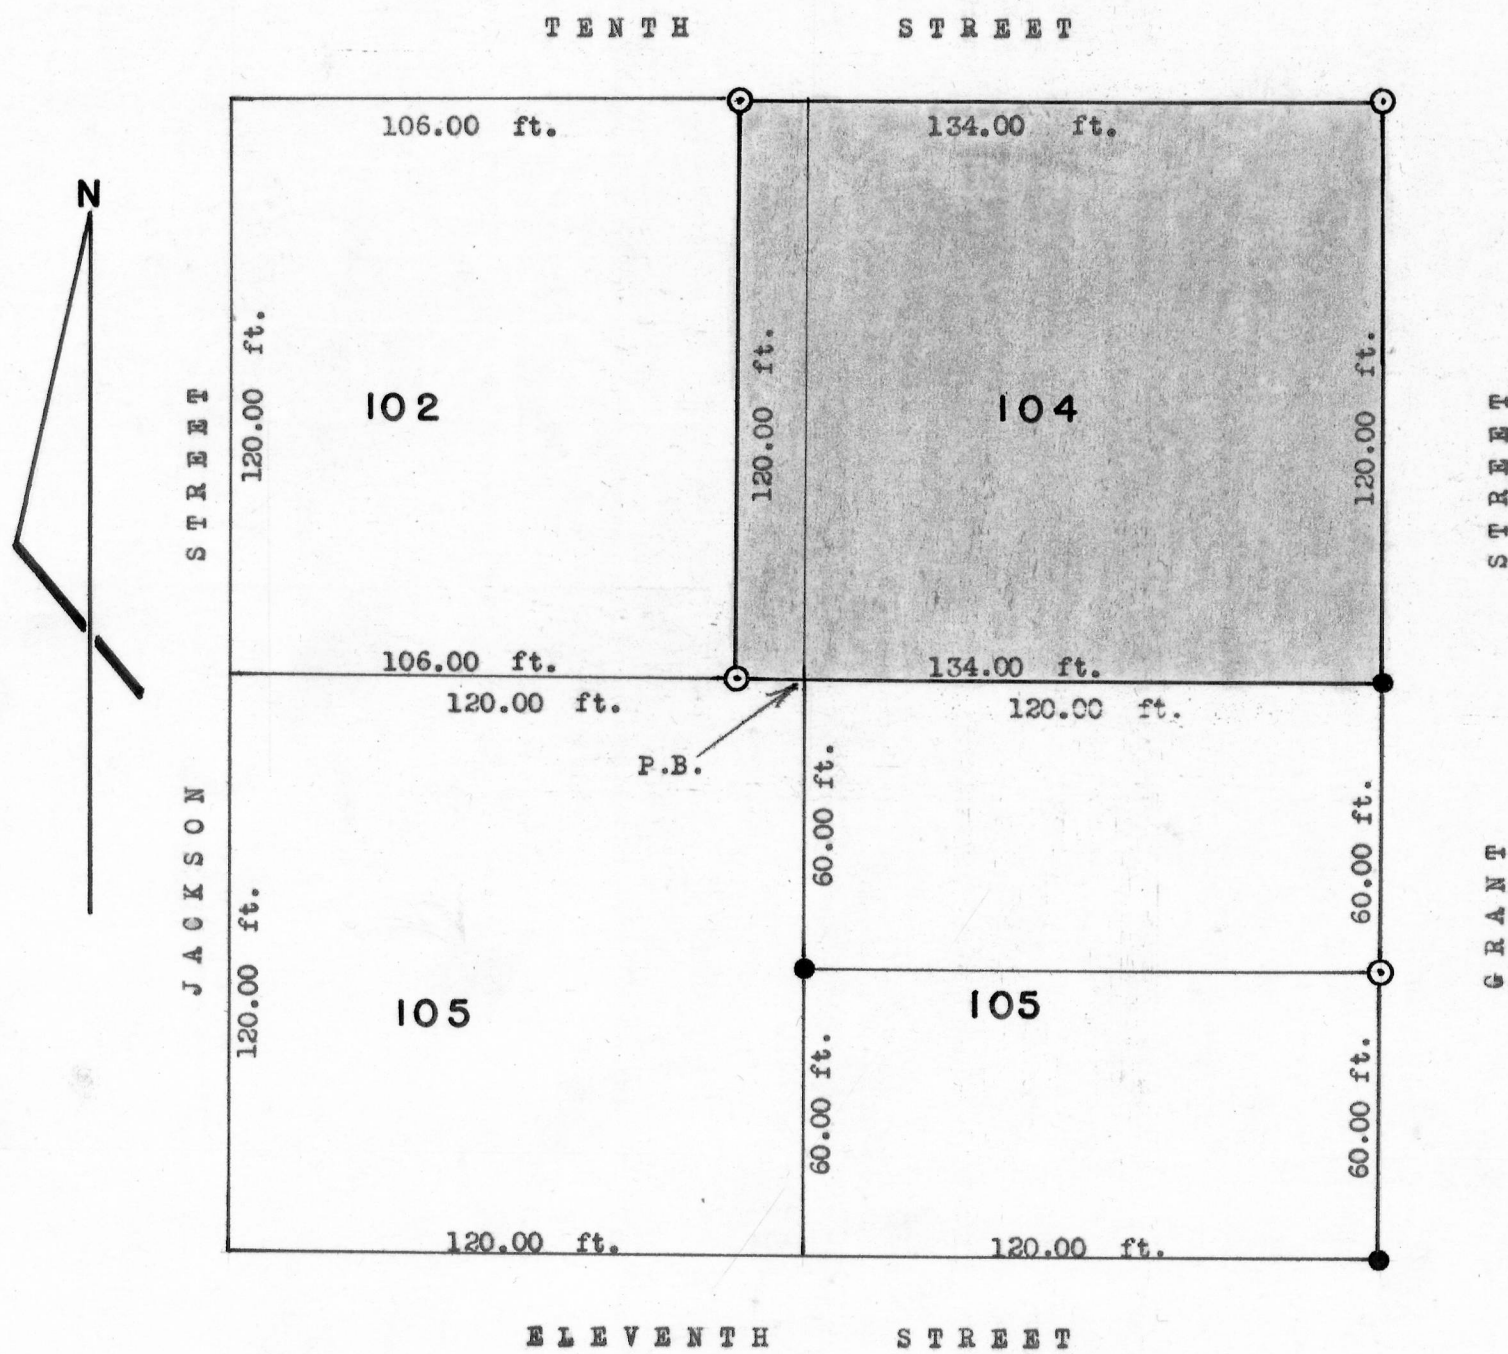

- ⊙ Pipe placed by this survey.
- Pipe placed by a previous survey.

DESCRIPTION

Commencing at a point 180.00 feet East of the Southeast corner of Lot 8, Block 7 of the original plat of the village(now City) of Fennimore, Grant County, Wisconsin; thence East 120.00 feet; thence North 120.00 feet; thence West 134.00 feet; thence South 120.00 feet; thence East 14.00 feet to the place of beginning. The above described property is designated as Outlot 104 and part of Outlot 102 of the Assessment Plat to the City of Fennimore, Grant County, Wisconsin.

Charles Lange
Charles Lange
5/22 - 6/7/71



Homer D. Ralph, Jr.
Homer D. Ralph, Jr.
Surveyor for Grant
County, Wisconsin