

BOB IRISH SURVEY


SCALE: 1" = 50'

+ Chisel mark in concrete

o 1" X 24" Iron pipe placed by this survey.

DESCRIPTION:

Lots 1 and 2 in Block 3 of Byerly's Addition to the City of Fennimore, Grant County, Wisconsin according to the recorded map or plat thereof.

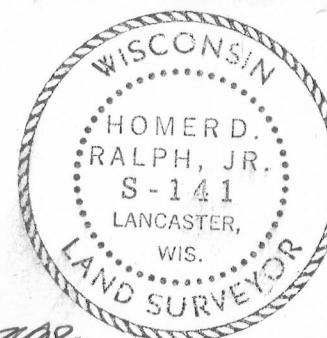


Charles Lange
Charles Lange
7/13 - 7/14/72

Homer D. Ralph, Jr.
Homer D. Ralph, Jr.
Surveyor for Grant
County, Wisconsin.



Lincoln Avenue

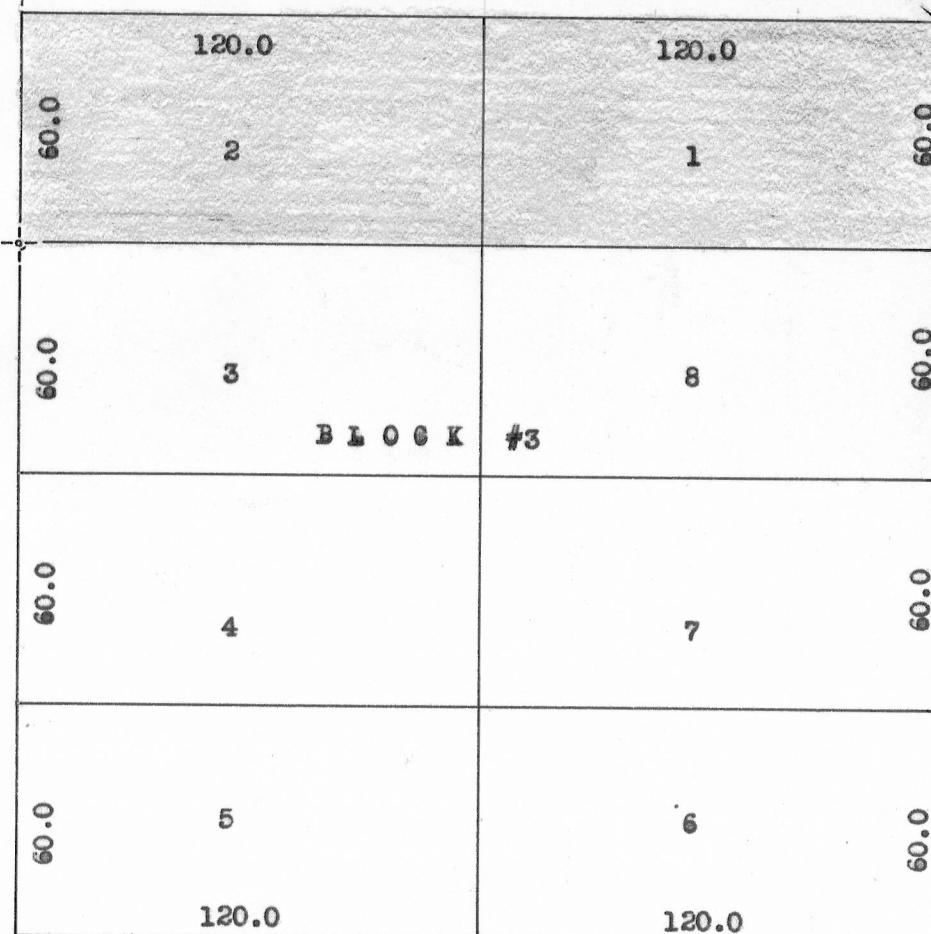

BLOCK #3

Wefel Street

West Pine Street