


FENNIMORE FINANCE CO. INC.

SCALE 1"=40'

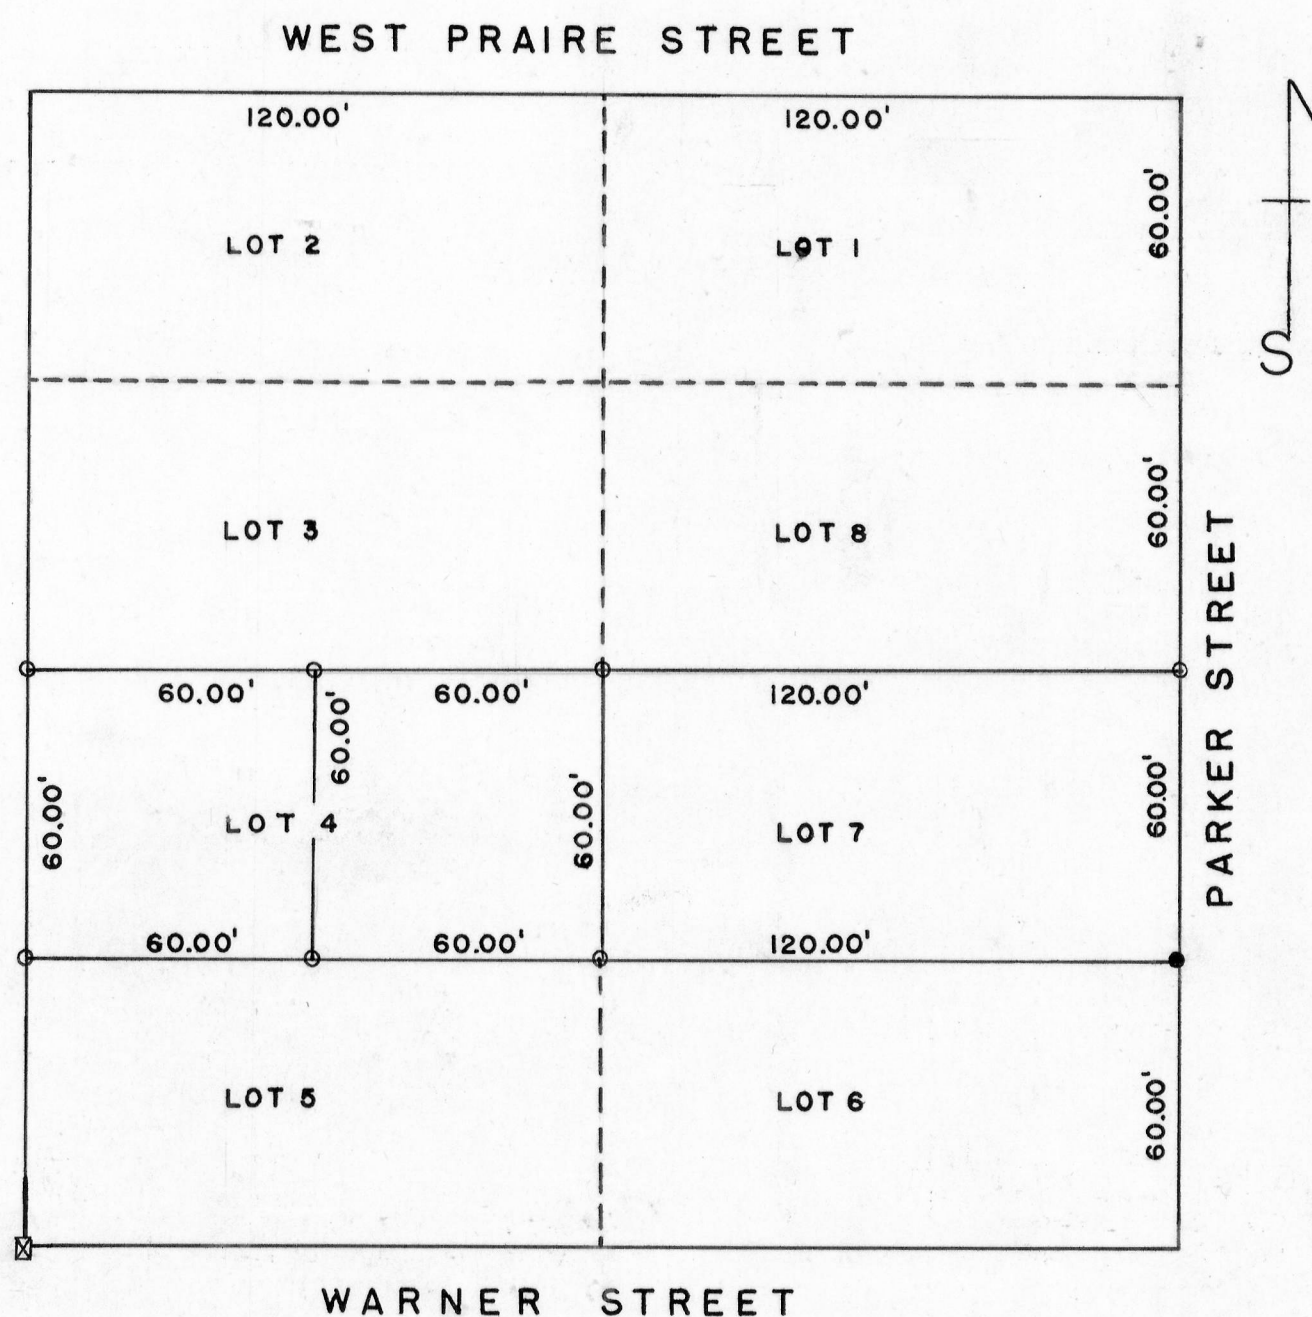

DESCRIPTION


Lots 4 and 7, Block 3, Fields Add.,
City of Fennimore, Grant County, Wisconsin,
according to the recorded map or plat there of.

O - 1"X24" iron pipe placed by this survey

• - X in side walk

☒ - stone placed in corner of Block 3

Charles Lange
Charles Lange
5/24-5/31/72

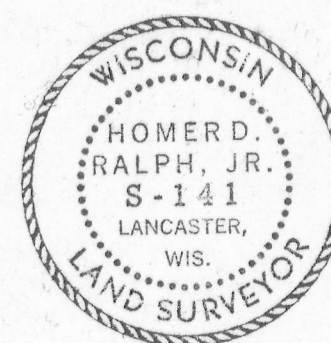

Homer D. Ralph, Jr.
Homer D. Ralph, Jr.
Surveyor for Grant
County, Wisconsin