



GIFT SURVEY

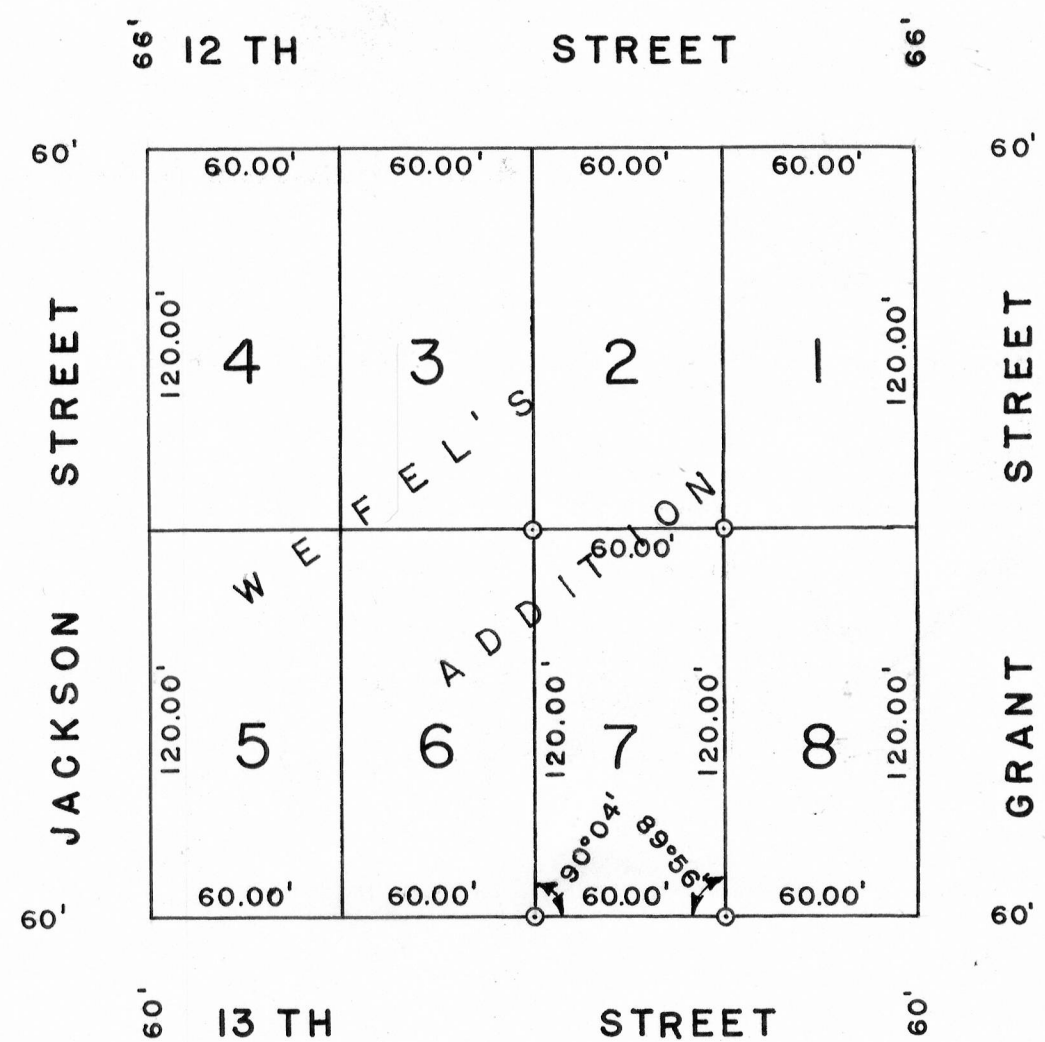

DESCRIPTION:

Lot 7 of Wefel's Addition to the Village (now City) of Fennimore, Grant County, Wisconsin.

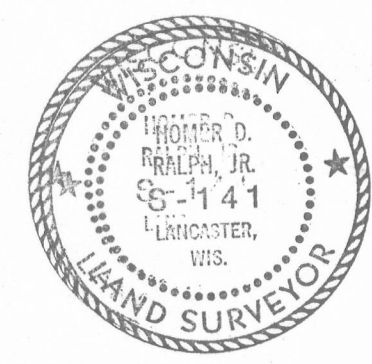

SCALE: 1" = 60'

© 1" X 24" IRON PIPE PLACED BY THIS SURVEY

David K. Krohn
DAVID K. KROHN
8/1/73 - 8/6/73

Homer D. Ralph, Jr.
HOMER D. RALPH, JR.
SURVEYOR FOR GRANT
COUNTY, WISCONSIN,