



ROGER SCHROEDER SURVEY

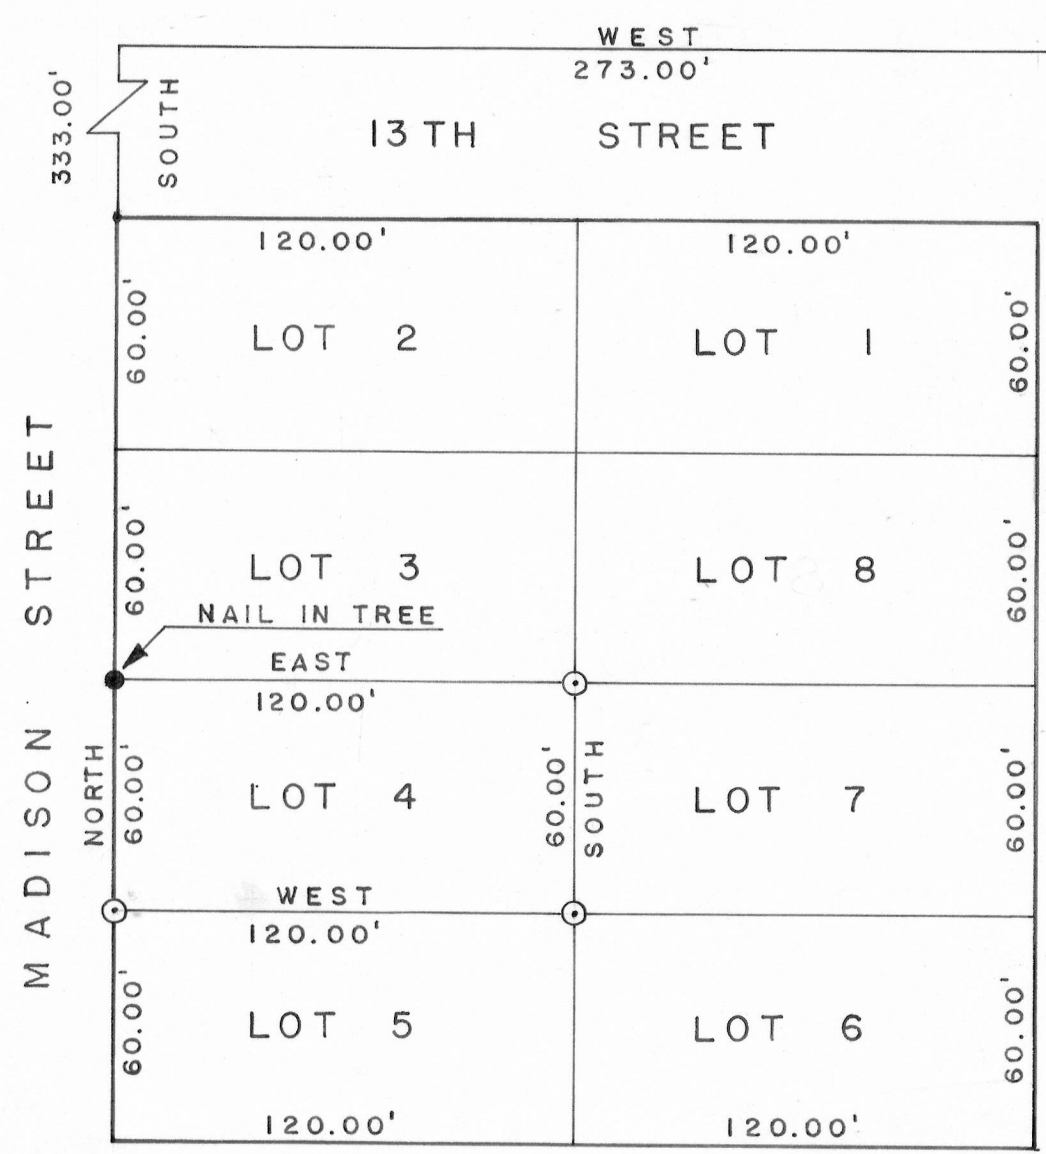

CENTER QUARTER CORNER OF SECTION 19, T 6 N, R 2 W.

SCALE: 1" = 50'

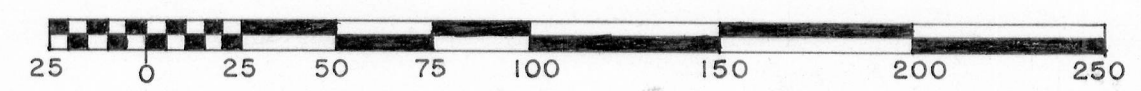

LEGEND:

- ⊙ 1" X 24" PIPE PLACED BY THIS SURVEY
- NAIL PLACED BY THIS SURVEY


DESCRIPTION:

Part of the N.E.1/4 of the S.W.1/4 of Section 19, T 6 N, R 2 W, of the 4th P.M., Grant County, Wisconsin, described as follows to-wit: Begin at the Northeast corner of the S.W.1/4 of said Section 19; thence West 273.00 feet; thence South 453.00 feet to the point of beginning; thence East 120.00 feet; thence South 60.00 feet; thence West 120.00 feet; thence North 60.00 feet to the point of beginning.

Also described as Lot Four (4) in Block Fourteen (14) of the Original Plat of the Village (now City) of Fennimore, Grant County, Wisconsin, according to the recorded map or plat thereof.

BLOCK 14, O.P.
FENNIMORE

David K. Krohn
DAVID K. KROHN
4/10/74 - 4/18/74

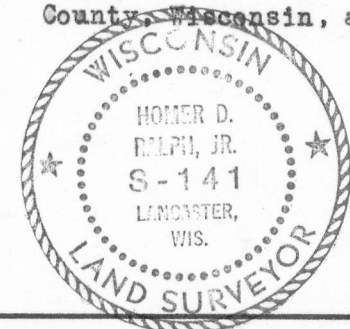

Homer D. Ralph, Jr.
HOMER D. RALPH, JR.
SURVEYOR FOR GRANT
COUNTY, WISCONSIN