


2/14/75
This is not
the final survey
H. D. R.

GRATZ — CITY OF FENNIMORE SURVEY

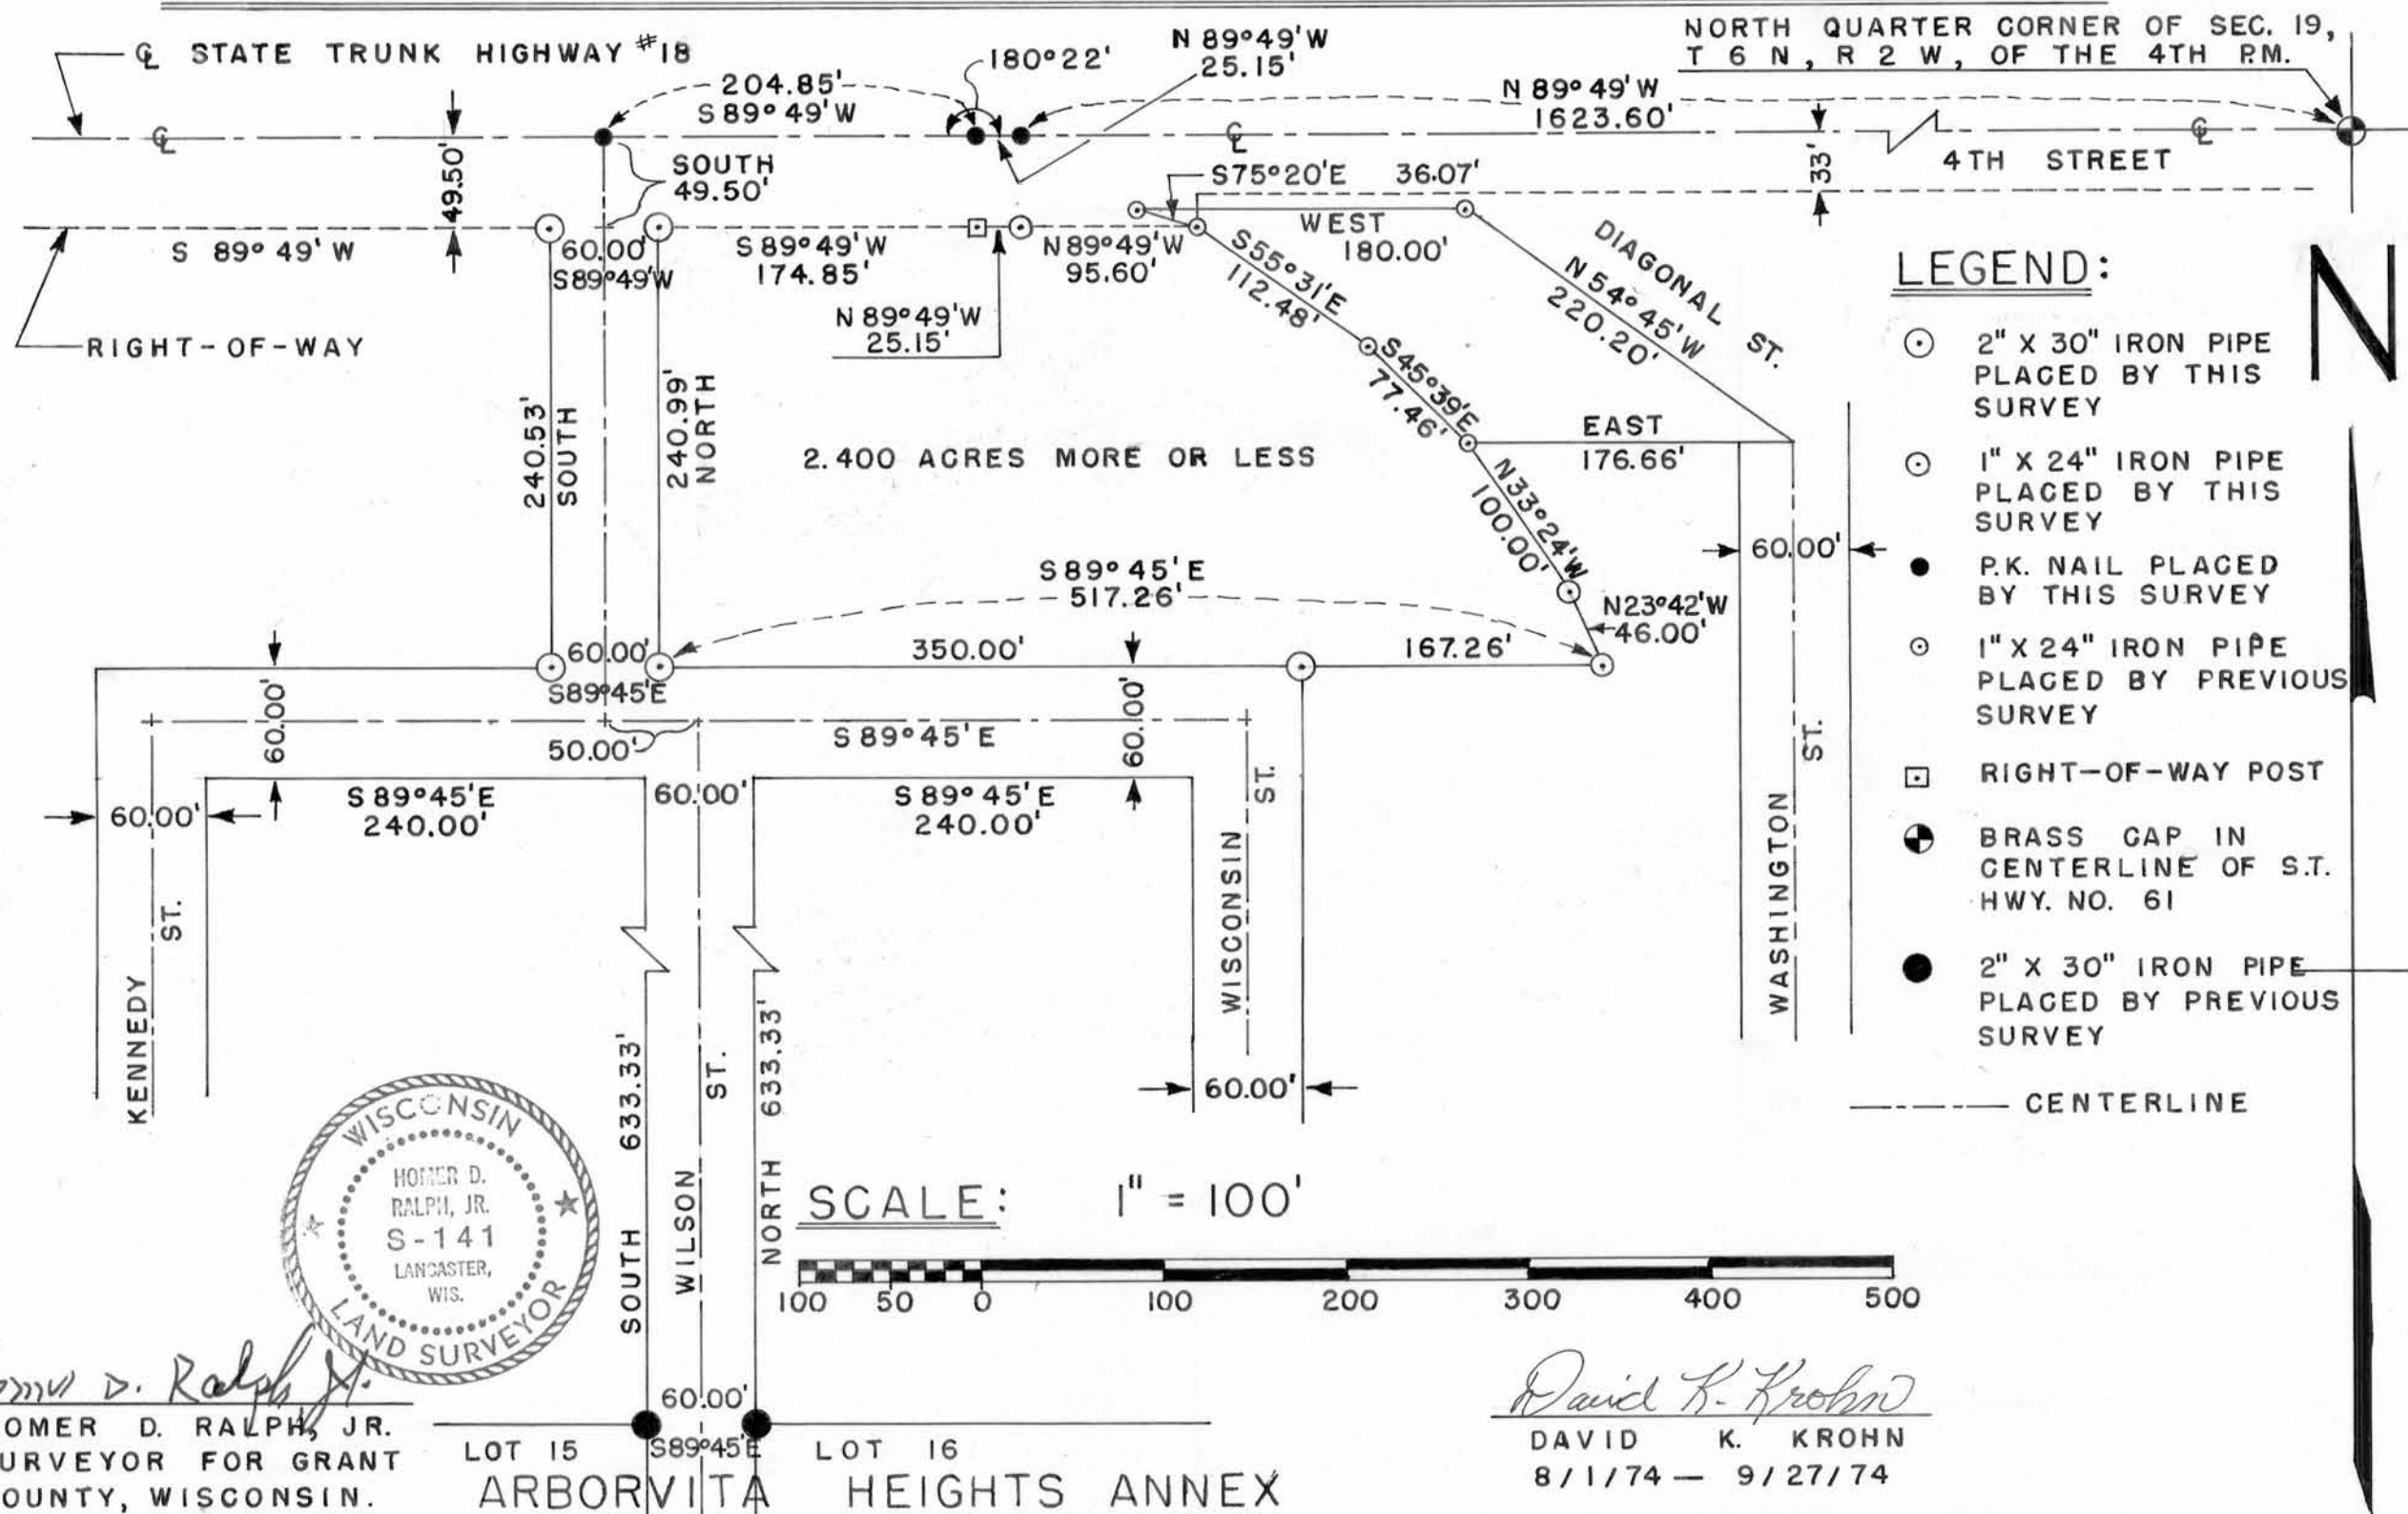

GRATZ - CITY OF FENNIMORE SURVEY

DESCRIPTION:

Part of the N.W.1/4 of the N.W.1/4 of Section 19, T 6 N, R 2 W,
of the 4th P.M., Grant County, Wisconsin, described as follows
to-wit:

Begin at the North Quarter Corner of said Section 19;
thence North 89° 49' West 1648.75 feet;
thence South 89° 49' West 204.85 feet;
thence South 49.50 feet;
thence North 89° 49' East 30.00 feet to the point of beginning;
thence South 240.99 feet;
thence South 89° 45' East 517.26 feet;
thence North 23° 42' West 46.00 feet;
thence North 33° 24' West 100.00 feet;
thence North 45° 39' West 77.46 feet;
thence North 55° 31' West 112.48 feet;
thence North 89° 49' West 120.75 feet;
thence South 89° 49' West 174.85 feet to the point of beginning.
Containing 2.400 acres, more or less.

Also described as part of Outlots 285A and 284A of the
Assessment Plat to the Village (now City) of Fennimore,
Grant County, Wisconsin.



GRATZ - CITY OF FENNIMORE SURVEY

DESCRIPTION: (STREET)

Part of the N.W.1/4 of the N.W.1/4 of Section 19, T 6 N, R 2 W,
of the 4th P.M., Grant County, Wisconsin, described as follows
to-wit:

Begin at the North Quarter Corner of said Section 19;
thence North 89° 49' West 1648.75 feet;
thence South 89° 49' West 204.85 feet;
thence South 49.50 feet to the point of beginning;
thence South 89° 49' West 30.00 feet;
thence South 300.53 feet;
thence South 89° 45' East 410.00 feet;
thence North 60.00 feet;
thence North 89° 45' West 350.00 feet;
thence North 240.99 feet;
thence South 89° 49' West 30.00 feet to the point of beginning.
Containing 0.896 acres more or less.

Also described as part of Outlots 285A and 284A of the Assessment
Plat to the Village (now City) of Fennimore, Grant County,
Wisconsin.

