


PREVATT SURVEY

SCALE: 1" = 60'

o 1" X 24" Iron pipe placed by this survey.

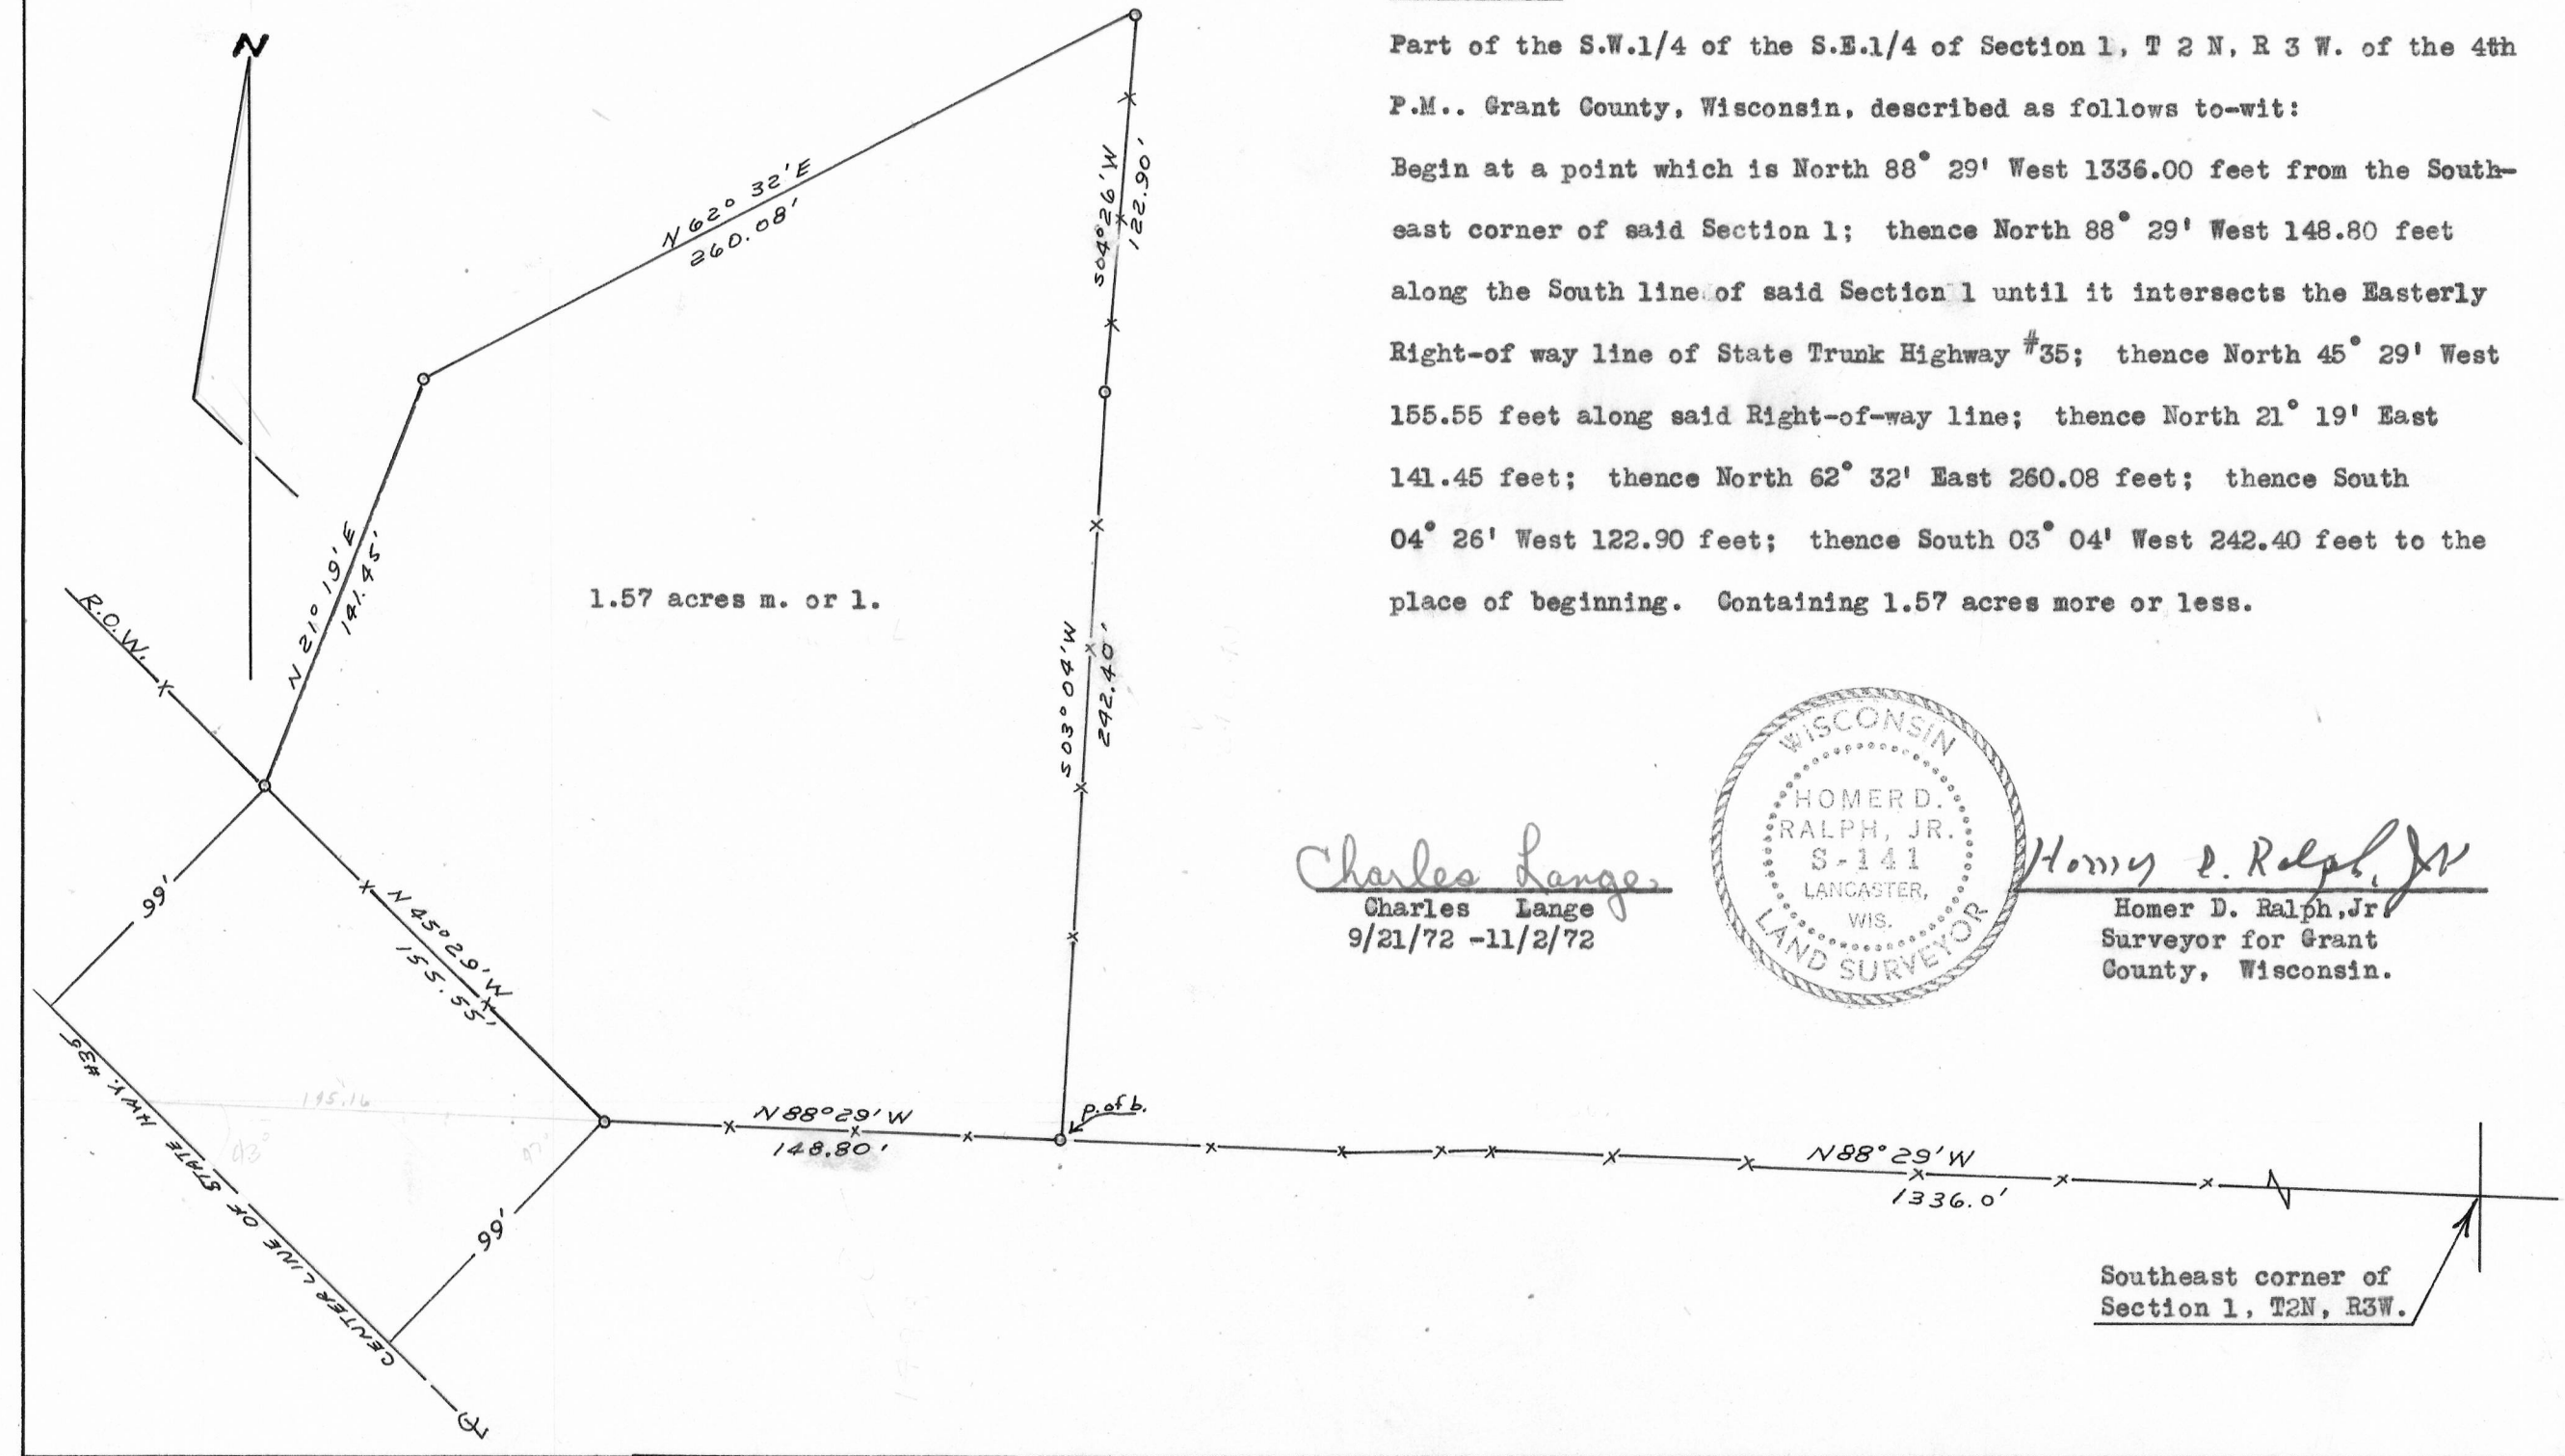

DESCRIPTION:

Part of the S.W.1/4 of the S.E.1/4 of Section 1, T 2 N, R 3 W. of the 4th P.M.. Grant County, Wisconsin, described as follows to-wit:

Begin at a point which is North 88° 29' West 1336.00 feet from the Southeast corner of said Section 1; thence North 88° 29' West 148.80 feet along the South line of said Section 1 until it intersects the Easterly Right-of way line of State Trunk Highway #35; thence North 45° 29' West 155.55 feet along said Right-of-way line; thence North 21° 19' East 141.45 feet; thence North 62° 32' East 260.08 feet; thence South 04° 26' West 122.90 feet; thence South 03° 04' West 242.40 feet to the place of beginning. Containing 1.57 acres more or less.

Charles Lange
Charles Lange
9/21/72 -11/2/72



Homer D. Ralph, Jr.
Homer D. Ralph, Jr.
Surveyor for Grant
County, Wisconsin.