


LEO MARKUS SURVEY

STONE MONUMENT FOUND

SCALE: 1" = 200'

o - 1" X 24" pipe placed by
this survey.

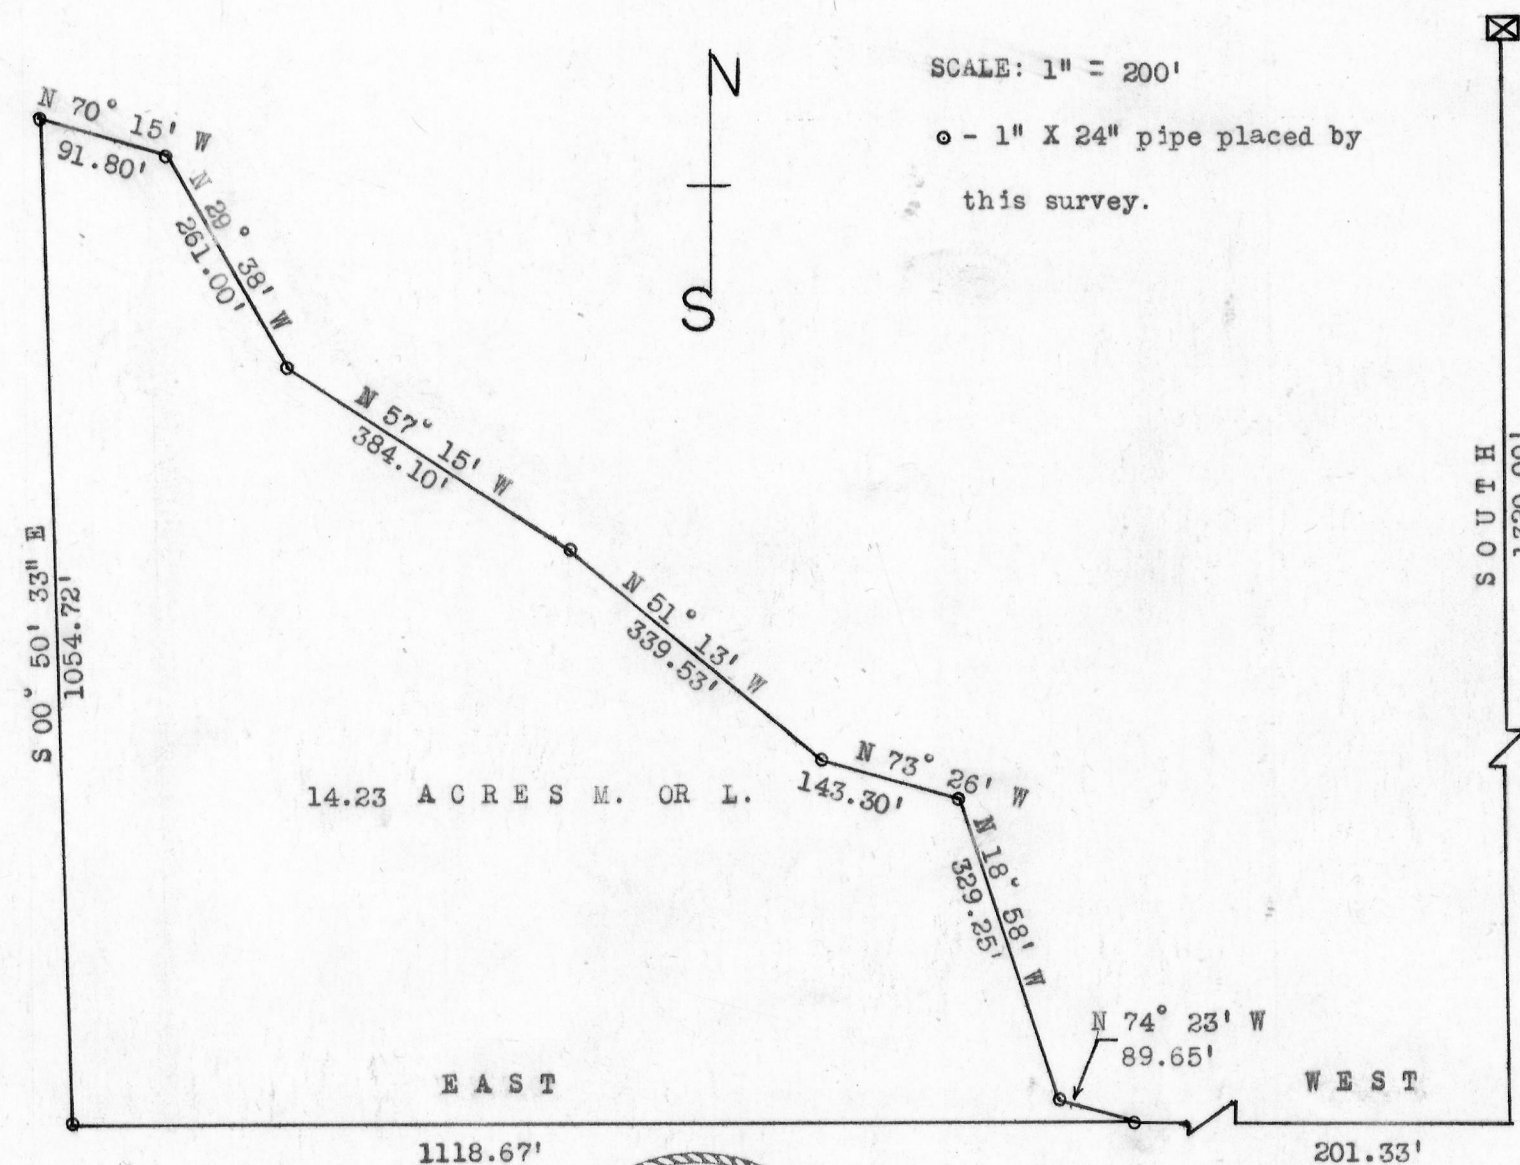


⊠ Northeast corner of
Northwest 1/4 of the
Northwest 1/4 of
section 4

DISCRIPTION

A part of the Northwest 1/4 of the Northwest 1/4 of section 4, T 2 N, R 3 W, of the 4th P. M., Grant County, Wisconsin, described as follows to-wit:

Begin at a point which is South 1320 feet; thence West 201.33 feet from the Northeast corner of said Northwest 1/4 of the Northwest 1/4 of Section 4; thence North 74° 23' West 89.65 feet; thence North 18° 58' West 329.25 feet; thence North 73° 26' West 143.30 feet; thence North 51° 13' West 339.53 feet; thence North 57° 15' West 384.10 feet; thence North 29° 38' West 261.00 feet; thence North 70° 15' West 91.80 feet; thence South 00° 51' 33" East 1054.72 feet; thence East 1118.67 feet to point of beginning. Containing 14.23 acres more or less.

Charles Lange
Charles Lange
5/17-5/26/72

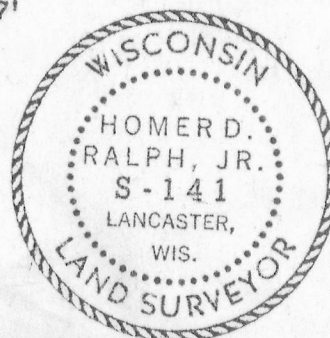

Homer D. Ralph, Jr.
Homer D. Ralph, Jr.
Surveyor for Grant
County, Wisconsin.