


HERBERT DEAN SURVEY

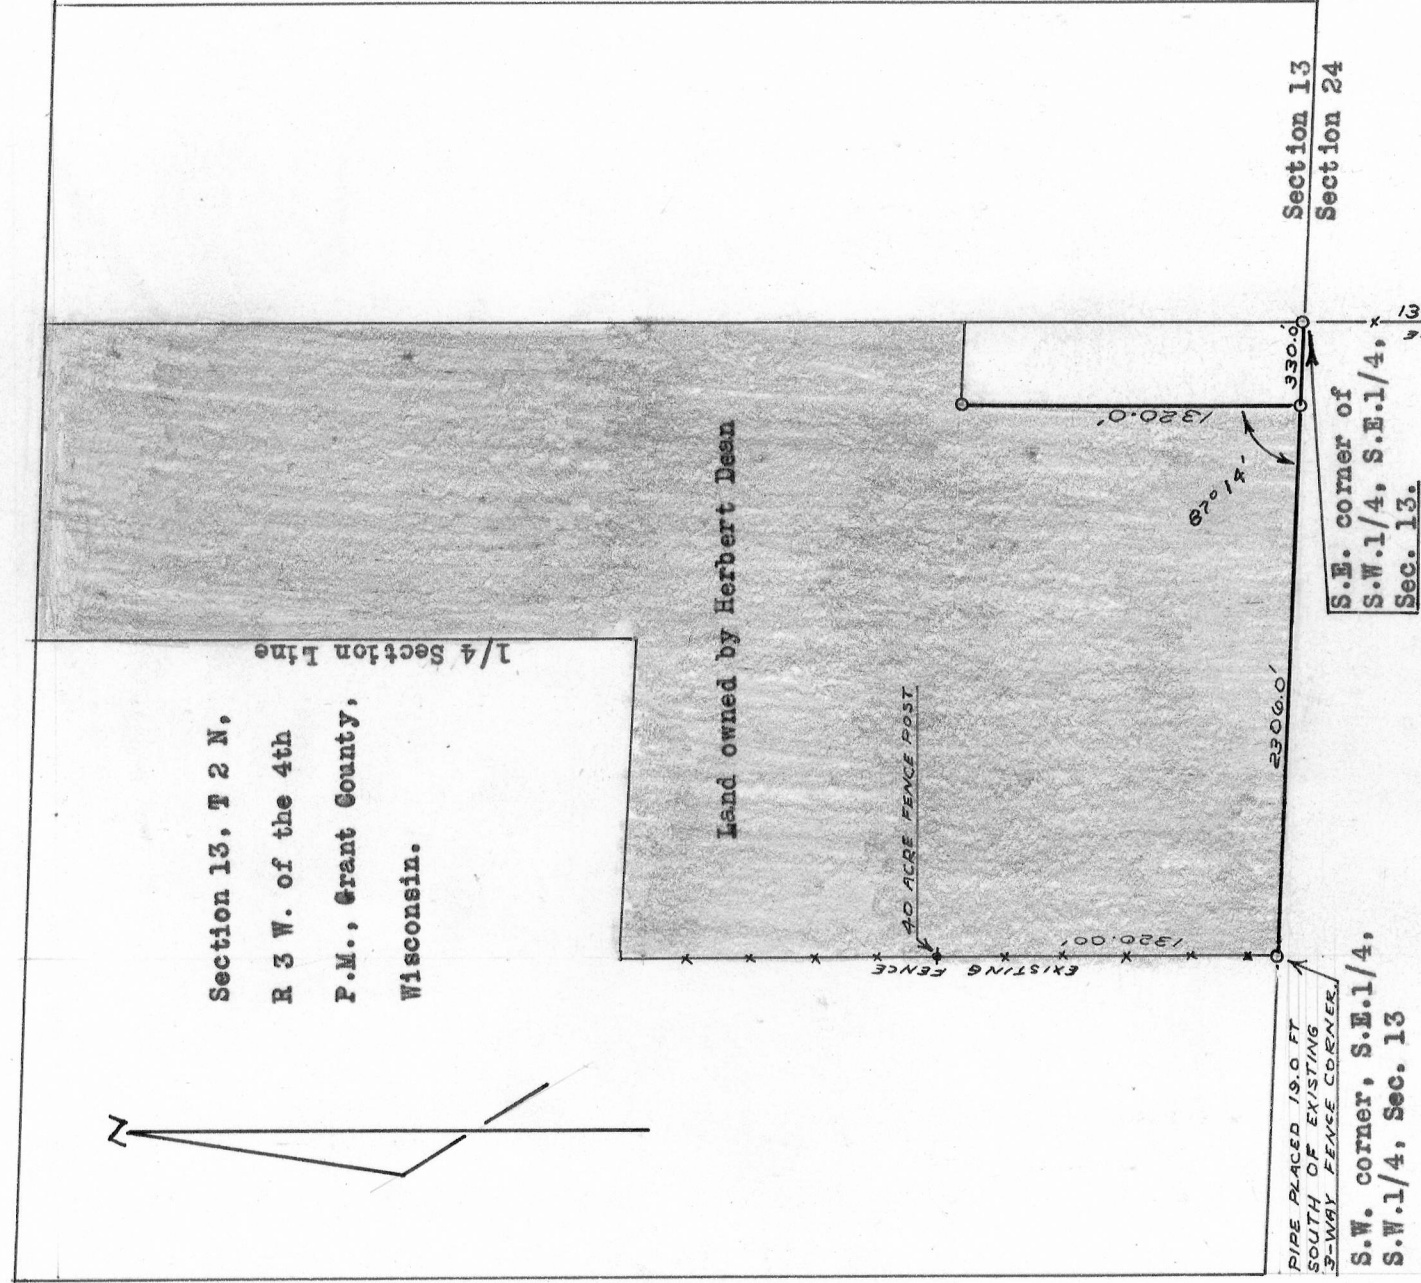

SCALE: 1" = 200'

o 1" X 24" Iron pipe placed by this survey.

S.E. corner of
N.W. 1/4 of N.E. 1/4,
Sec. 24, T 2 N, R 3 W.



Charles Lange
Charles Lange
5/25 - 7/14/72

Homer D. Ralph, Jr.
Homer D. Ralph, Jr.
Surveyor for Grant
County, Wisconsin.