


DAVID SURVEY

SCALE 1"=100'

T 3 N, R 3 W

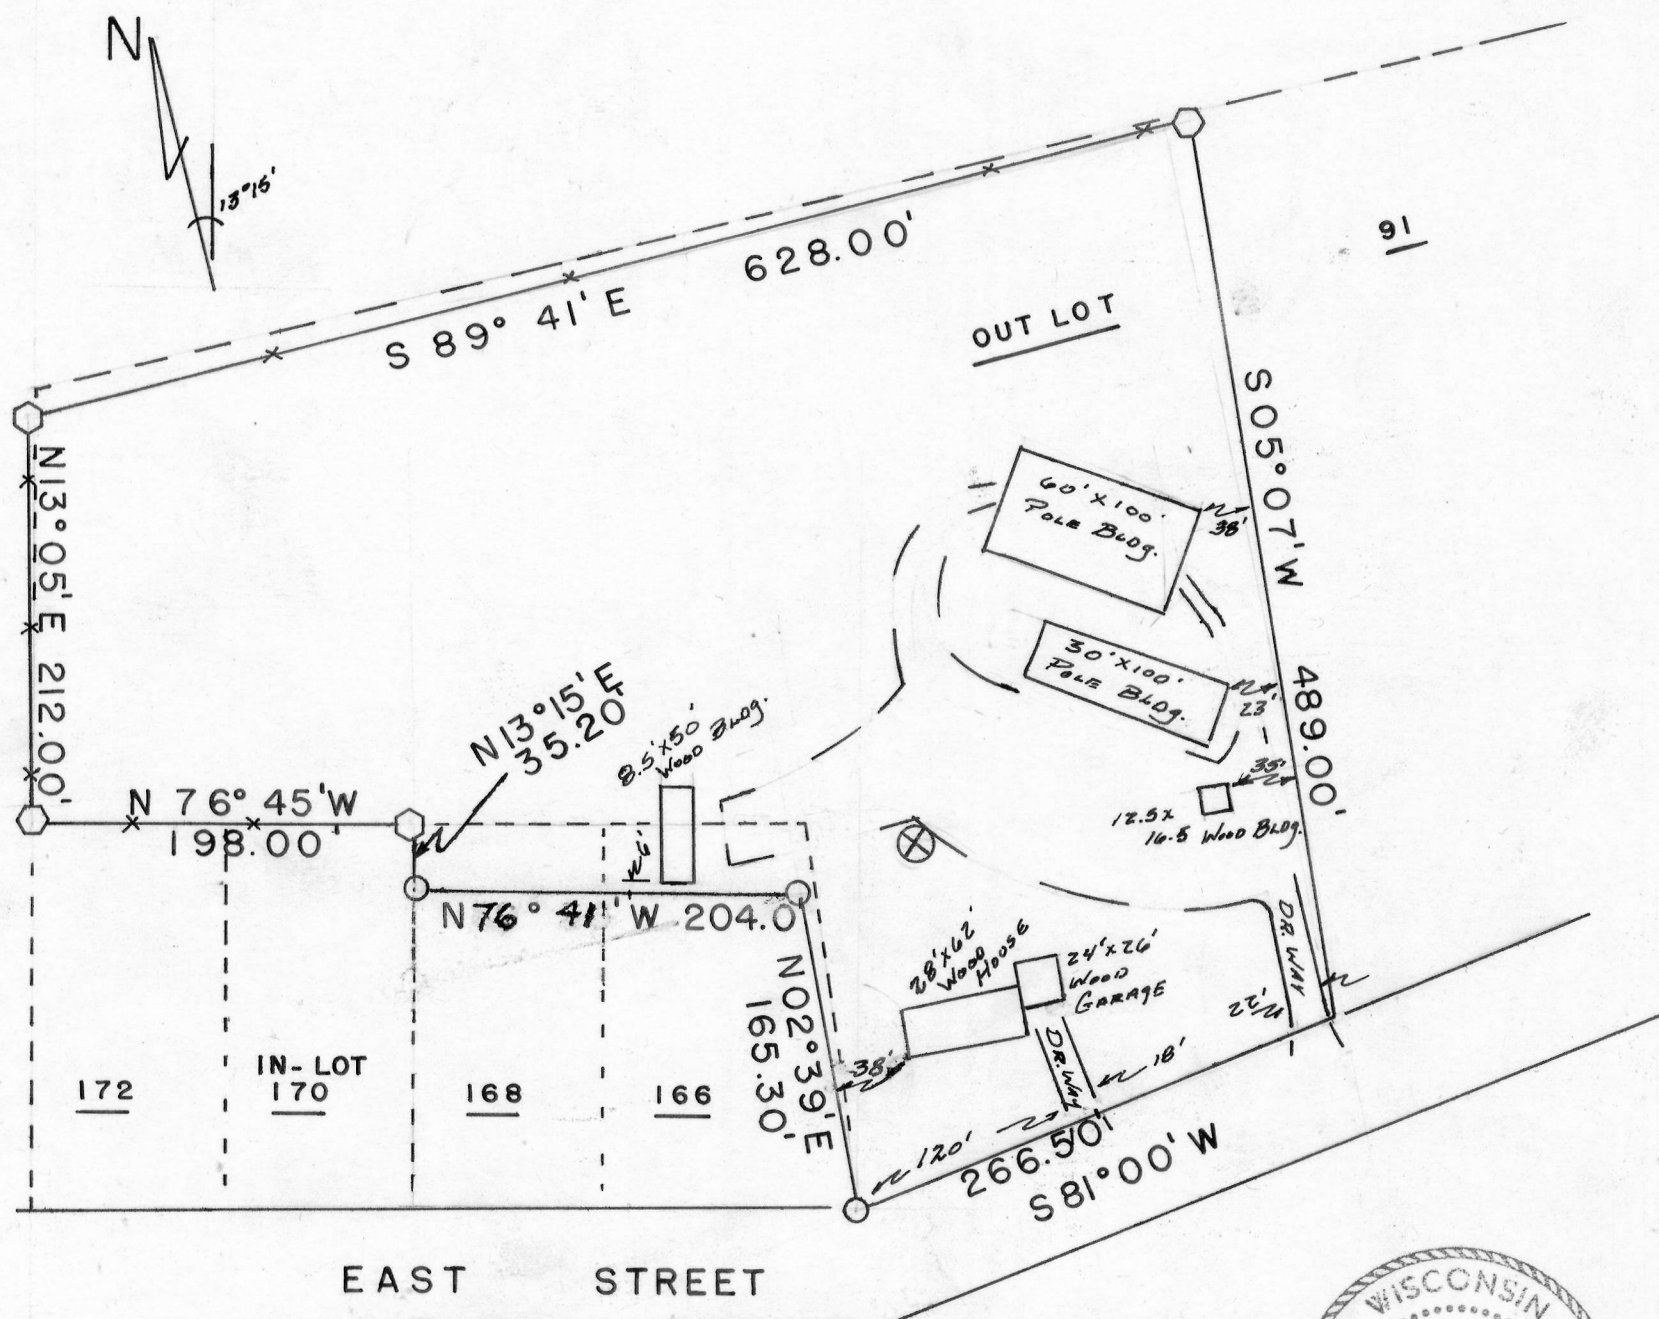

LEGEND:

- 1"X 24" IRON PIPE
- DENOTES PLAT LINES
- * * DENOTES FENCE LINES
- DENOTES CORNER POST
- ⊗ DENOTES UTILITY POLE

Description:

Part of In-lots 168 and 166, also part of Out-lot 91 of Section 34, T3N, R3W, of the 4th P.M., in the Village of Potosi, Grant County, Wisconsin, described as follows, to-wit: Begin at the Northwest corner of said In-lot 168; thence North 76° 45' West 198.00 feet to the Northwest corner of In-lot 172; thence North 13° 05' East 212.00 feet; thence South 89° 41' East 628.00 feet; thence South 05° 07' West 489.00 feet to a point upon the Northerly boundary of East Street; thence South 81° 00' West 266.50 feet along the Northerly boundary of said street to the Southeast corner of said In-lot 166; thence North 02° 39' East 165.30 feet; thence North 76° 41' West 204.00 feet; thence North 13° 15' East 35.20 feet to the place of beginning.

"We certify that we have surveyed the above-described property and that the above plat is an accurate survey and a true representation thereof and correctly shows the exterior boundary lines and location of buildings and other improvements, and roads, driveways, and other apparent easements on said property and the correct measurements thereof."

Homer D. Ralph, Jr.

Lancaster,

Wisconsin, February 3

, 1970.

5-343
124