


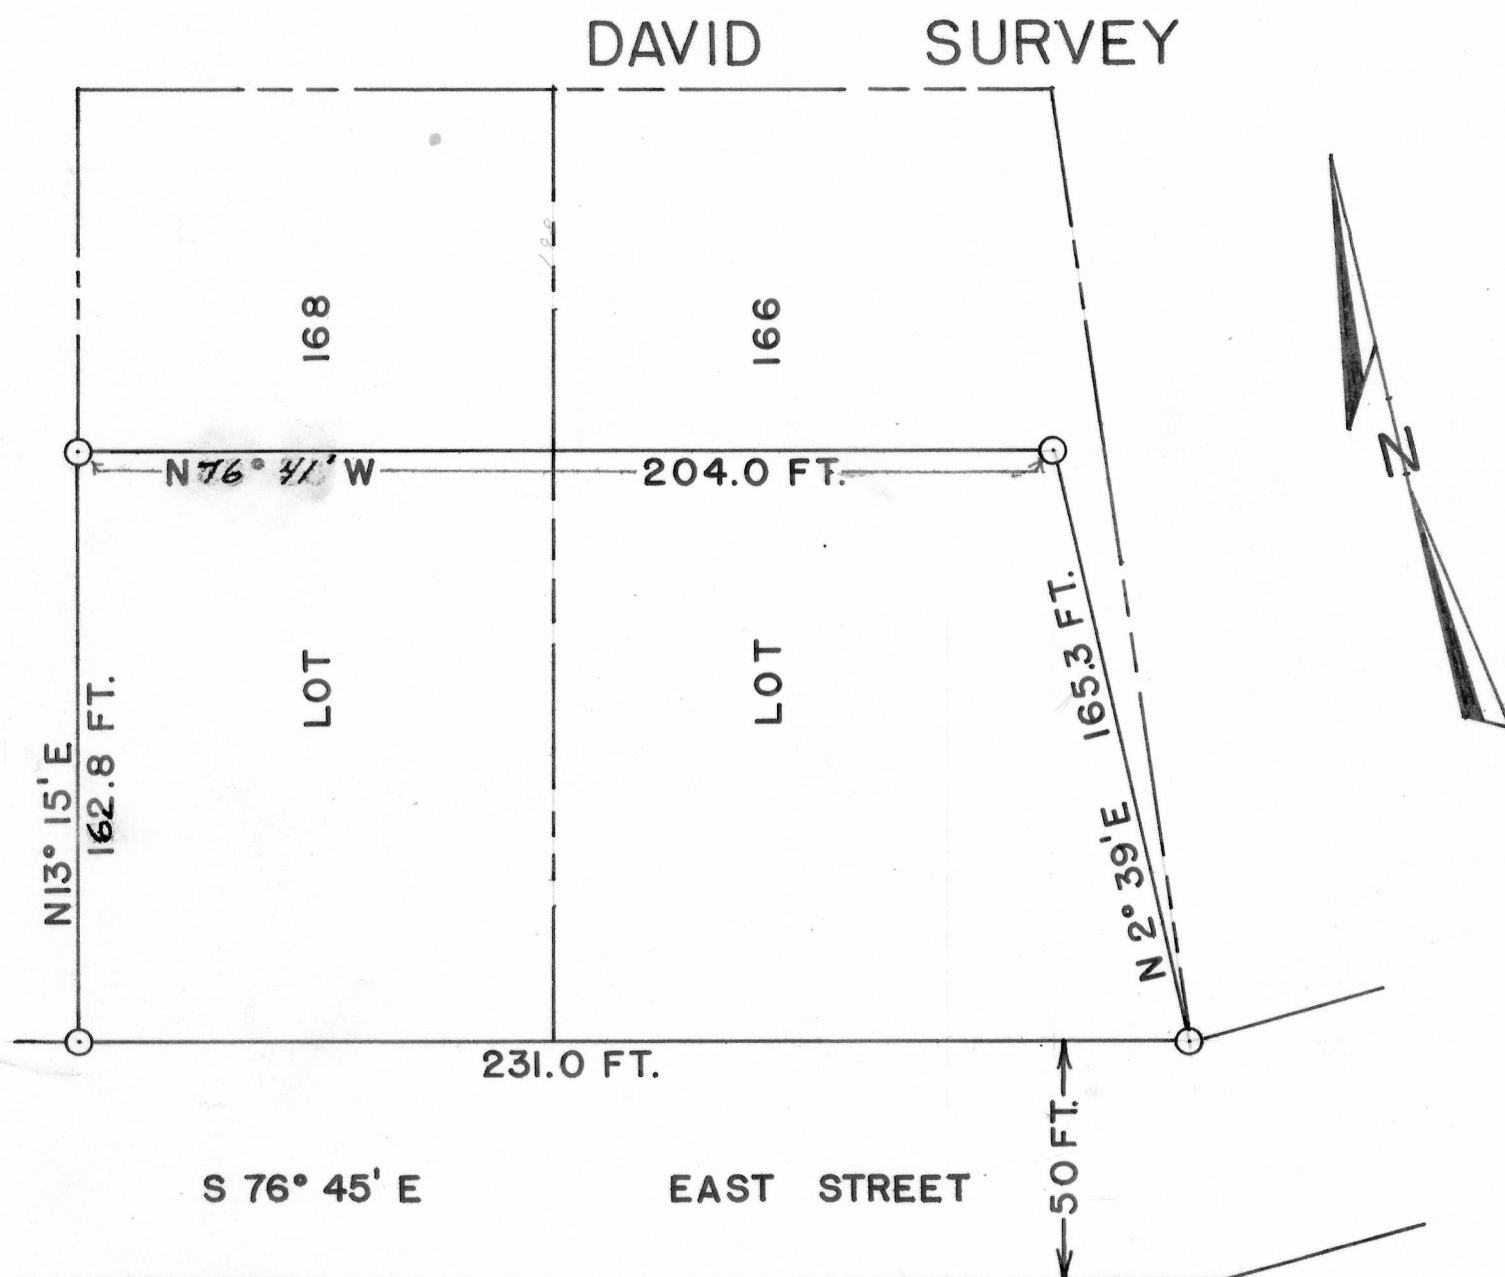


⊙ 1"X 24" IRON PIPE PLACED BY THIS SURVEY

DESCRIPTION

Part of In-lots 166 and 168 of Section 34, T 3 N, R 3 W. of the 4th P.M., in the Village of Potosi, Grant County, Wisconsin, described as follows, to-wit:
 Begin at the Southwest corner of said In-lot 168; thence North $13^{\circ} 15'$ East 162.8 feet along the Westerly boundary of said In-lot 168; thence South $76^{\circ} 41'$ East 204.00 feet; thence South $02^{\circ} 39'$ West 165.30 feet; thence North $76^{\circ} 45'$ West 231.00 feet along Northerly boundary of East Street to the place of beginning.

Art Seymour
 Art Seymour
 7-14-69 7-15-69

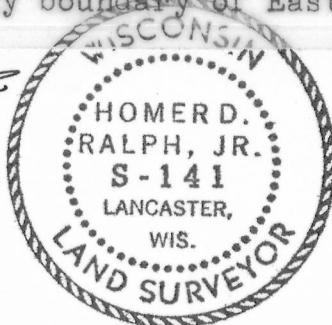

Homer D. Ralph, Jr.
 Homer D. Ralph, Jr.
 Surveyor for Grant County, Wis.