
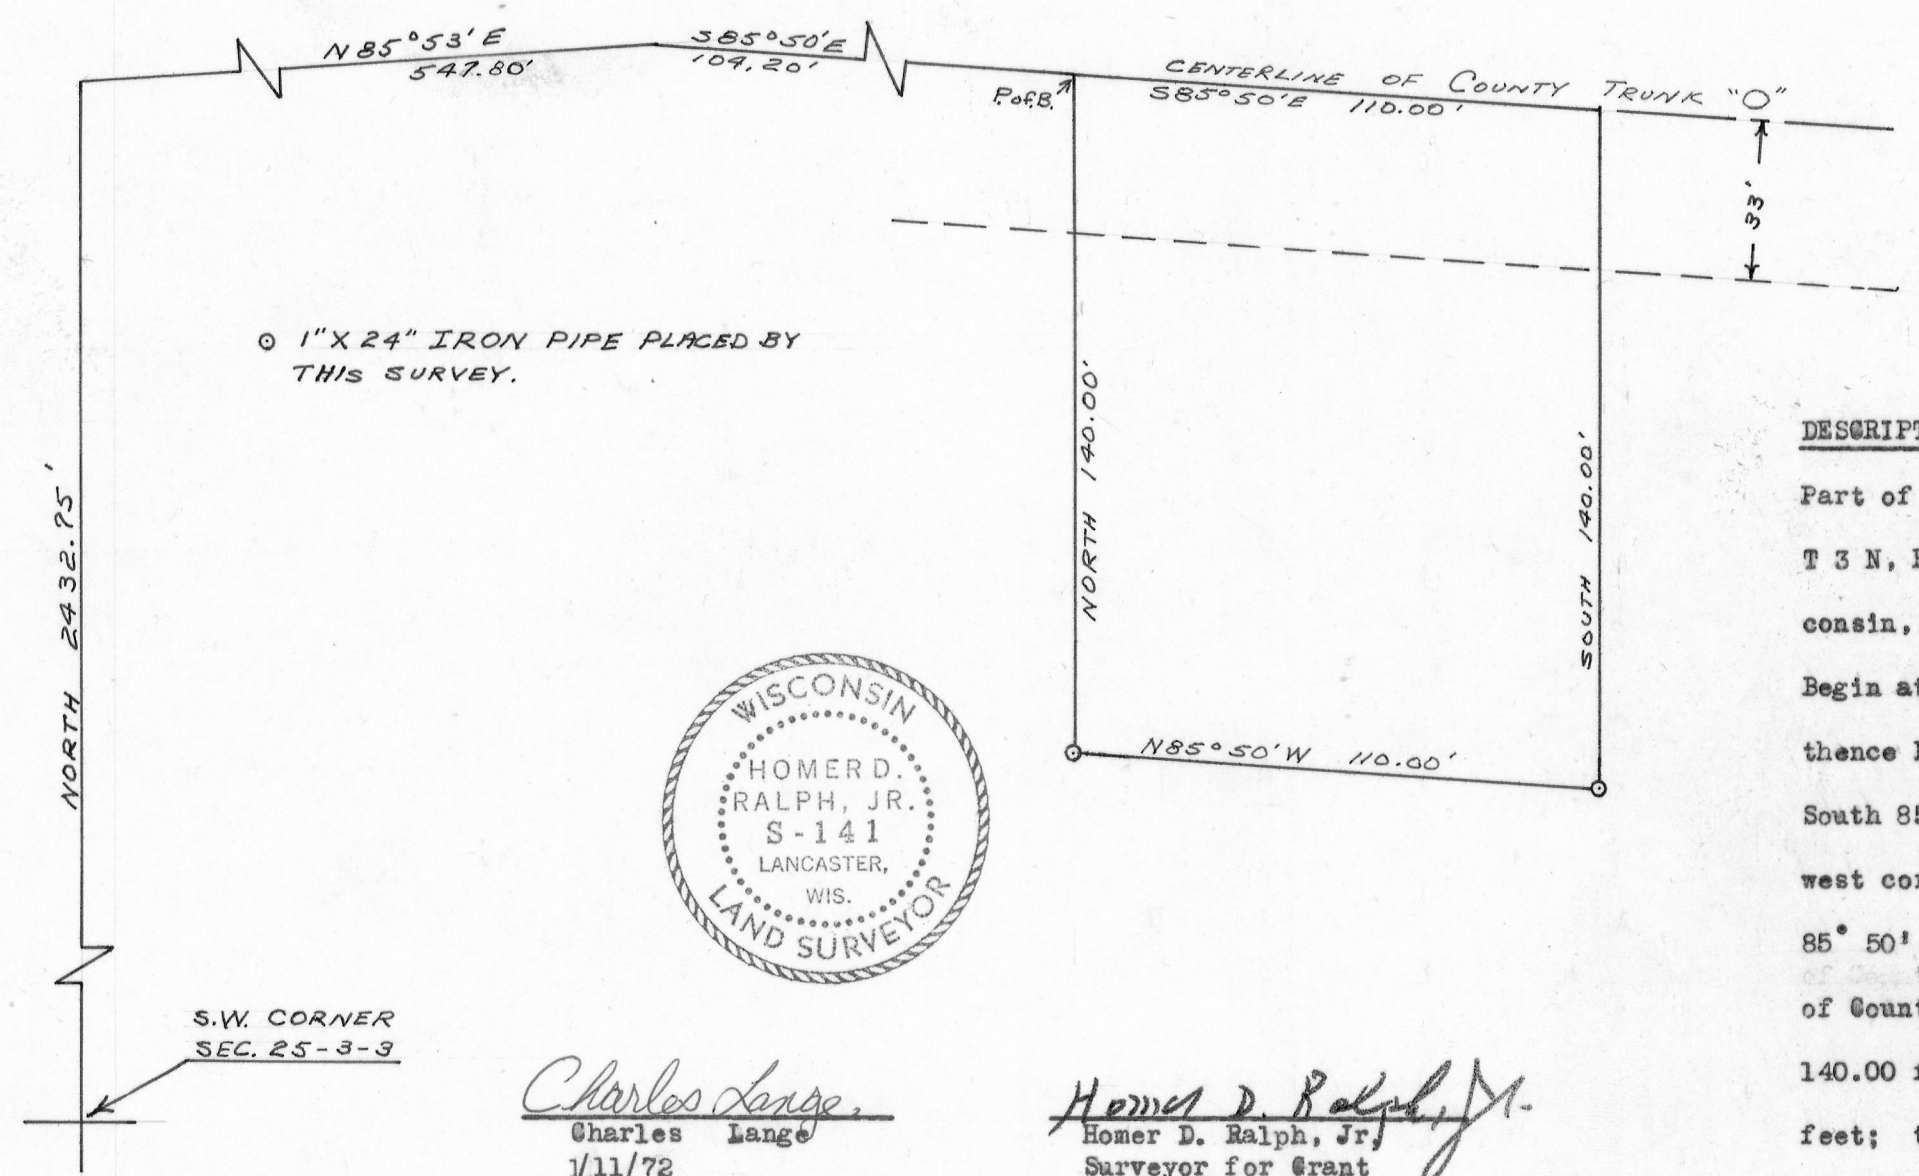


BRANDT SURVEY
SCALE: 1" = 40'

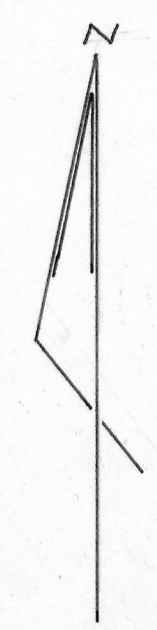

DESCRIPTION:
Part of Lot 42 in the Subdivision of Section 35,
T 3 N, R 3 W of the 4th P.M., Grant County, Wis-
consin, described as follows, to-wit:
Begin at a point which is North 2432.75 feet;
thence North 85° 53' East 547.80 feet; thence
South 85° 50' East 104.20 feet from the South-
west corner of said Section 35; thence South
85° 50' East 110.00 feet along the centerline
of County Trunk Highway "O"; thence South
140.00 feet; thence North 85° 50' West 110.00
feet; thence North 140.00 feet to the place of
beginning.