



RAY BRANDT SURVEY

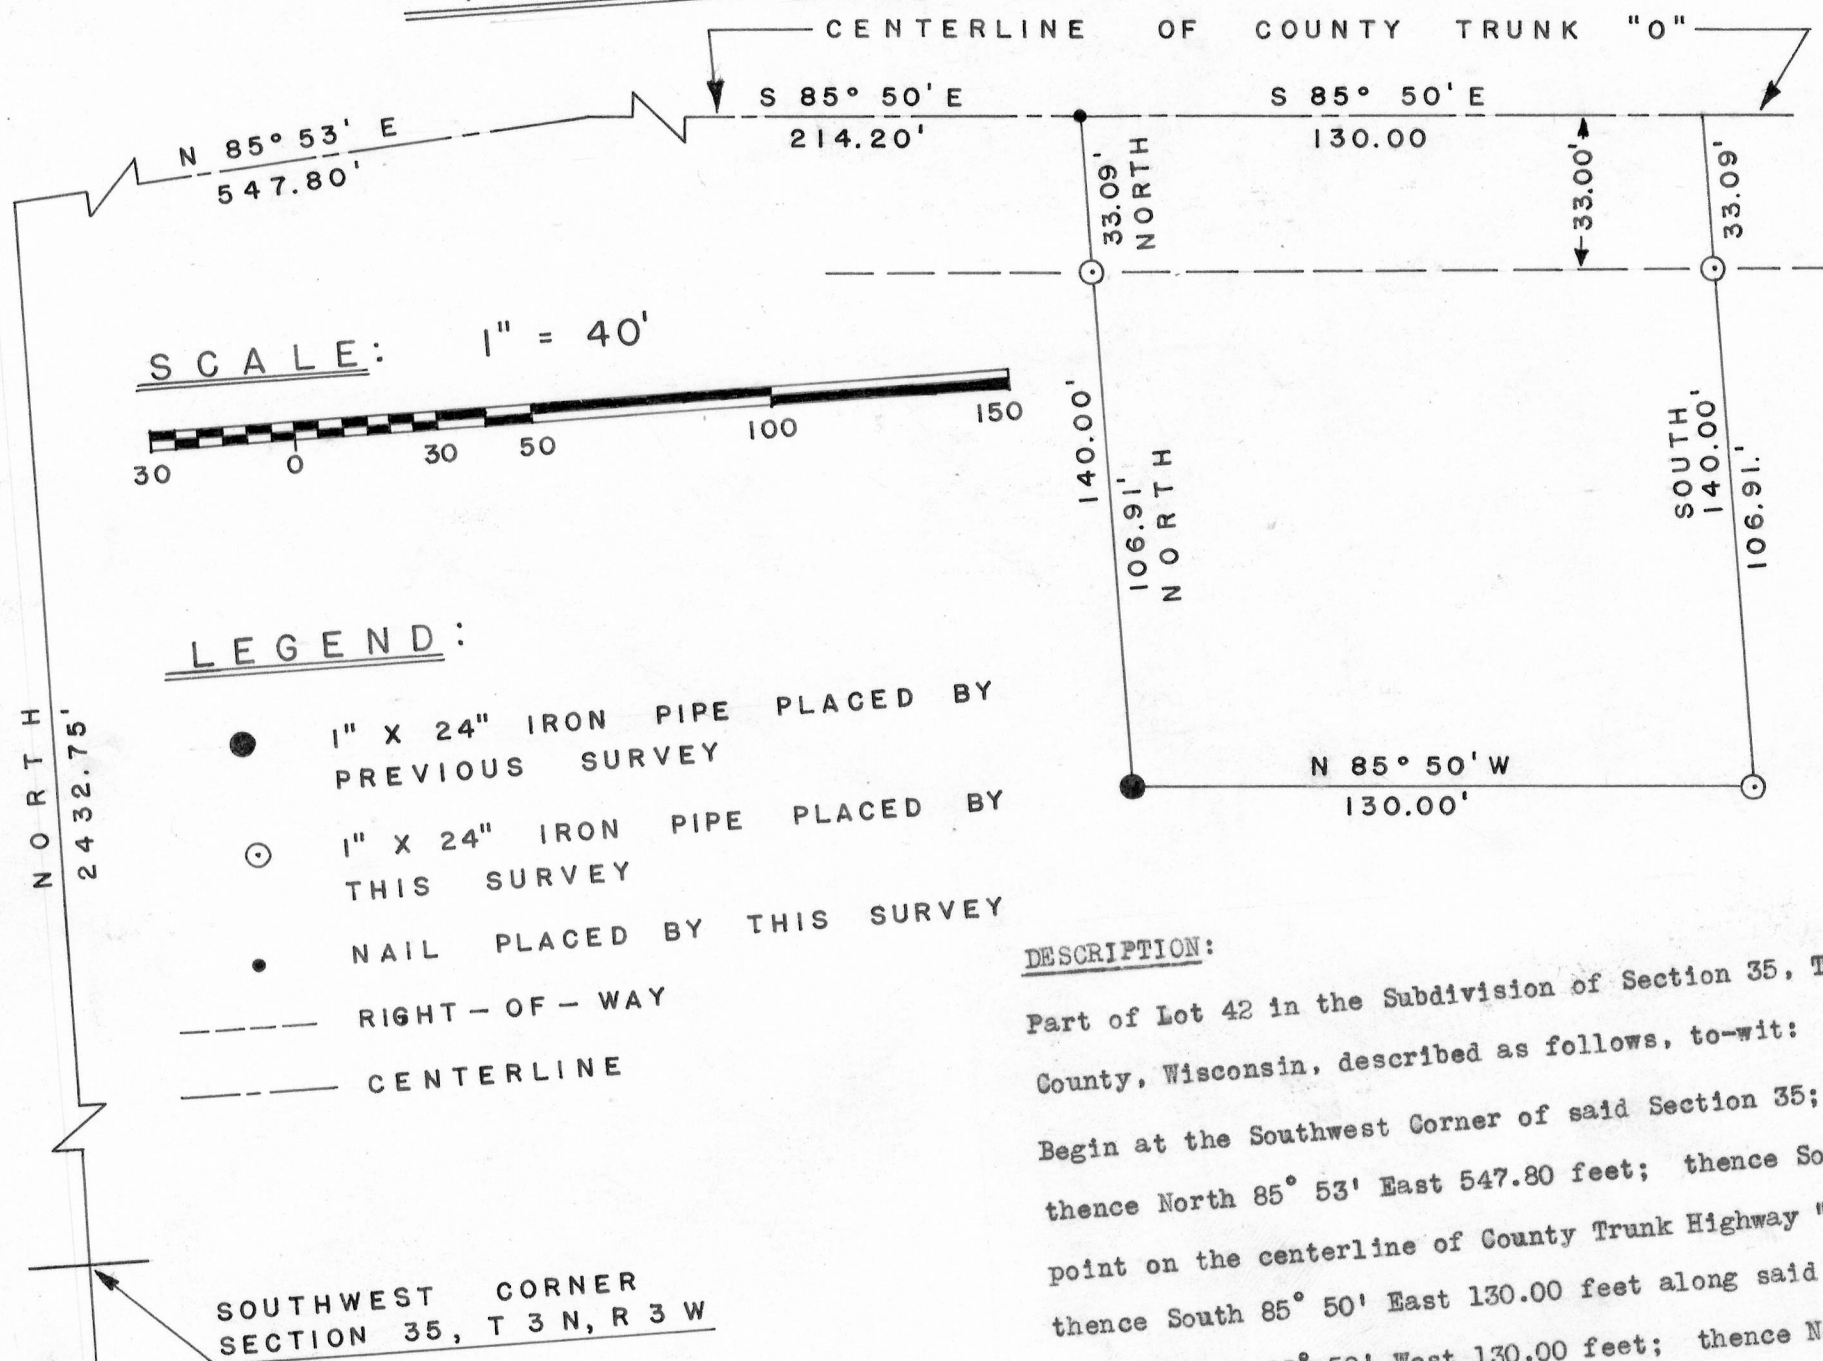

David K. Krohn
DAVID K. KROHN
4/29/74 - 5/2/74

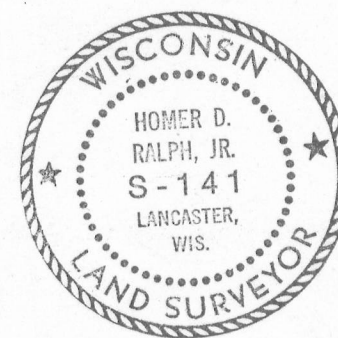

Homer D. Ralph, Jr.
HOMER D. RALPH, JR.
SURVEYOR FOR GRANT
COUNTY, WISCONSIN.