


LOEFFELHOLZ SURVEY

SCALE: 1" = 60'

N

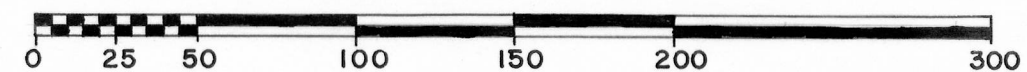


LEGEND:


- ⊙ 1" X 24" IRON PIPE PLACED BY THIS SURVEY
- *** FENCE

DESCRIPTION:

Part of Lot 8 of the Subdivision of Section 35, T 3 N, R 3 W, of the 4th P.M., Grant County, Wisconsin, described as follows to-wit: Begin at the Southwest corner of said Lot 8; thence East 532.30 feet to the point of beginning; thence North 08° 39' West 177.00 feet; thence North 39° 42' East 113.70 feet; thence South 83° 04' East 56.62 feet; thence South 37° 22' East 87.12 feet; thence North 87° 24' East 152.10 feet; thence South 17° 21' East 202.65 feet to the Southeast corner of said Lot 8; thence West 367.28 feet to the point of beginning. Containing 1.71 acres more or less.

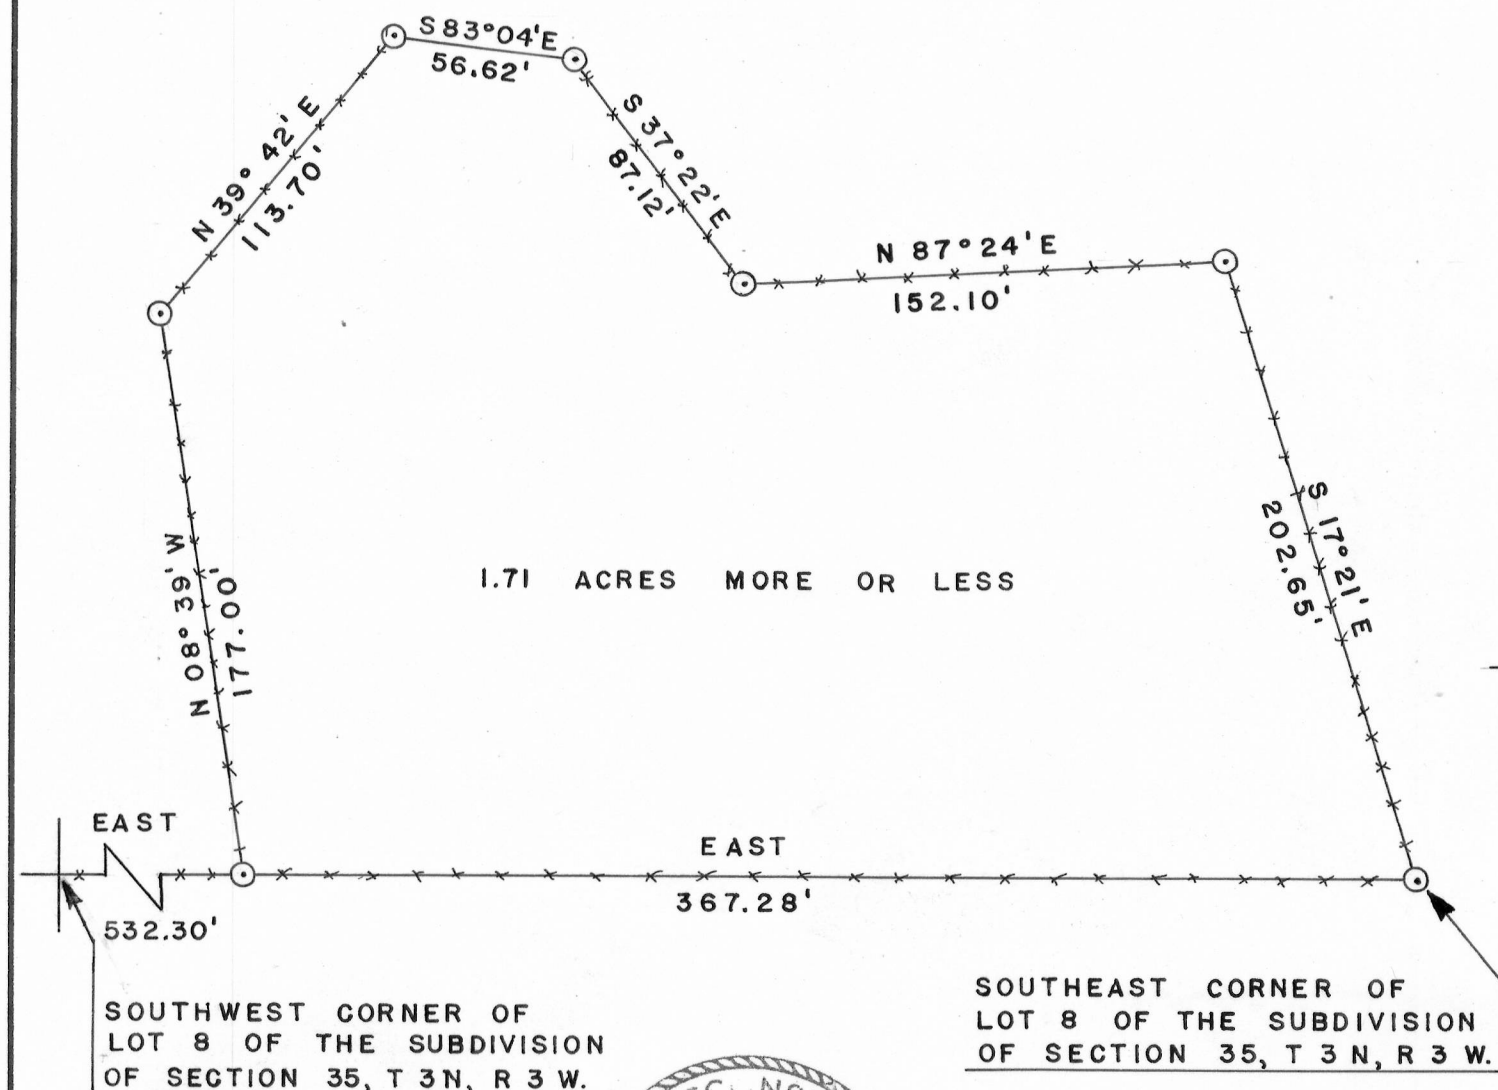

David K. Krohn
DAVID K. KROHN
6/11/74 - 6/14/74

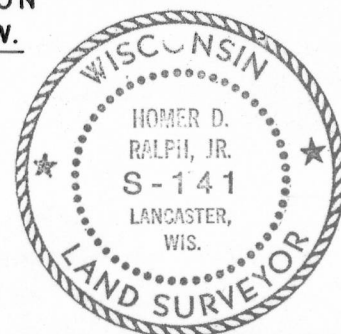

Homer D. Ralph, Jr.
HOMER D. RALPH, JR.
SURVEYOR FOR GRANT
COUNTY, WISCONSIN.