


WAYNE DROESSLER SURVEY

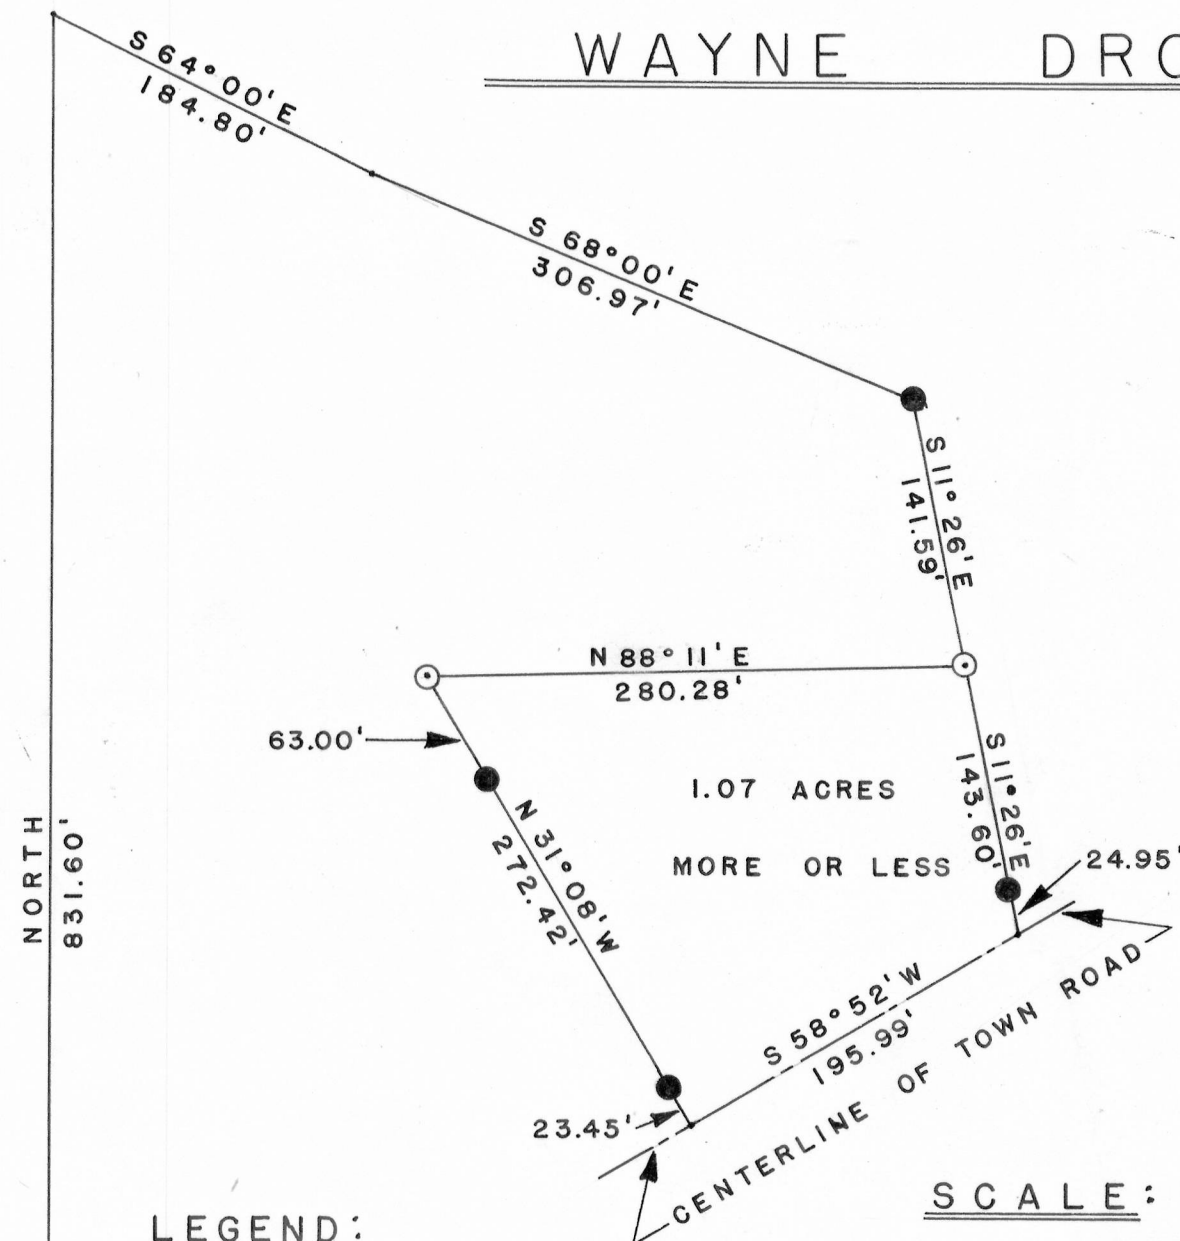

DESCRIPTION:

Part of the S.W.1/4 of the S.W.1/4 of Section 35, T 3 N, R 3 W, of the 4th P.M., Grant County, Wisconsin, described as follows, to-wit:

Commence at the Southwest Corner of said Section 35;

thence North 831.60 feet;

thence South 64° 00' East 184.80 feet;

thence South 68° 00' East 306.97 feet;

thence South 11° 26' East 141.59 feet to the point of beginning;

thence South 11° 26' East 143.60 feet to the centerline of town road;

thence South 58° 52' West 195.99 feet along said centerline of town road;

thence North 31° 08' West 272.42 feet;

thence North 88° 11' East 280.28 feet to the point of beginning, being a part of Lot 50 of said Section 35, T 3 N, R 3 W.

Containing 1.07 acres more or less inclusive of right-of-way.

LEGEND:

- ⊙ 1" X 24" IRON PIPE PLACED BY THIS SURVEY
- 1" X 24" IRON PIPE PLACED BY A PREVIOUS SURVEY

SOUTHWEST CORNER
SEC. 35, T 3 N, R 3 W.

David F. Krohn
DAVID K. KROHN
3/16/74 - 3/18/74

Homer D. Ralph, Jr.
HOMER D. RALPH, JR.
SURVEYOR FOR GRANT
COUNTY, WISCONSIN.

