


GRANT COMMUNITY CLINIC SURVEY

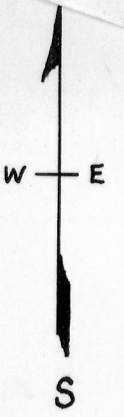


Elm Street

Street


Street

Madison

Monroe

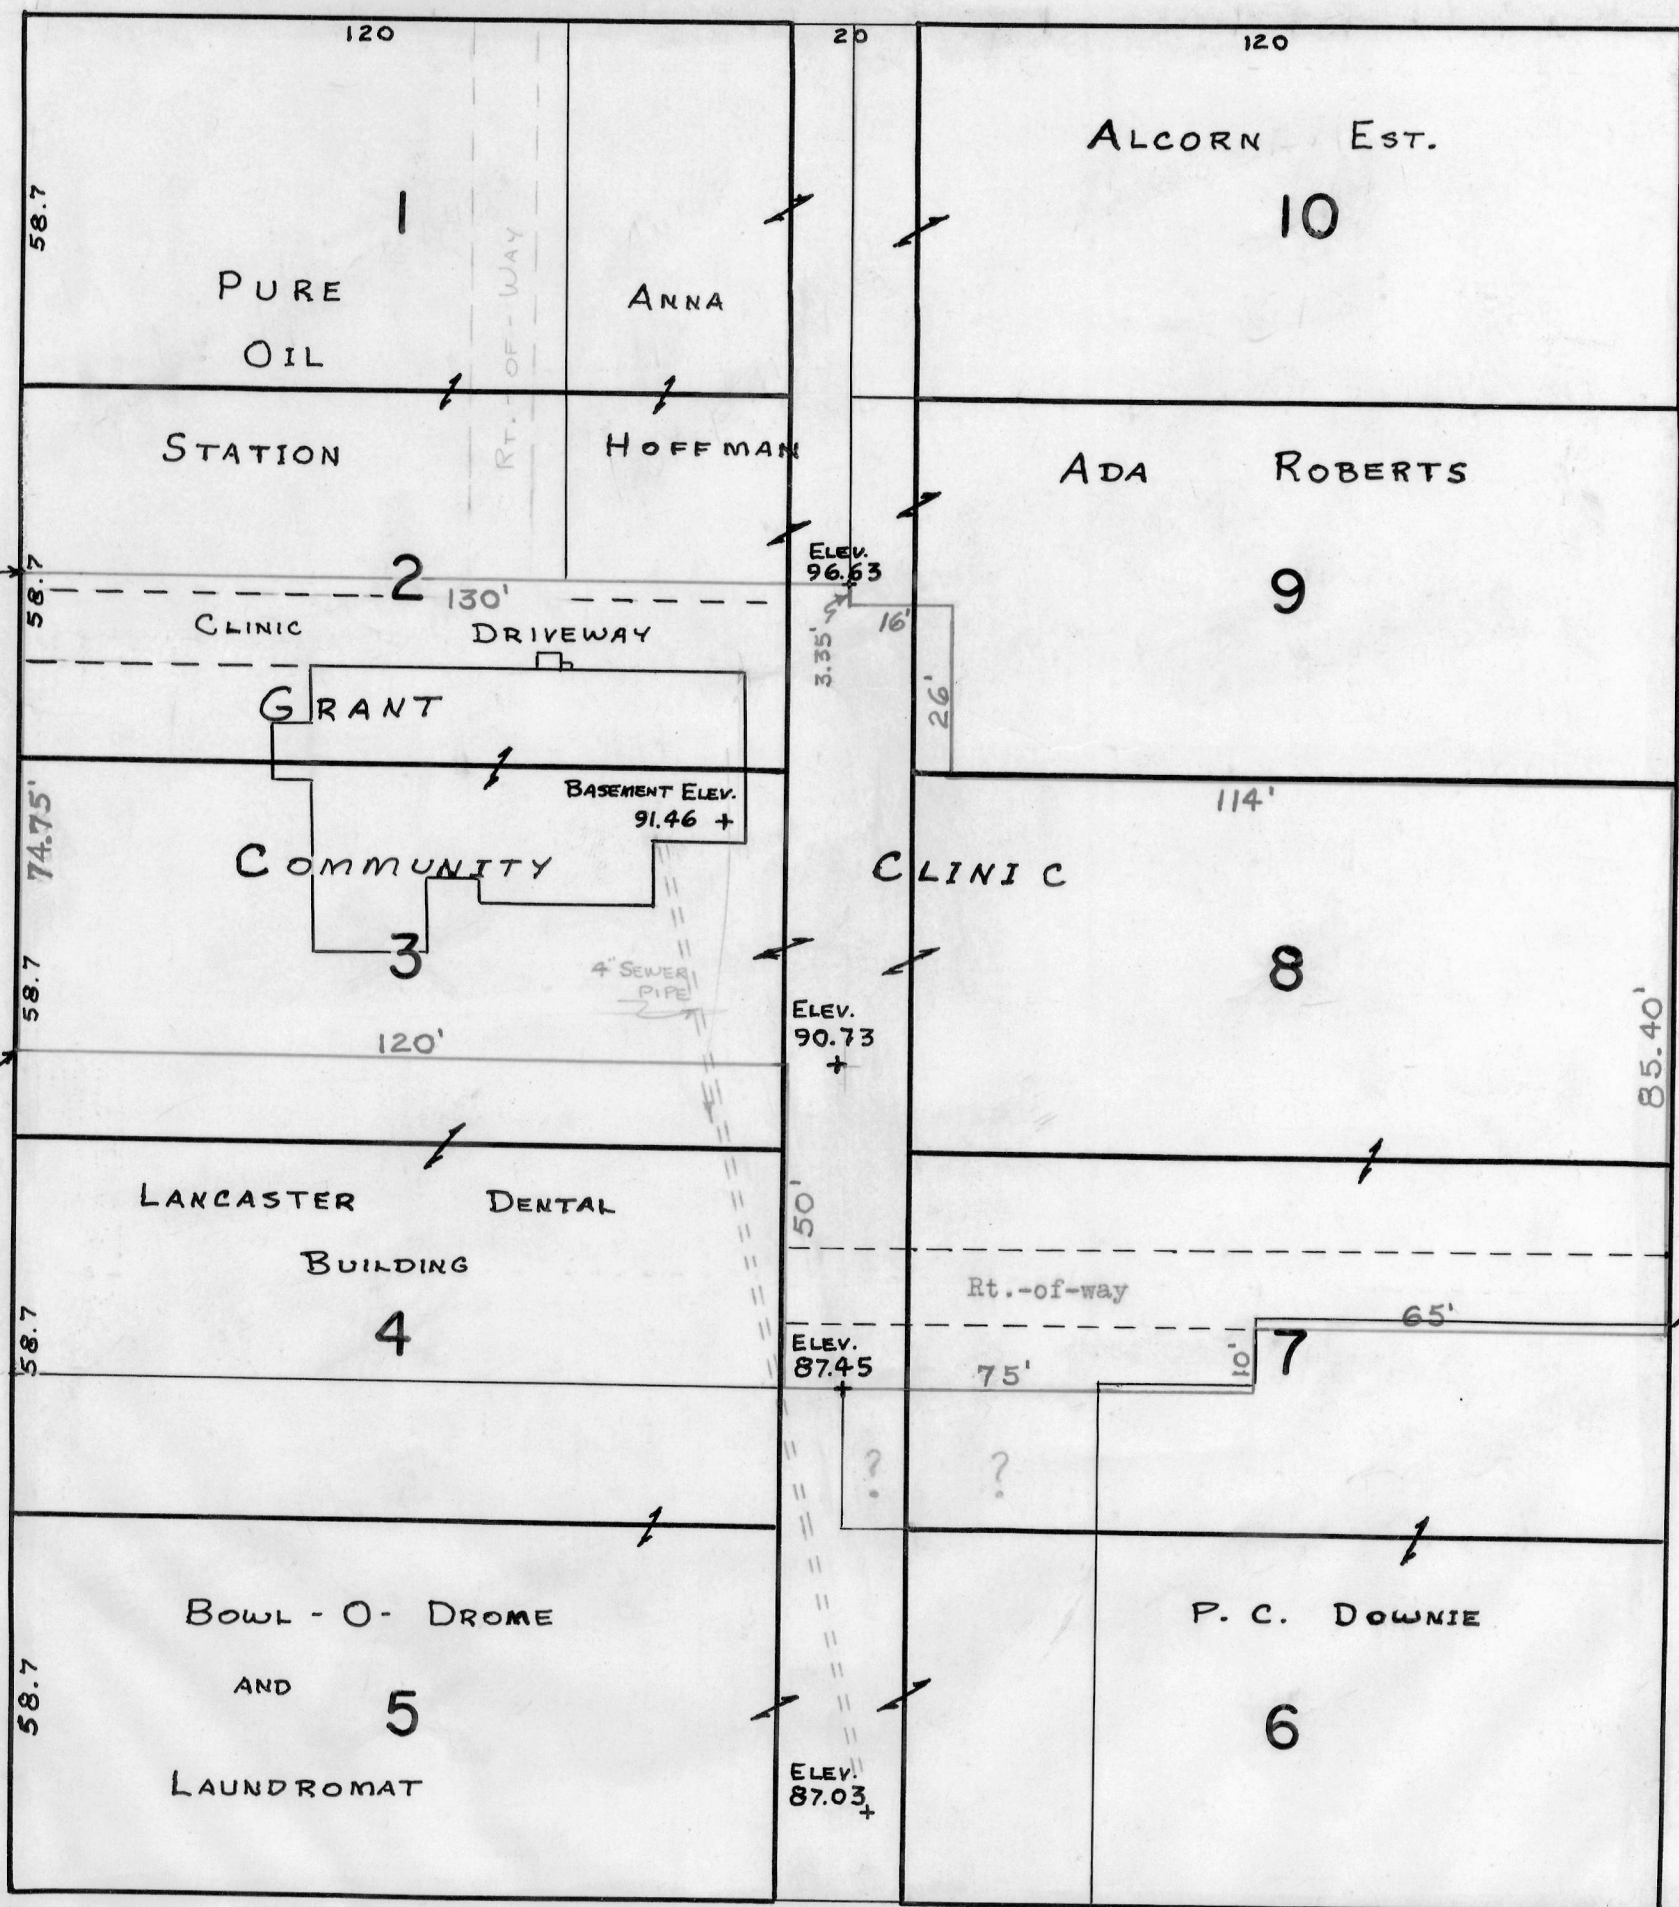

BLOCK 5, ORIGINAL PLAT, LANCASTER

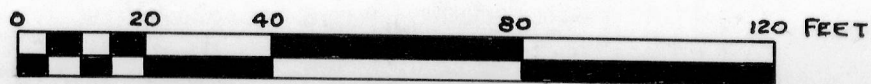

SCALE