
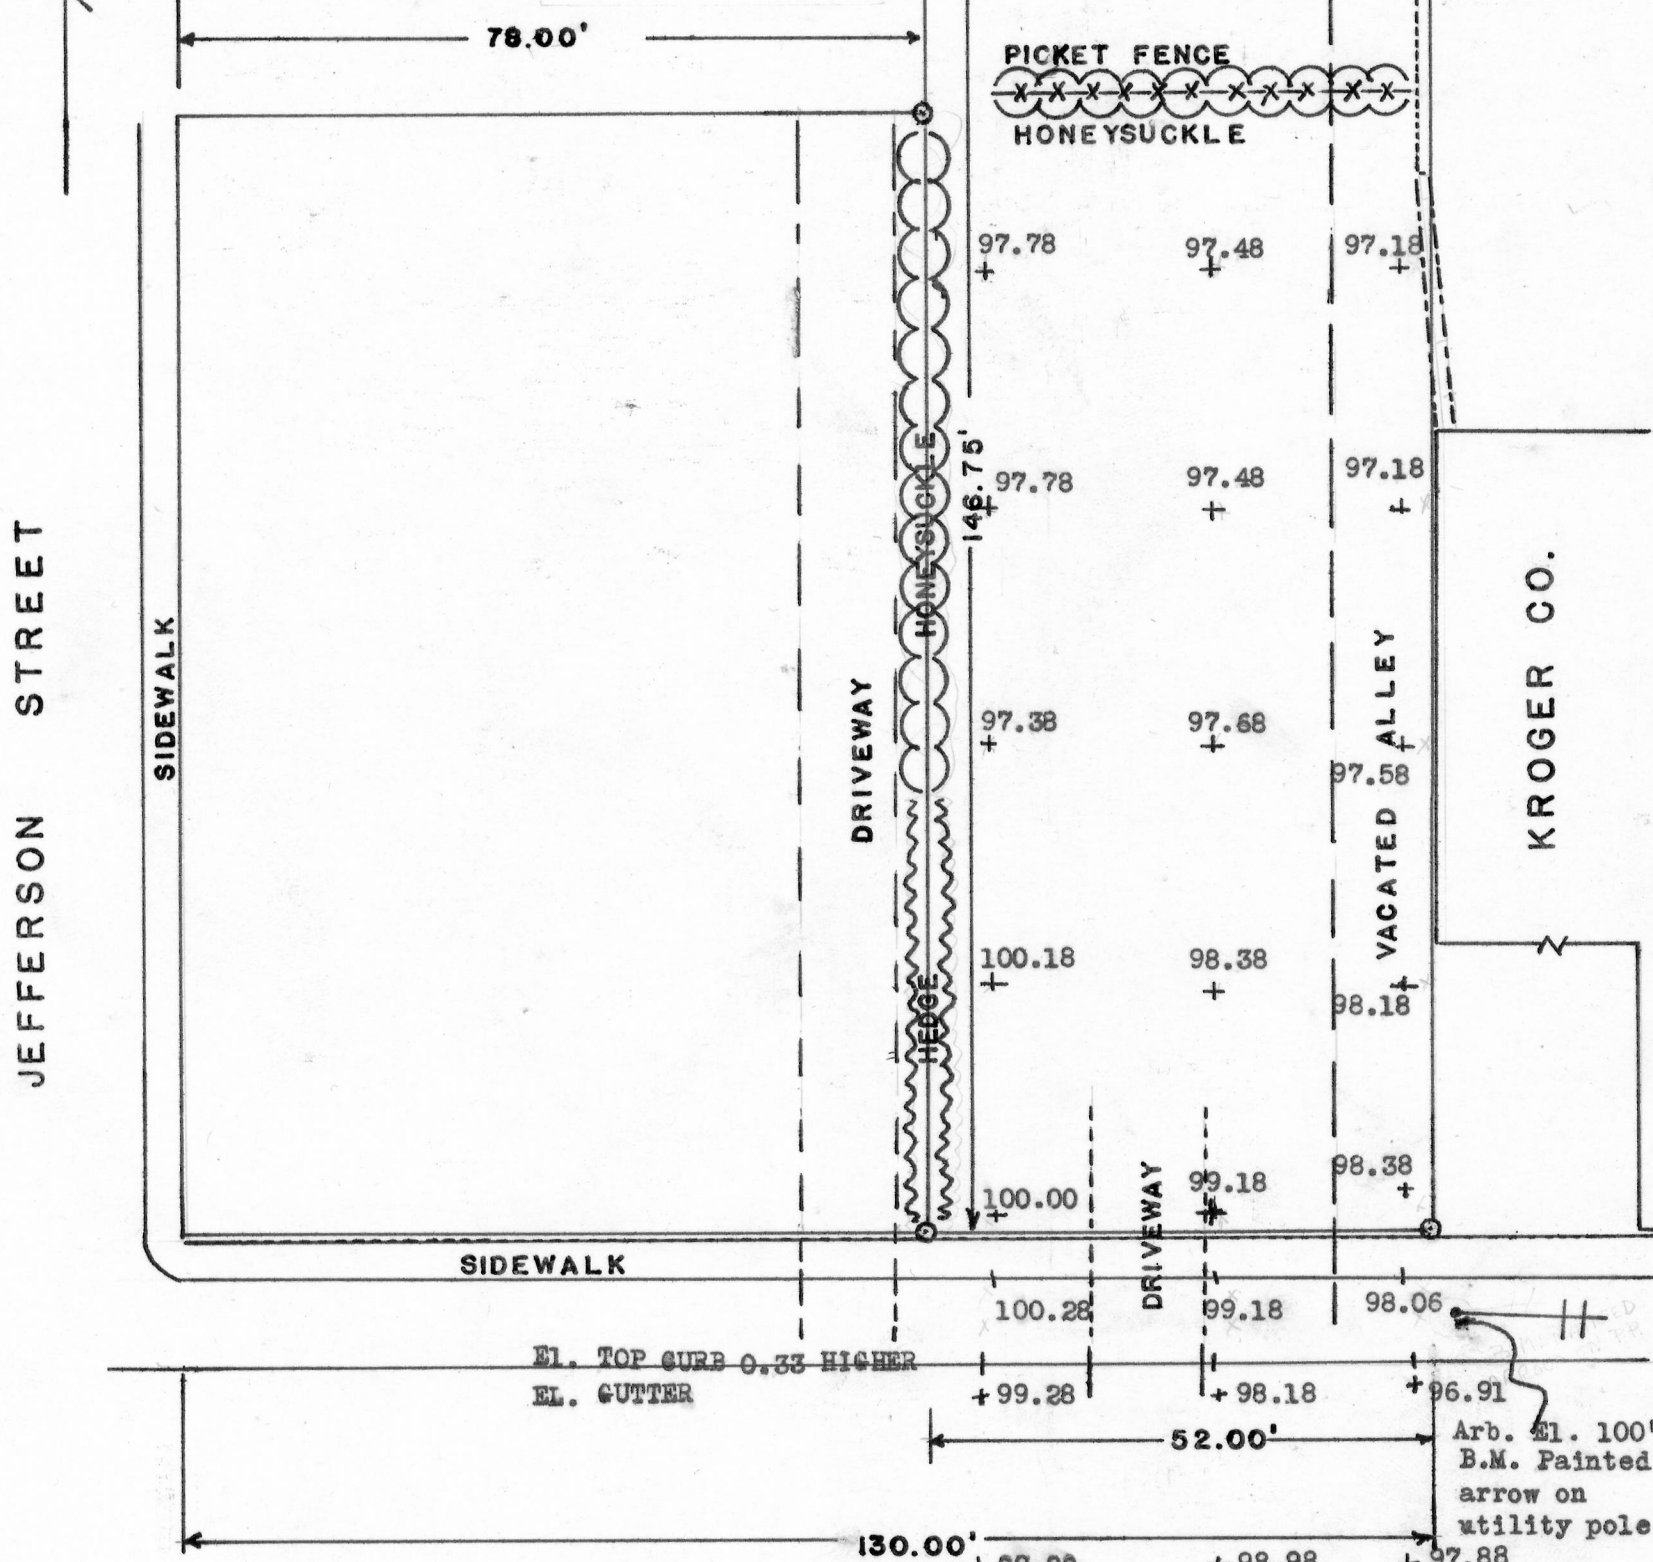


UNION STATE BANK SURVEY

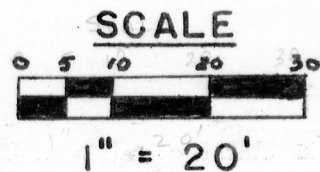

LEGEND:

- ⊙ 1" X 24" IRON PIPE PLACED BY THIS SURVEY
- IRON PIPE PLACED BY PREVIOUS SURVEY
- CONCRETE WALL 0.7' WIDE
- STONE WALL

DESCRIPTION: East 42 feet of Lots 4 and 5 and East 42 feet of the South 1/2 of Lot 3, Block 6 of the Original Plat of the Village (now City) of Lancaster, Grant County, Wisconsin according to the recorded map or plat thereof; Also the West 10 feet of the vacated alley contiguous thereto.

Frank Holmes
Frank Holmes
7/1/71-7/4/71

Homer D. Ralph, Jr.
Homer D. Ralph, Jr.
Surveyor for Grant
County, Wisconsin

