



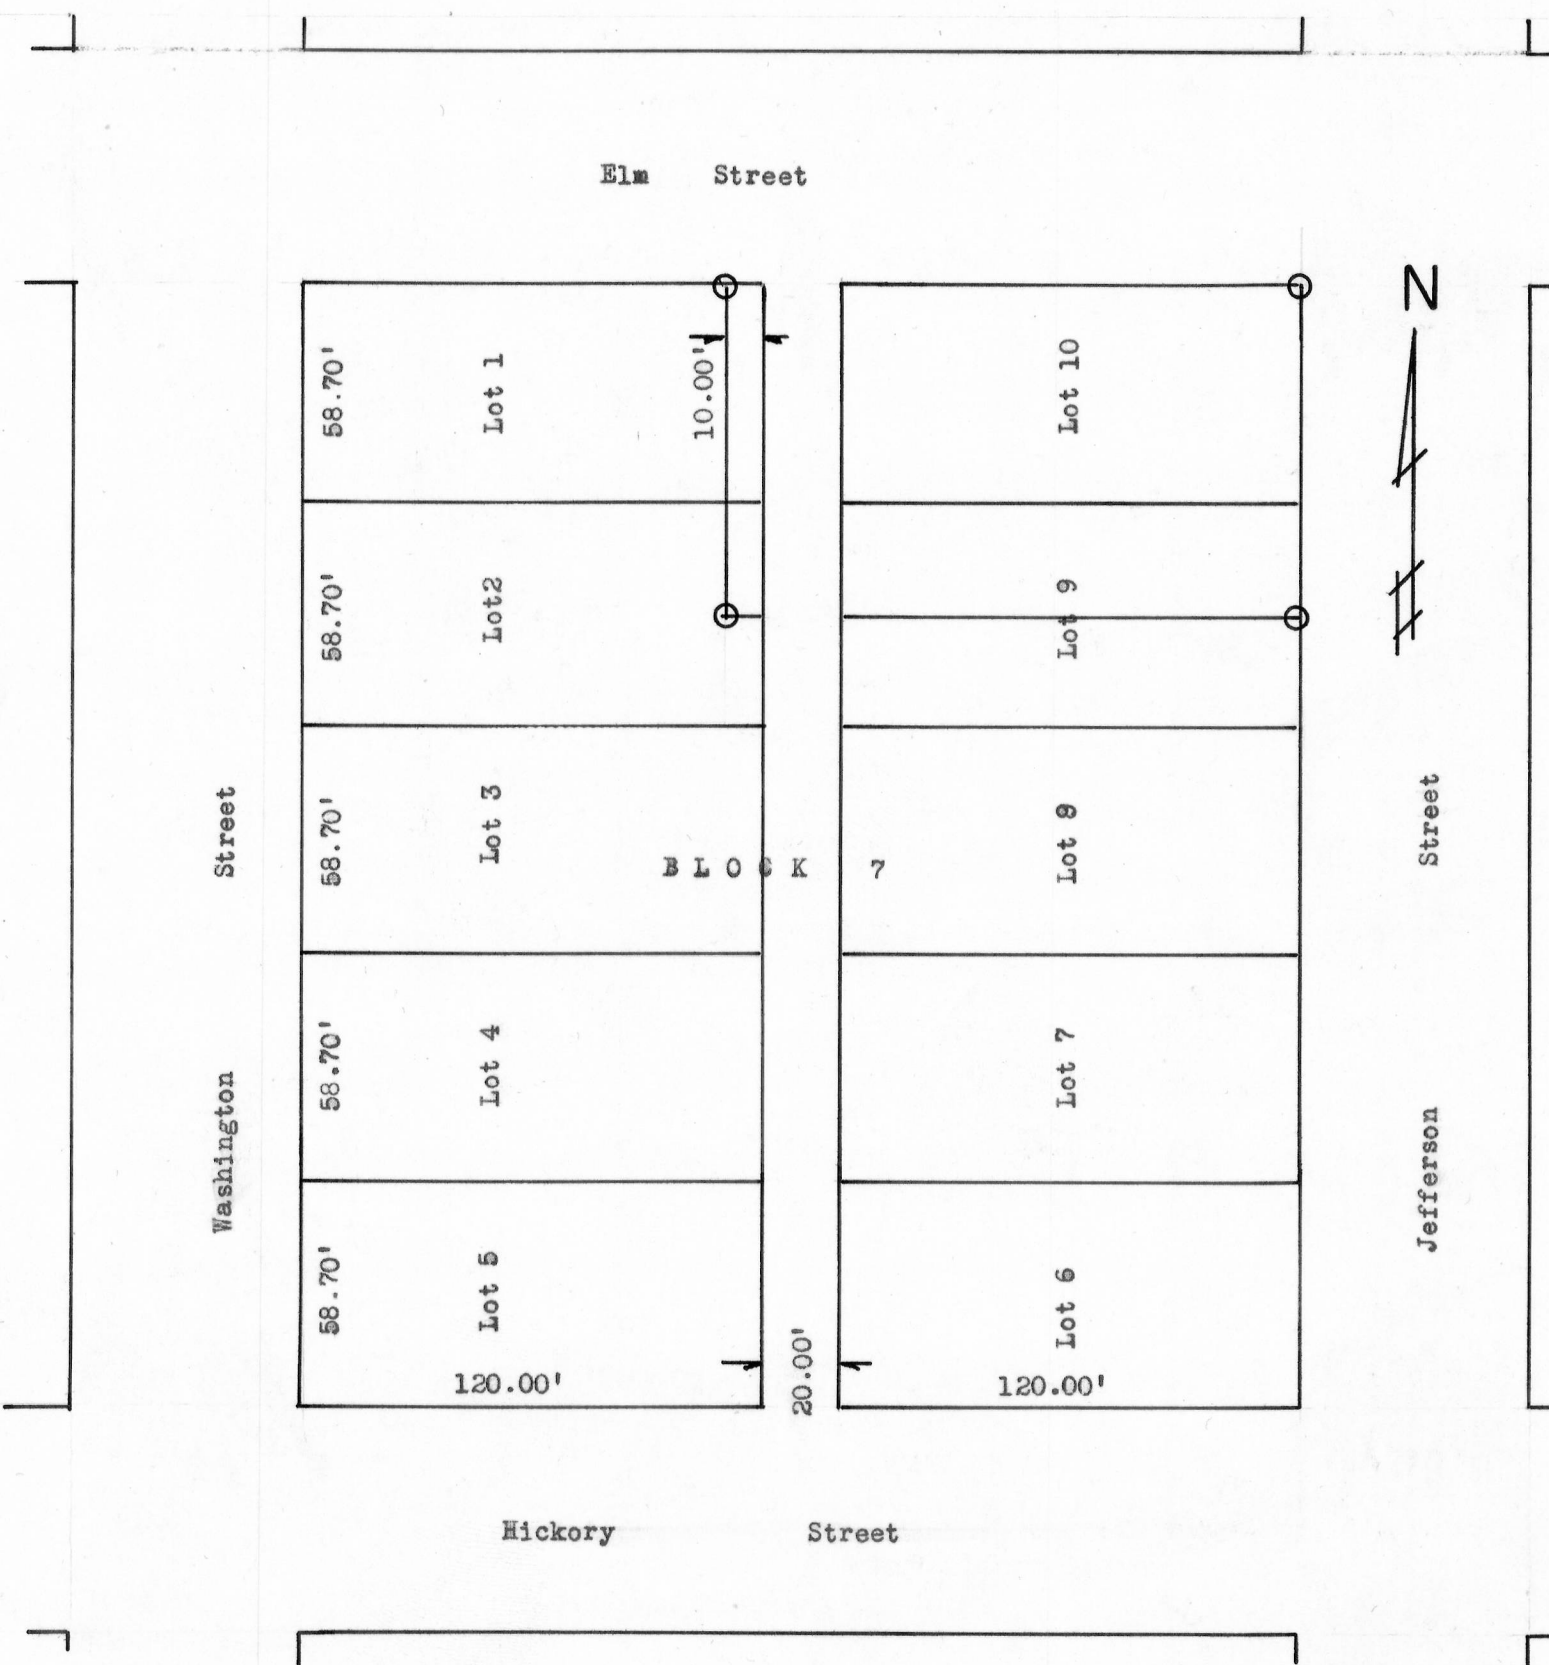

FARLEY SURVEY

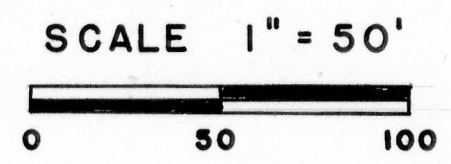

Description:

Lot 10 and the North 1/2 of Lot 9, and the East 10.00' feet of Lot 1 and the East 10.00 feet of North 1/2 of Lot 2, Block 7 of the Original Plat of the City of Lancaster, Grant County, Wisconsin.

Legend:

- 1"x24" iron pipe
- All streets shown have width's of 60.00'



Art Seymour
Art Seymour 11/6/69-
11/10/69

Homer D. Ralph, Jr.
Homer D. Ralph Jr.
Surveyor for Grant
County, Wisconsin.