


DOWNIE SURVEY


SCALE 1" = 50'

○ 1" x 24" PIPE PLACED BY FORMER SURVEY

▲ 1" ANGLE IRON PLACED BY THIS SURVEY

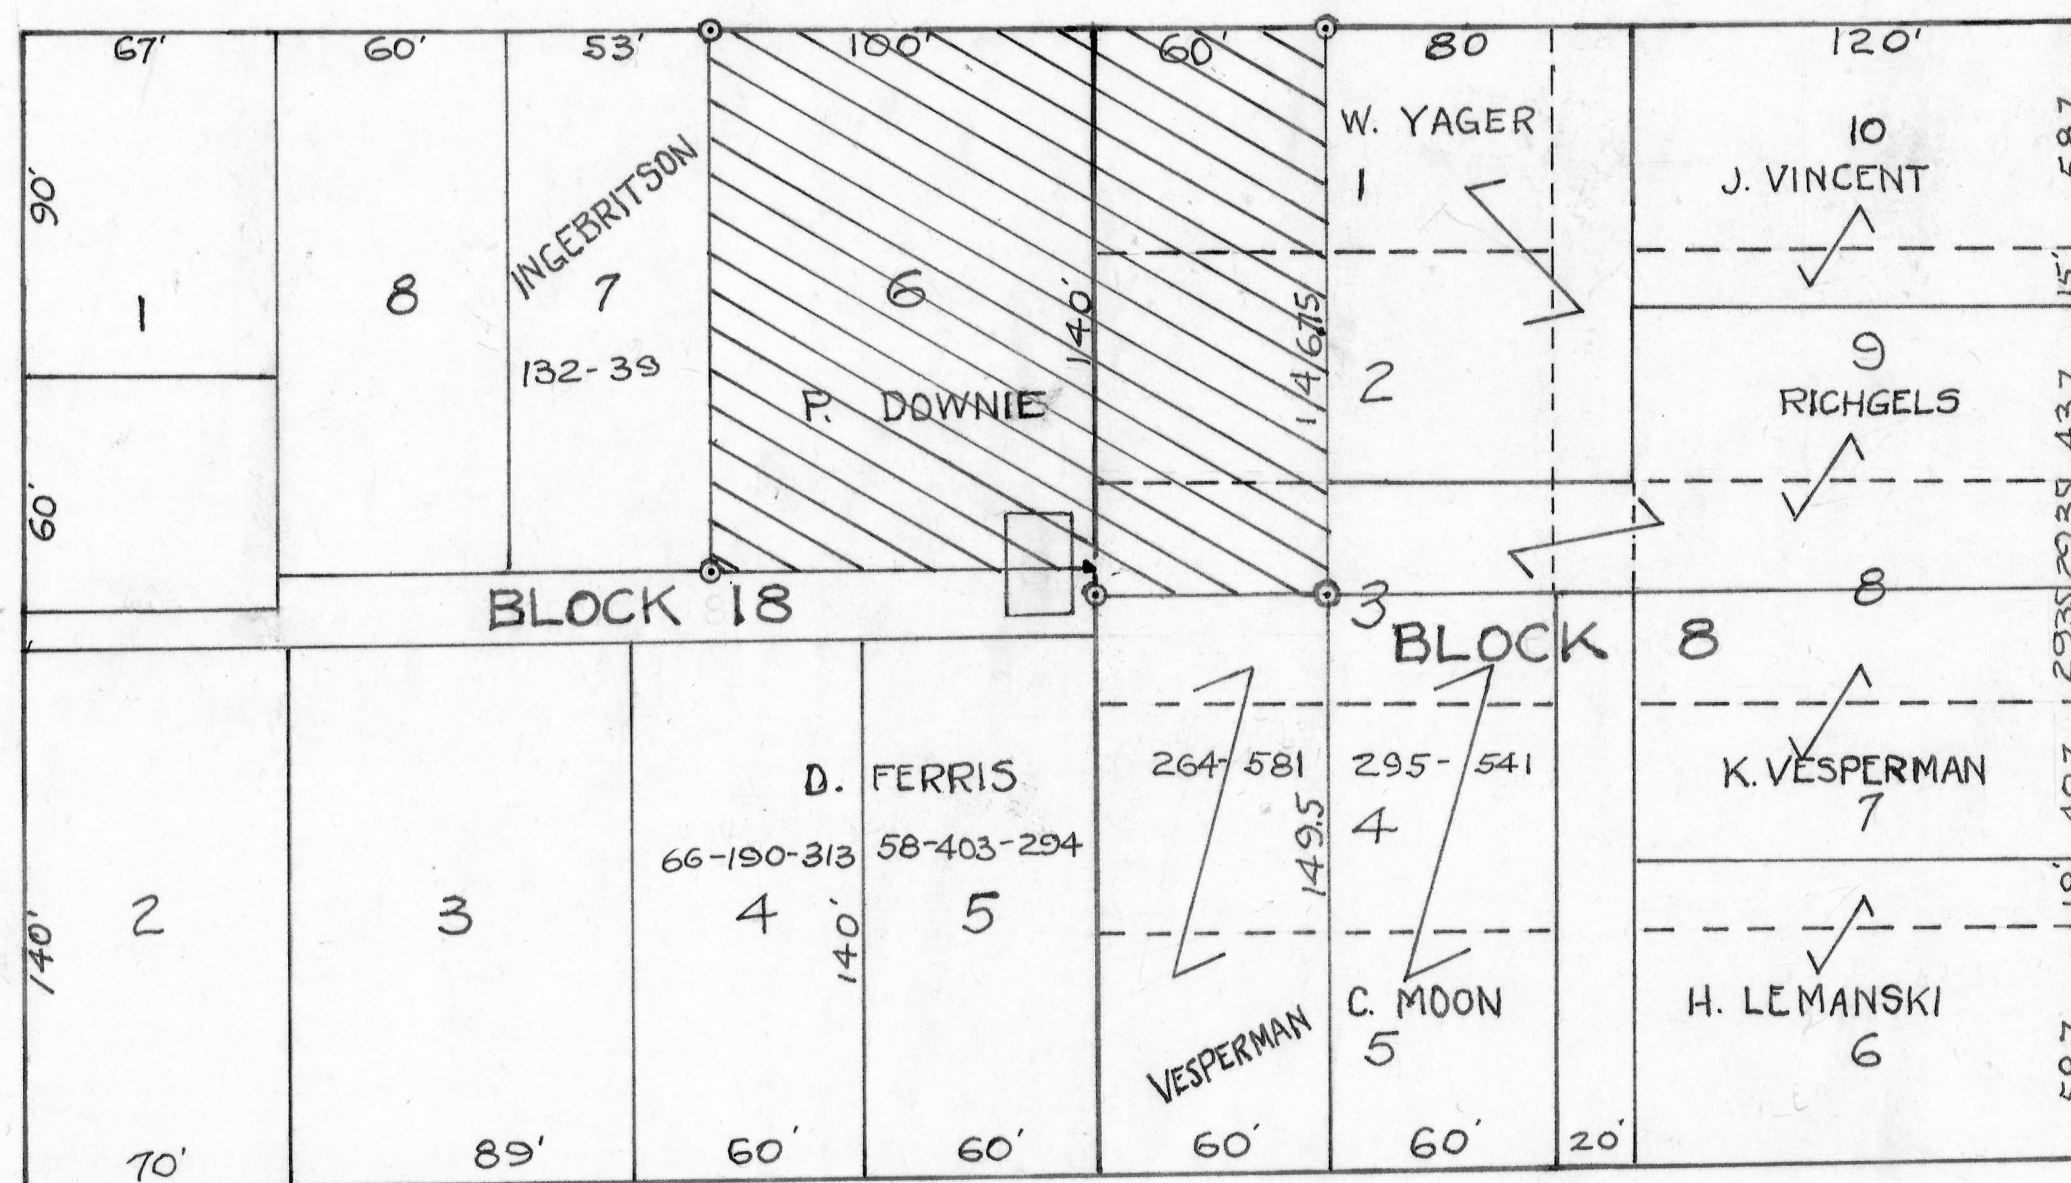

Frank Holmes  
Frank Holmes

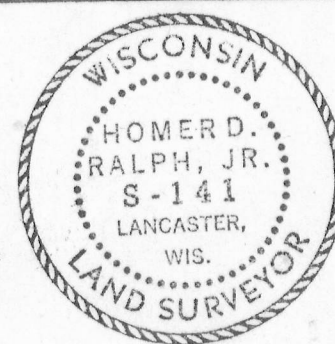

Homer D. Ralph, Jr.  
Homer D. Ralph, Jr.  
Surveyor For Grant Co., Wis.  
Wis. Reg. No. S-141