



# SURVEY FOR KUNSTER-HARTLINE

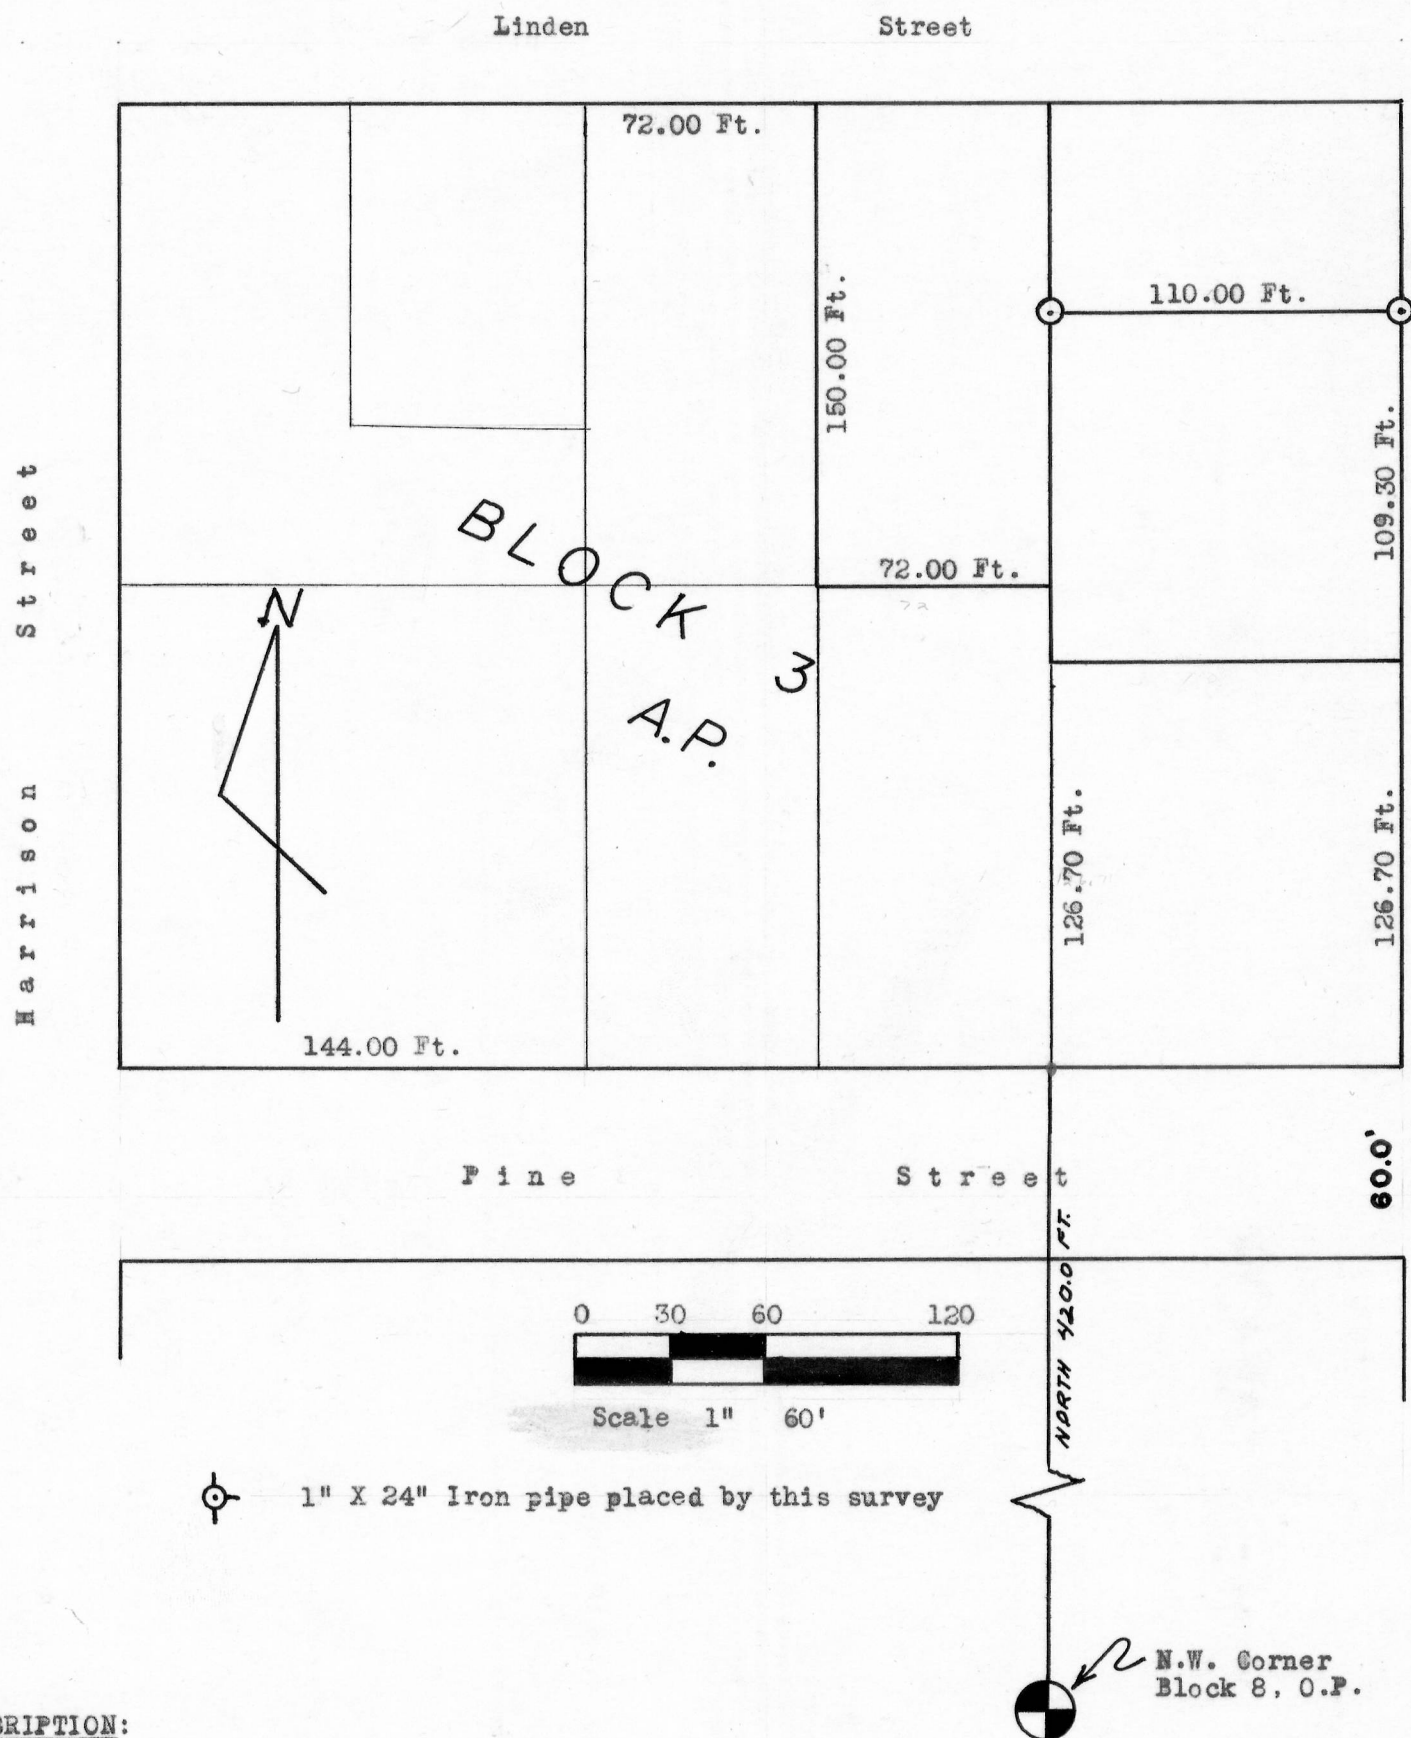

## DESCRIPTION:

Commencing at a point 546.70 feet North of the Northwest corner of Block 8 of the Original Plat of the Village (now city) of Lancaster, Grant County, Wisconsin, according to the recorded plat thereof, thence North 109.30 feet, thence East 110.00 feet.

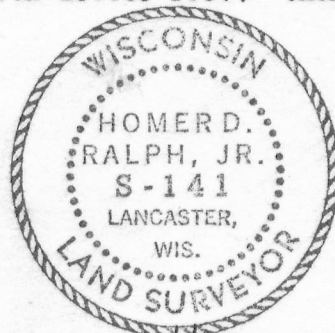

*Art Seymour*  
Art Seymour  
11/15/69 & 11/22/69

*Homer D. Ralph, Jr.*  
Homer D. Ralph, Jr.  
Surveyor for Grant County, Wis.