


TEBO SURVEY

SCALE 1" = 50'

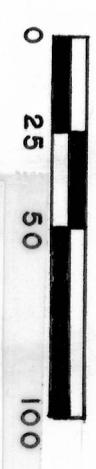


LEGEND

Ø 1"X24" IRON PIPE ESTABLISHED
ON THIS SURVEY


● 1"X24" IRON PIPE ESTABLISHED
BY PREVIOUS SURVEY

DESCRIPTION:

Commencing at a point 117.80 feet North and 180.00 feet West of the Southwest corner of Block 9 of the original plat of the City of Lancaster, Grant County, Wisconsin; thence West 90.0 feet more or less to the Eastern boundary of Harrison Street; thence North 62.20 feet; thence East 90.00 feet more or less; thence South 62.20 feet to the point of beginning. The above described lands are designated as part of Lot 4, Block 29 of the Assessment Plat of the City of Lancaster, Grant County, Wisconsin.

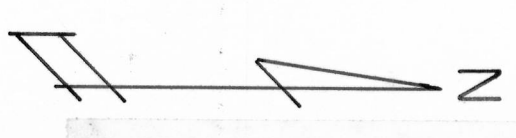

CENTER LINE OF HARRISON ST.

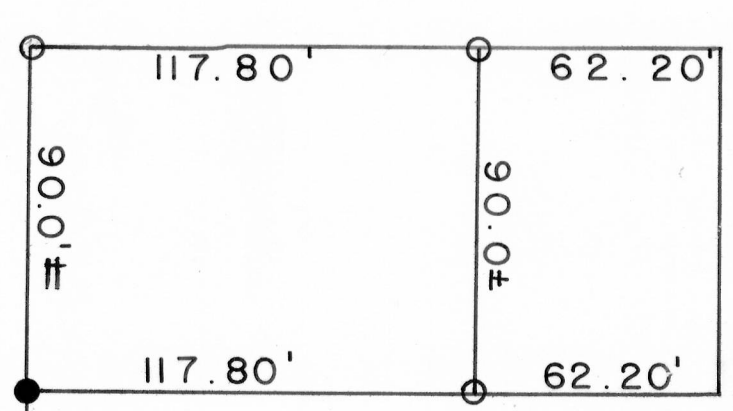

90.0'±

180.00'

CENTERLINE OF MAPLE ST.

S.W. CORNER
OF BLOCK 9
ORIGINAL PLAT

Art Seymour
Art Seymour
7/31/69



Homer D. Ralph Jr.
Homer D. Ralph Jr.
Surveyor for Grant
County, Wis.