


o 1" X 24" iron pipe placed by this survey.

John F. Elwell
John Elwell
5/30/73 - 6/12/73

Homer D. Ralph Jr.
Homer D. Ralph Jr.
Surveyor for Grant
County, Wisconsin.

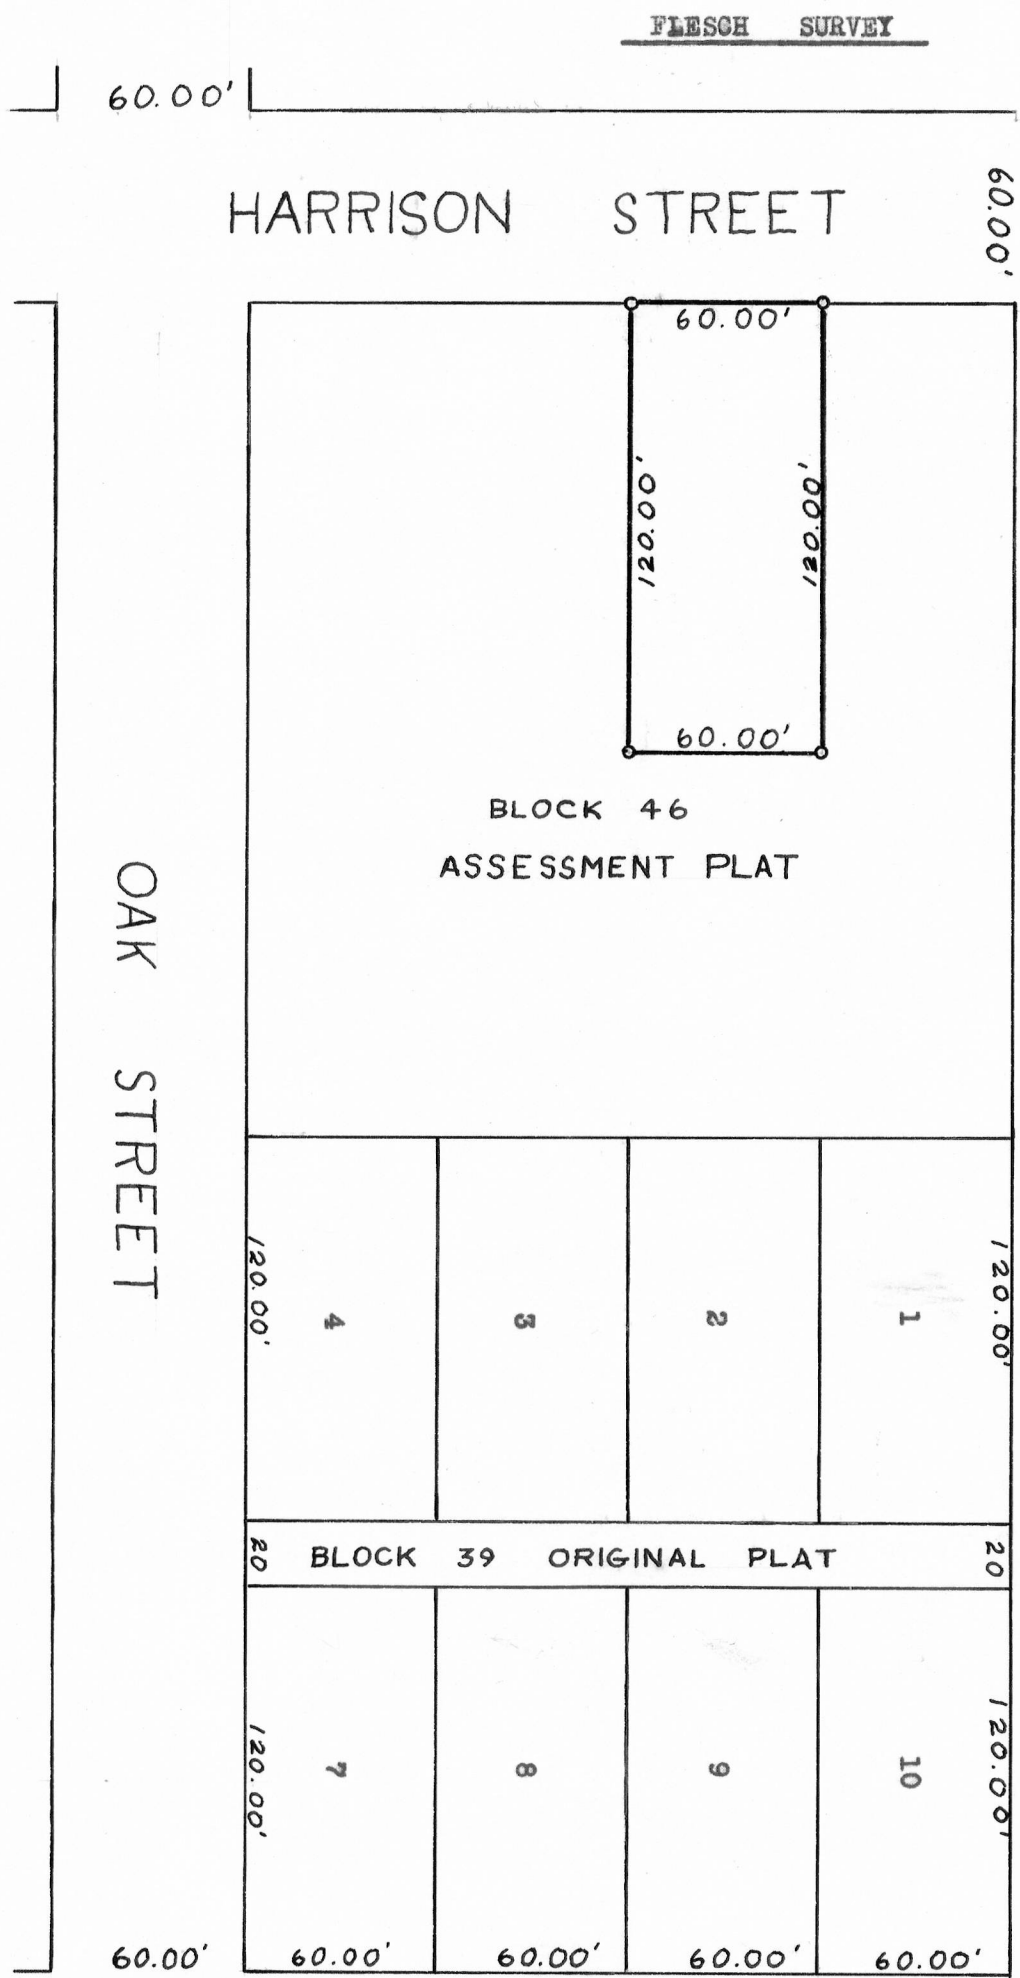

DESCRIPTION

Beginning 120.00 feet West and 60.00 feet South of the Northwest Corner of Lot 1 in Block 39 of the Original Plat of the City of Lancaster, Grant County, Wis., as per recorded map or plat thereof, running thence South 60.00 feet; thence West to the Eastern boundary line of Harrison Street; thence North 60.00 feet; thence East to the point of beginning. Also being described for assessment purposes as Lot 2, Block 46, of the Assessment Plat of the City of Lancaster, Grant County, Wisconsin.