



DOBSON SURVEY

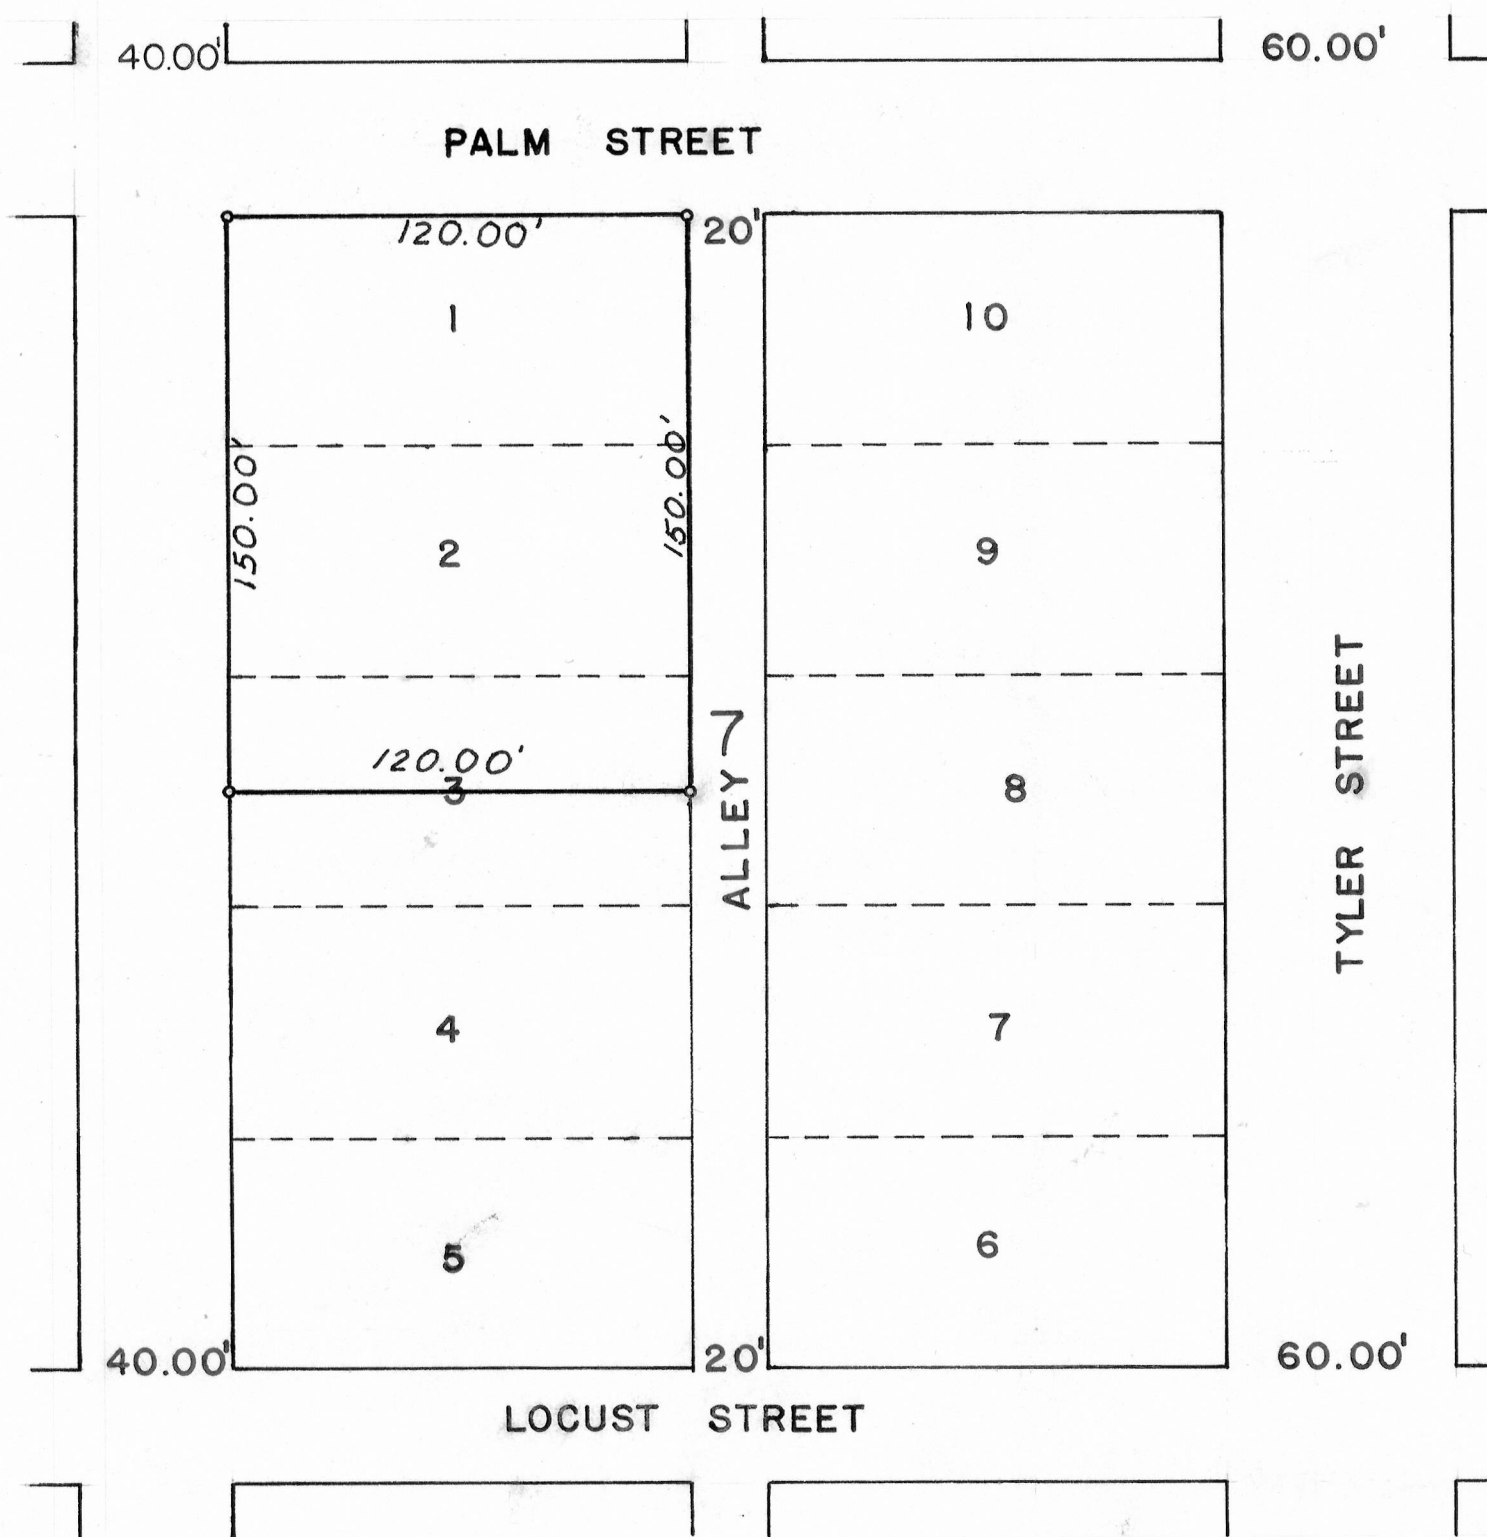

DESCRIPTION

The North 150.00 feet of the West 120.00 feet of Block 7 of Reeds Addition to City of Lancaster, Grant County, Wis. described as follows: Beginning at the Northwest corner of said Block 7 ; thence South 150.00 feet ; thence East 120.00 feet ; thence North 150.00 feet ; thence West 120.00 feet to point of beginning, containing all of lots 1 and 2 and the North 1/2 of lot 3 in said Block 7.

SCALE : 1" = 50'

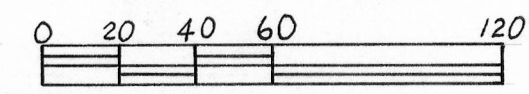

o 1" X 24" iron pipe placed by this survey.

John F. Elwell
John Elwell
5/30/73 - 6/12/73

Homer D. Ralph Jr.
Homer D. Ralph Jr.
Surveyor for Grant
County, Wisconsin.

WISCONSIN
HOMER D. RALPH, JR.
S-141
LANCASTER, WIS.
LAND SURVEYOR