



PEACOCK-VESPERMAN SURVEY

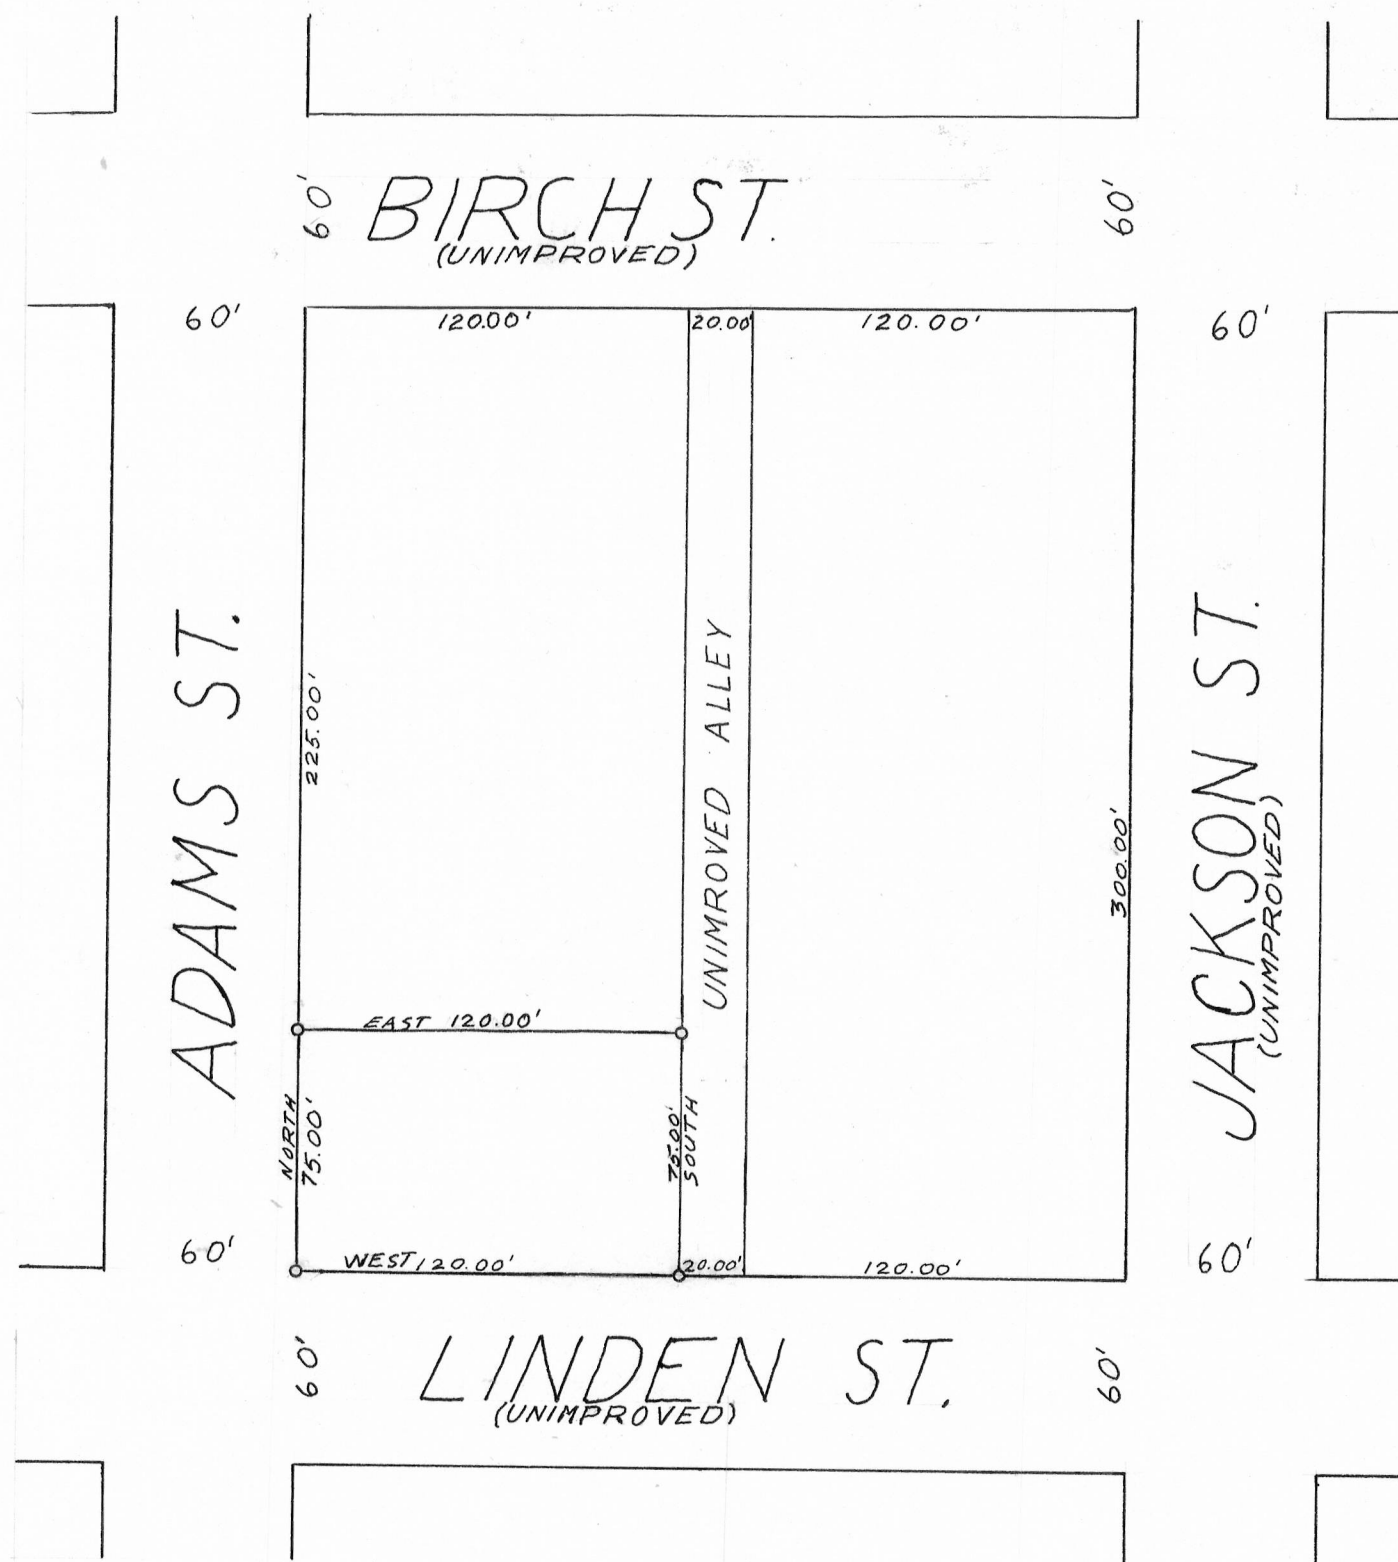

DESCRIPTION

The South 75.00 feet of the West 120.00 feet of Block 11 of Burt's Addition to City of Lancaster, Grant County, Wisc. described as follows: Beginning at the Southwest corner of said Block 11; thence North 75.00 feet; thence East 120.00 feet; thence South 75.00 feet; thence West 120.00 feet to the point of beginning.

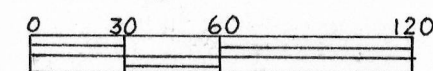

SCALE: 1" = 60'

o 1" X 24" iron pipe placed by this survey.

John F. Elwell
John Elwell
3/3/73 - 4/16/73

Homer D. Ralph Jr.
Homer D. Ralph Jr.
Surveyor for Grant
County, Wisconsin.

